F.E.D. ROAD DIST. NO.	STATE	FED. AID PROJ. NO.	FISCAL YEAR	SHEET NO.
9	VT		1936	15

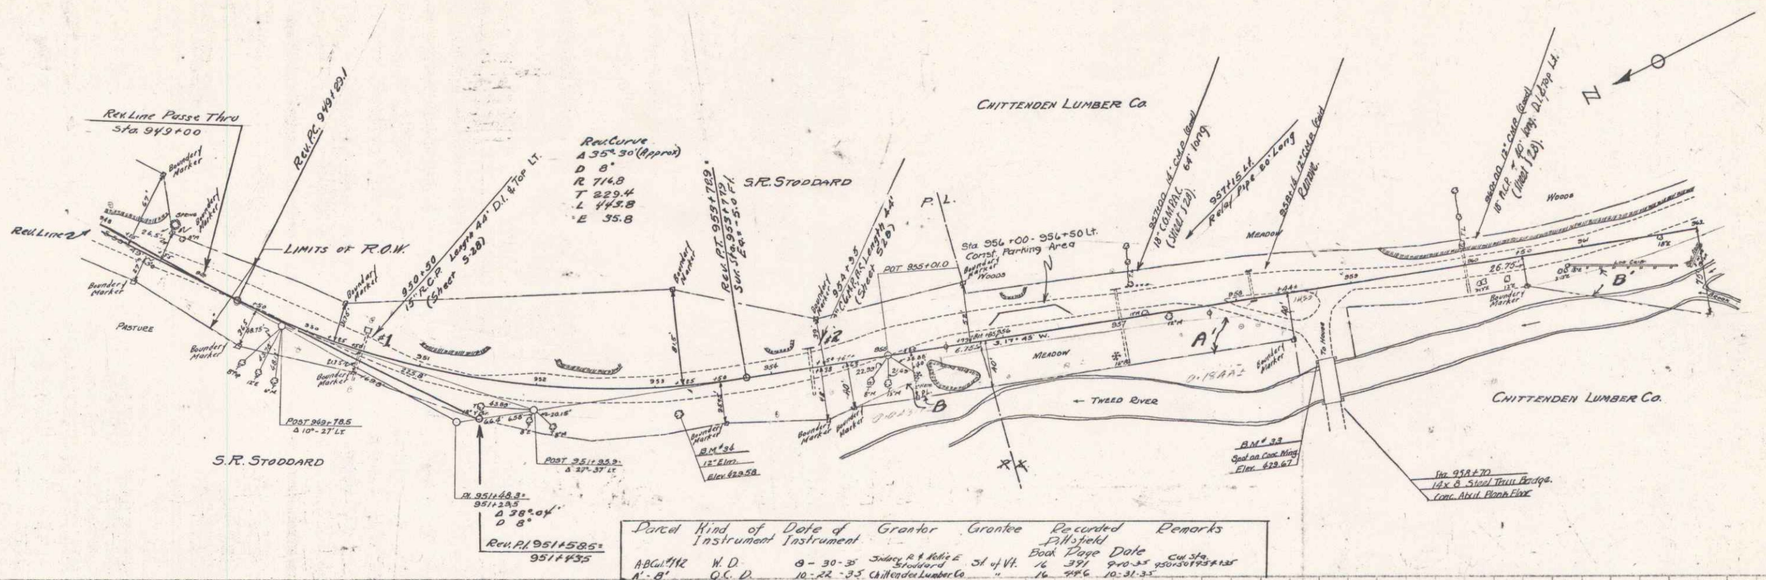

Parcel	Kind of Instrument	Date of Instrument	Grantor	Grantee	Recorded Pittsfield Book	Page	Date	Remarks
A.B.C. #112 A'-B'	W.D. Q.C.D.	8-30-35 10-22-35	Sidney R. & Helen E. Stoddard Chittenden Lumber Co.	St. of Vt. "	16 16	391 446	9-10-35 10-31-35	Cut Sta. 950+30 to 955+125

B.M. #34 SPIKE IN TRUNK OF 12" ELM 24 FT. RT. OF STA. 953+13 ELEV. 429.58
B.M. #33 SPOT ON CONC. ABUTMENT 62 FT. RT. OF STA. 958+60 ELEV. 429.67

13