Project: MM 2.0
DATE: 09/08/1929
TOWN: STOCKBRIDGE
ROUTE: VT100
PIN: 00R663

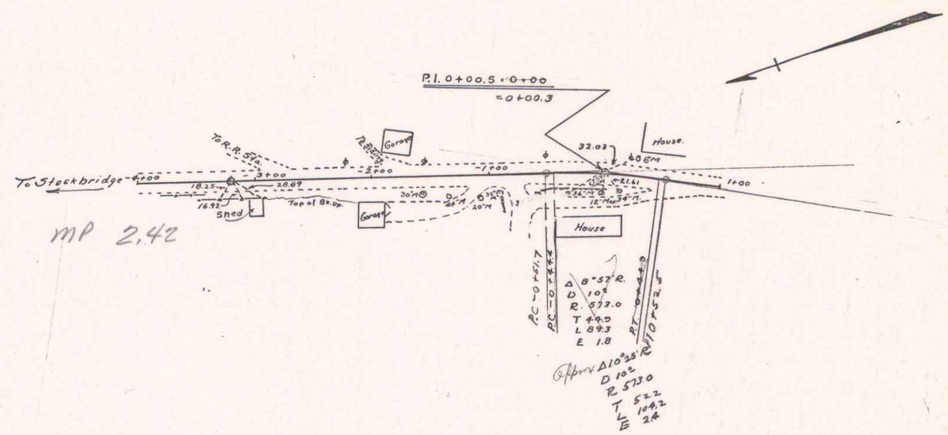

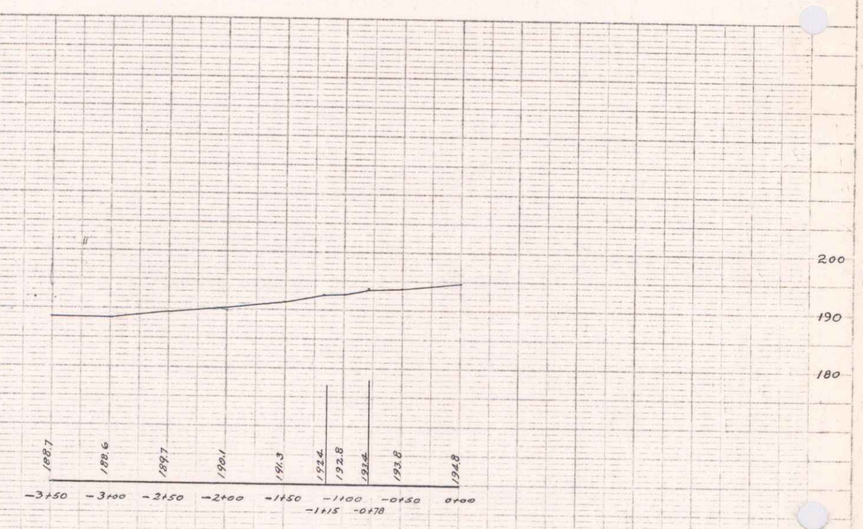

TOWN OF STOCKBRIDGE
Stockbridge-Pittsfield Road
Near Barrows Mill
Sheet 1 of