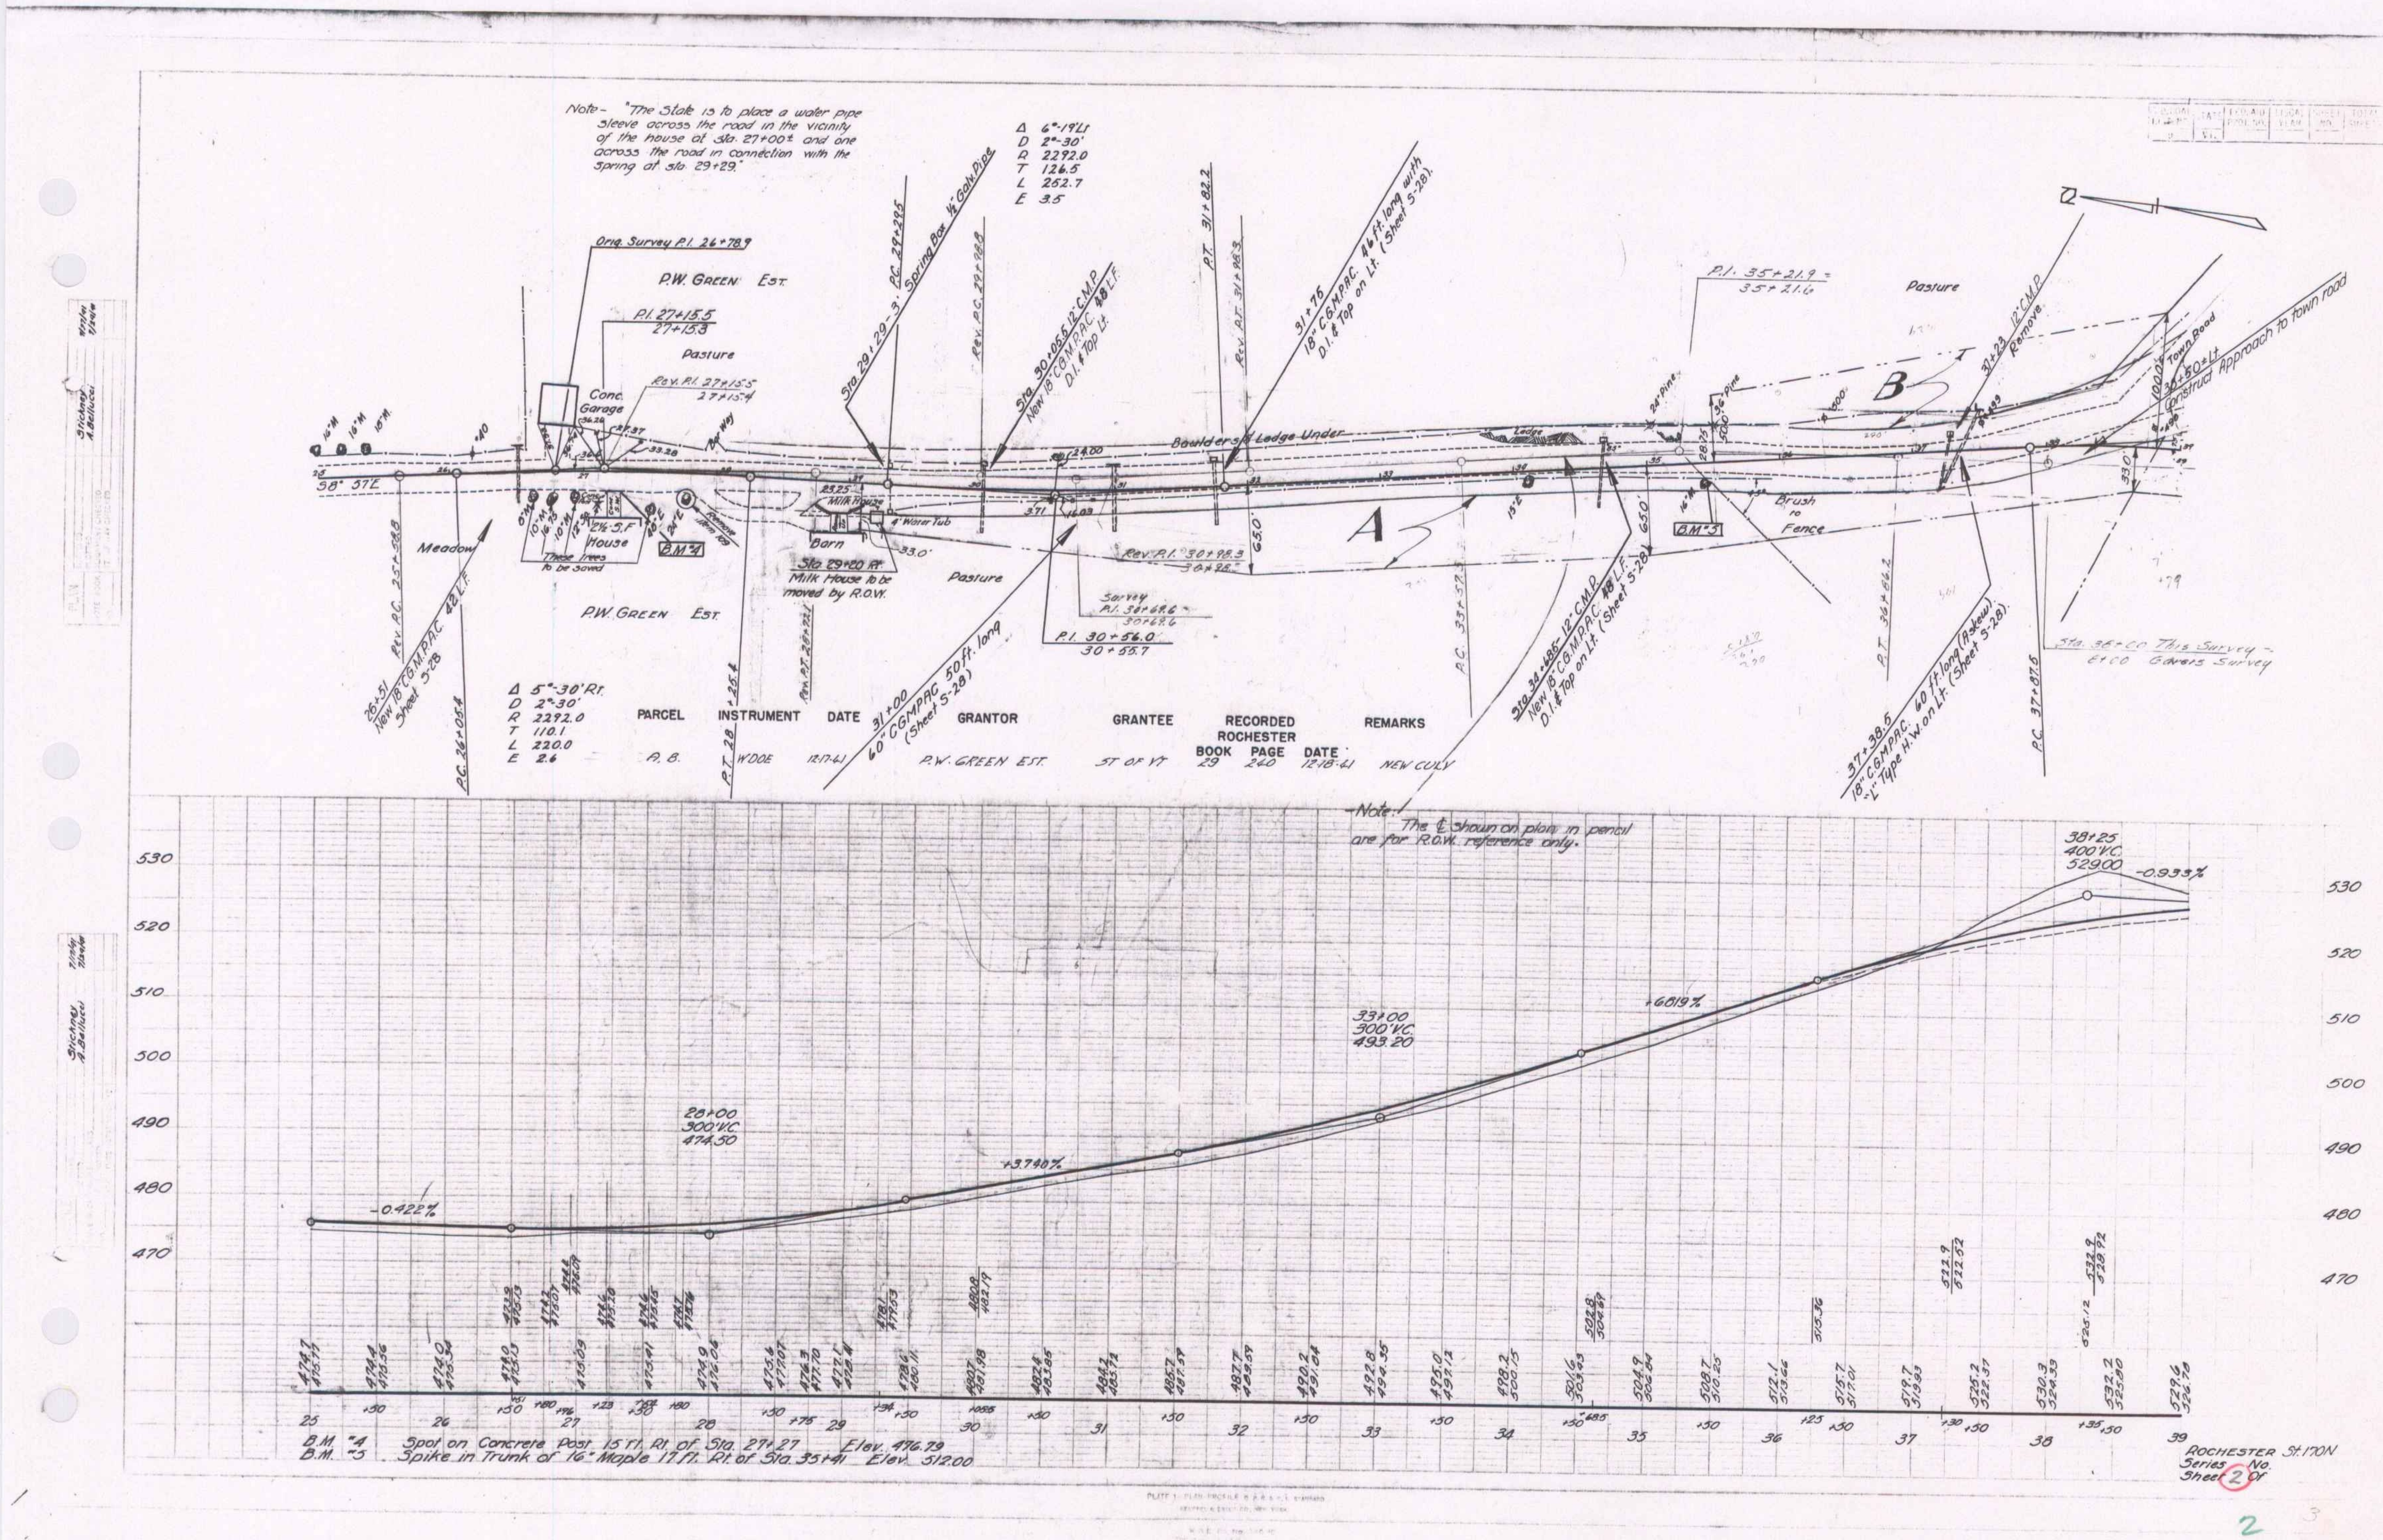
Note - "The State is to place a water pipe sleeve across the road in the vicinity of the house at Sta. 27+00± and one across the road in connection with the Spring at sta. 29+29."
Δ 6°-19' Lt
D 2°-30'
R 2292.0
T 126.5
L 252.7
E 3.5
Orig. Survey P.I. 26+78.9
P.W. GREEN EST.
P.I. 27+15.5
27+15.3
Pasture
Conc. Garage
Meadow
House
Three trees to be saved
Barn
Sta. 29+20 Rt.
Milk House to be moved by R.O.W.
Pasture
P.W. GREEN EST.
Boulders & Ledge Under
Pasture
Brush to Fence
Construct Approach to town road
Town Road
P.I. 35+21.9
35+21.6
P.I. 30+56.0
30+55.7
Rev. P.I. 30+98.3
Δ 5°-30' Rt.
D 2°-30'
R 2292.0
T 110.1
L 220.0
E 2.6
PARCEL
INSTRUMENT
DATE
GRANTOR
GRANTEE
RECORDED ROCHESTER
BOOK
PAGE
DATE
REMARKS
A. B.
W'DEE
12-17-41
P.W. GREEN EST.
ST. OF VT.
29
260
12-18-41
NEW CULV.
Note - The ℄ shown on plans in pencil are for R.O.W. reference only.
28+00
300' V.C.
474.30
-0.422%
+3.740%
33+00
300' V.C.
493.20
+6.819%
38+25
400' V.C.
529.00
-0.933%
B.M. #4 Spot on Concrete Post 15 ft. Rt. of Sta. 27+27 Elev. 476.29
B.M. #5 Spike in Trunk of 16" Maple 17 ft. Rt. of Sta. 35+41 Elev. 512.00
ROCHESTER STATION
Series No.
Sheet 2 of

2