

REV CURVE  
 A 13° 37' LT.  
 D 30'  
 R 1910.1'  
 T 228.0'  
 L 453.9'  
 E 13.6'  
 BANK 1/2" PER FOOT

WOOD GUIDE POSTS  
 LT RT  
 59+11-2 58+05-2  
 58+34-2

PLANK GUARD RAIL WITH PRESERVATIVE TREATMENT  
 LT RT  
 58+26-58+30 58+41-58+45  
 58+46-58+48 58+52-58+56  
 58+67-59+03 58+62-58+68


STEEL GUIDE POSTS AT 100' INTERVALS  
 RT  
 58+40-58+61 58+25-58+45  
 58+65-59+04 58+69-58+89

REMOVAL & DISPOSAL OF PRESENT GUARD RAIL  
 LT RT  
 58+40-58+61 58+25-58+45  
 58+65-59+04 58+69-58+89

7° 31' LT.  
 D 24'  
 R 2864.9'  
 T 188.2'  
 L 373.8'  
 E 6.2'  
 BANK 5/16" PER FOOT

PLAN  
 PALMER  
 WEBSTER - MARTIN INC. 11-58  
 NOTE: SEE SHEET 11-59 FOR CHANGES

PLAN  
 PALMER  
 WEBSTER - MARTIN INC. 11-58  
 NOTE: SEE SHEET 11-59 FOR CHANGES

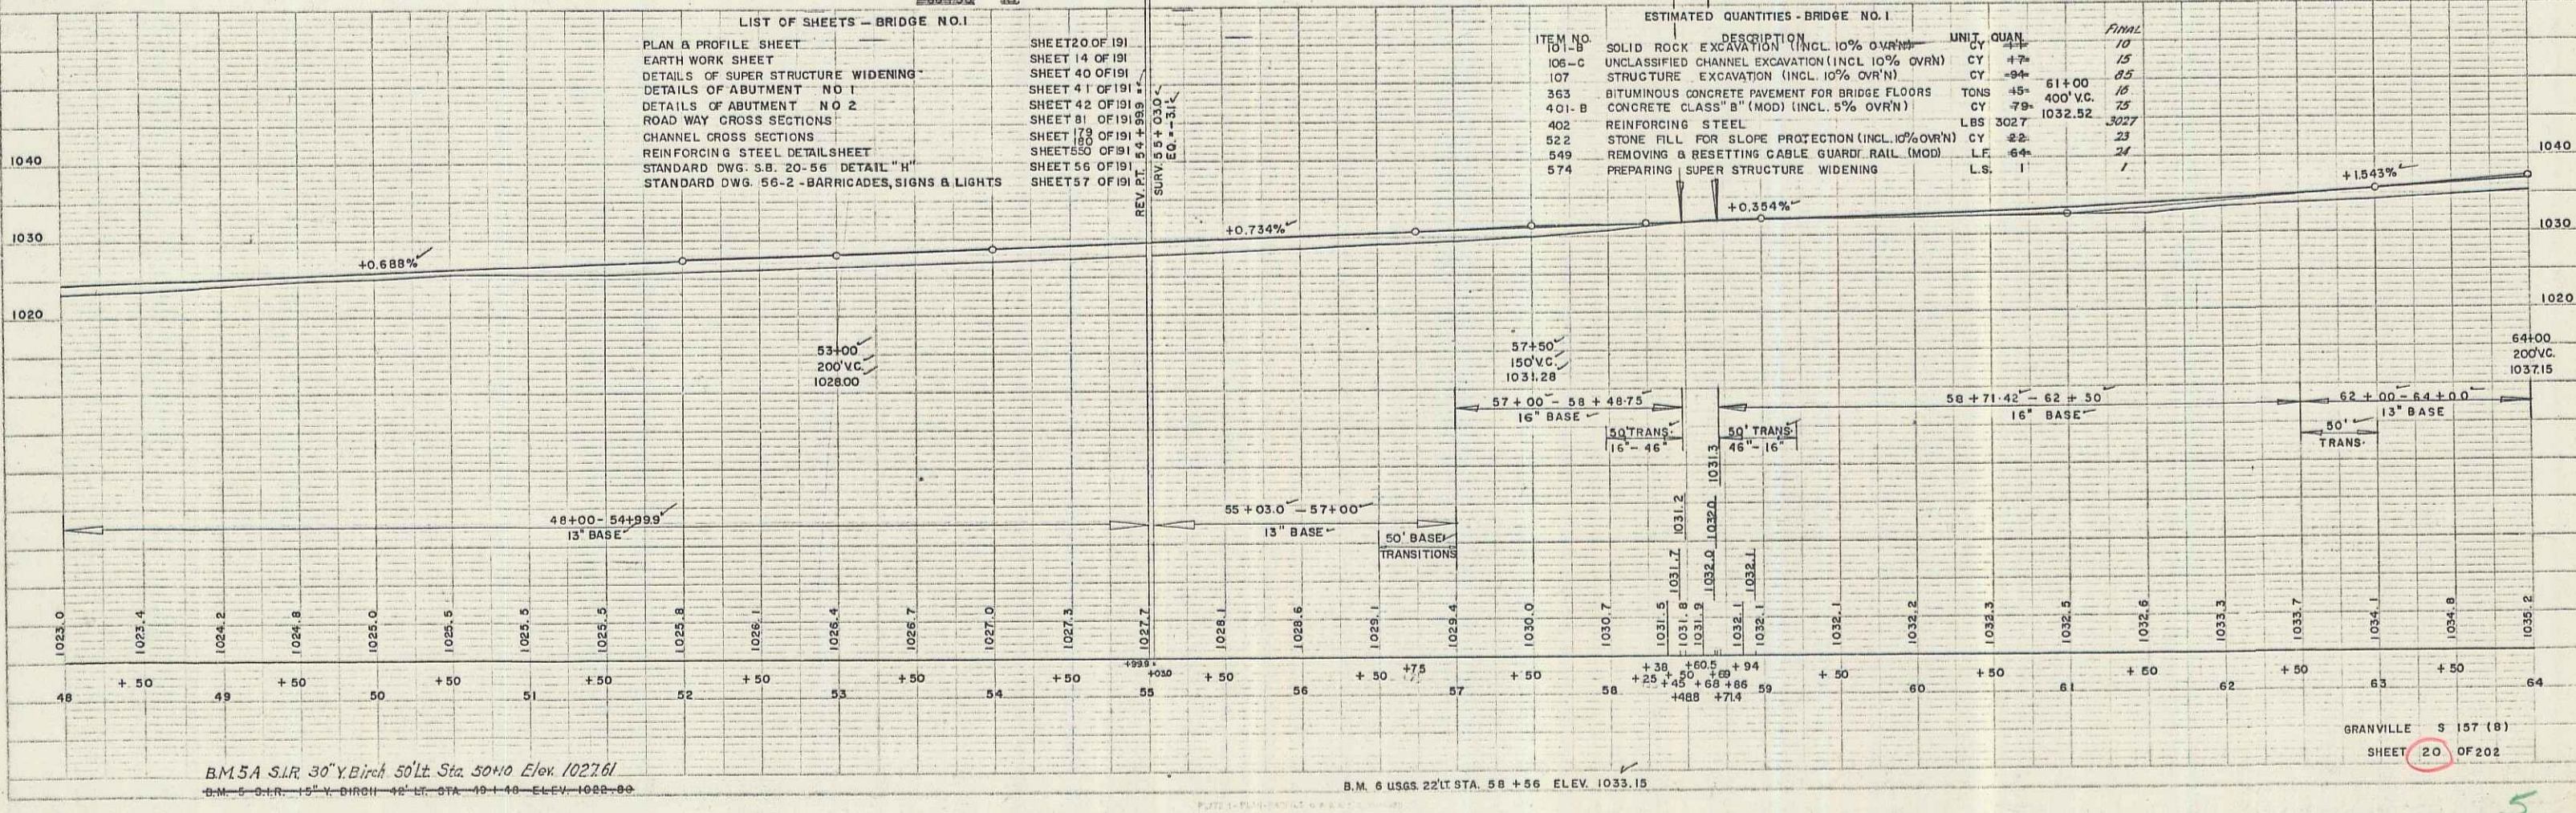

B.M. 5 A.R. 30' Y. BIRCH 50' LT. STA. 50+10 ELEV. 1027.61  

B.M. 6 USGS 22' LT. STA. 58+56 ELEV. 1033.15

5