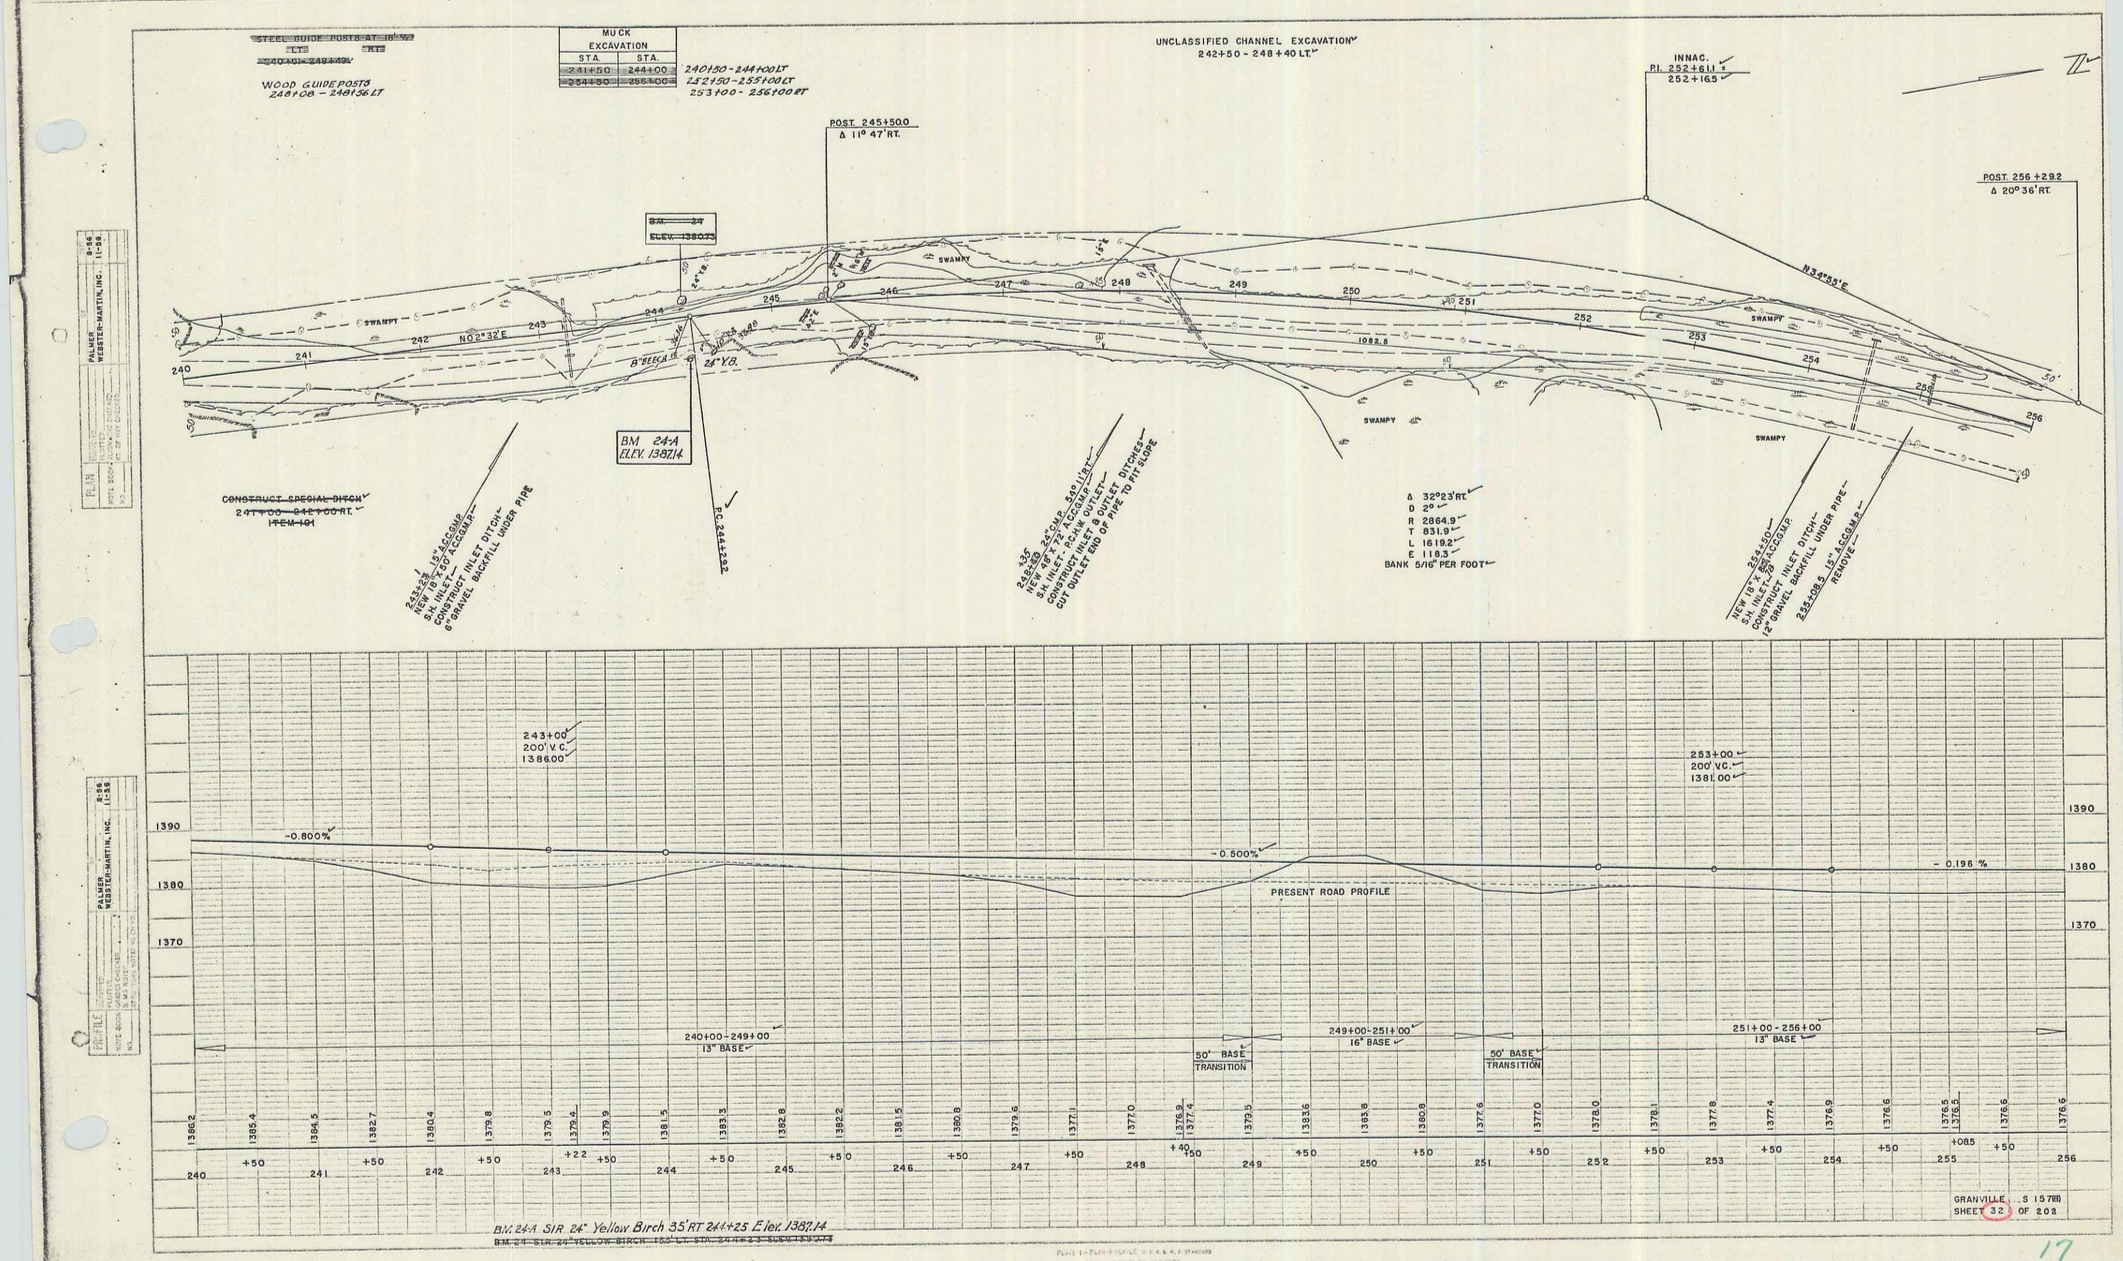
STEEL GUIDE POSTS AT R/W
LT.
RT.
WOOD GUIDEPOSTS
248+08 - 248+56 LT
MUCK EXCAVATION
STA. STA.
241+50 244+00
254+50 256+00
240+50 - 244+00 LT
LT 250 - 255+00 LT
253+00 - 256+00 RT
UNCLASSIFIED CHANNEL EXCAVATION
242+50 - 248+40 LT.
INNAC.
PI. 252+61.1
252+16.5
POST. 245+50.0
Δ 11° 47' RT.
POST. 256+29.2
Δ 20° 36' RT.
BM. 24
ELEV. 138.73
SWAMPY
N0°2'32"E
N34°55'E
1082.5
BM 24-A
ELEV. 138.14
PC 244+22.2
CONSTRUCT SPECIAL DITCH
247+00 - 248+00 RT.
ITEM 401
243+28 15" ACCGMP.
NEW 18" x 43' ACCGMP.
S.N. INLET
CONSTRUCT INLET DITCH
6" GRAVEL BACKFILL UNDER PIPE
+35
248+80 24" CMP. 540' LRT
NEW 48" x 72' ACCGMP.
S.N. INLET - RCAW OUTLET
CONSTRUCT INLET & OUTLET DITCHES
CUT OUTLET END OF PIPE TO FIT SLOPE
Δ 32°23' RT.
D 2°
R 2864.9'
T 831.9'
L 1619.2'
E 118.3'
BANK 5/16" PER FOOT
NEW 18" x 79' ACCGMP.
S.N. INLET
CONSTRUCT INLET DITCH
12" GRAVEL BACKFILL UNDER PIPE
REMOVE
243+00
200' V.C.
1386.00
253+00
200' V.C.
1381.00
-0.800%
-0.500%
-0.196%
PRESENT ROAD PROFILE
240+00 - 249+00
13" BASE
50' BASE TRANSITION
249+00 - 251+00
16" BASE
50' BASE TRANSITION
251+00 - 256+00
13" BASE
1390
1380
1370
BM. 24-A SIR 24" Yellow Birch 35' RT 244+25 Elev. 138.14
GRANVILLE S 15768
SHEET 32 OF 203
PALMER WEBSTER-MARTIN, INC.
PLAN
PROFILE

17