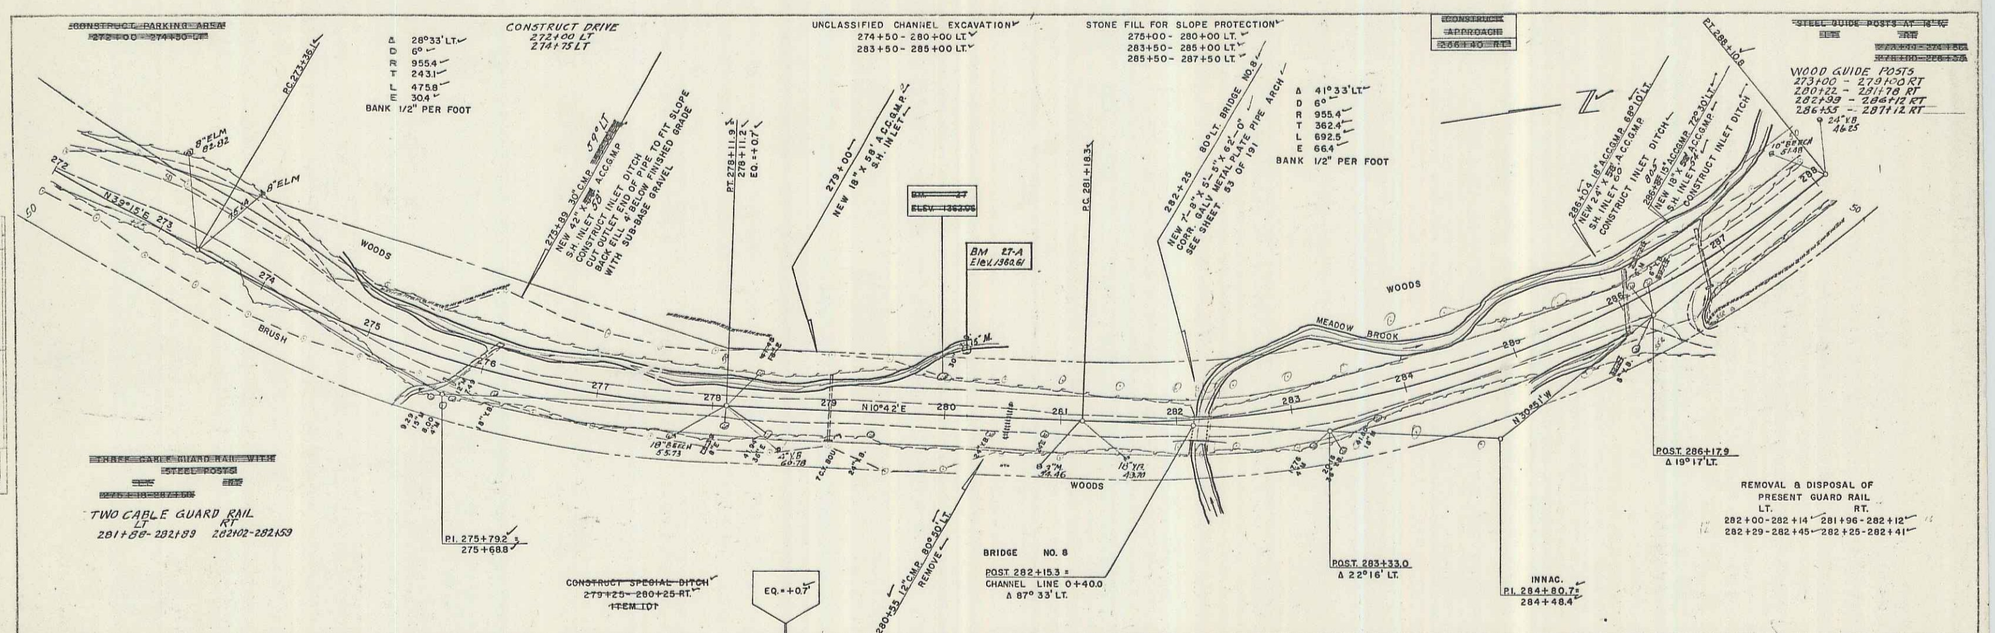

LIST OF SHEETS BRIDGE NO 8

PLAN & PROFILE SHEET	SHEET 34 OF 191
EARTH WORK SHEET	SHEET 14 OF 191
DETAILS OF 7'-8" X 5'-5" X 62'-0" CGMPPA	SHEET 53 OF 191
ROAD WAY CROSS SECTIONS	SHEET 161 OF 191
CHANNEL CROSS SECTIONS	SHEET 190 OF 191

ESTIMATED QUANTITIES BRIDGE NO 8

ITEM NO.	DESCRIPTION	UNIT	QUAN	FINAL
101-B	SOLID ROCK EXCAVATION (INCL. 10% OVERRUN)	CY	28	25
106-C	UNCLASSIFIED CHANNEL EXCAVATION (INCL. 10% OVERRUN)	CY	17	15
107	STRUCTURE EXCAVATION (INCL. 10% OVERRUN)	CY	51	46
222	GRAVEL BACKFILL	CY	62	62
429-B	7'-8" X 5'-5" X 62'-0" C G M P P A	LS	1	1
442	REMOVAL OF PRESENT SUPERSTRUCTURE	LS	1	1
526	RIP RAP FOR BANK PROTECTION (INCL. 10% OVERRUN)	CY	47	38