THREE CABLE GUARD RAIL
BETWEEN POSTS
BTL — BTL
~~320 + 00 — 323 + 00~~
~~326 + 75 — 335 + 87~~

REVISED
Δ 28°51' LT.
D 5°
R 1146.3
T 294.9
L 577.0
E 37.3
BANK 1/2" PER FOOT

TWO CABLE GUARD RAIL
320+00 - 323+33 RT
323+13 - 329+22 RT
330+50 - 335+54 RT

WOOD GUIDE POSTS
328+30 - 330+42 RT

DRILLING & BLASTING OF
SOLID ROCK SUBGRADE
320 + 50 - 321 + 75
323 + 50 — 324 + 50
325 + 00 — 325 + 75
326 + 00 — 327 + 25
328 + 00 — 330 + 20
334 + 50 — 336 + 00
324+50 - 327+50
328+08 - 330+78
331+90 - 336+00

STEEL GUIDE POST @ 16' C
BTL — BTL
~~321+74 - 328+06~~ ~~335+80 - 336+00~~

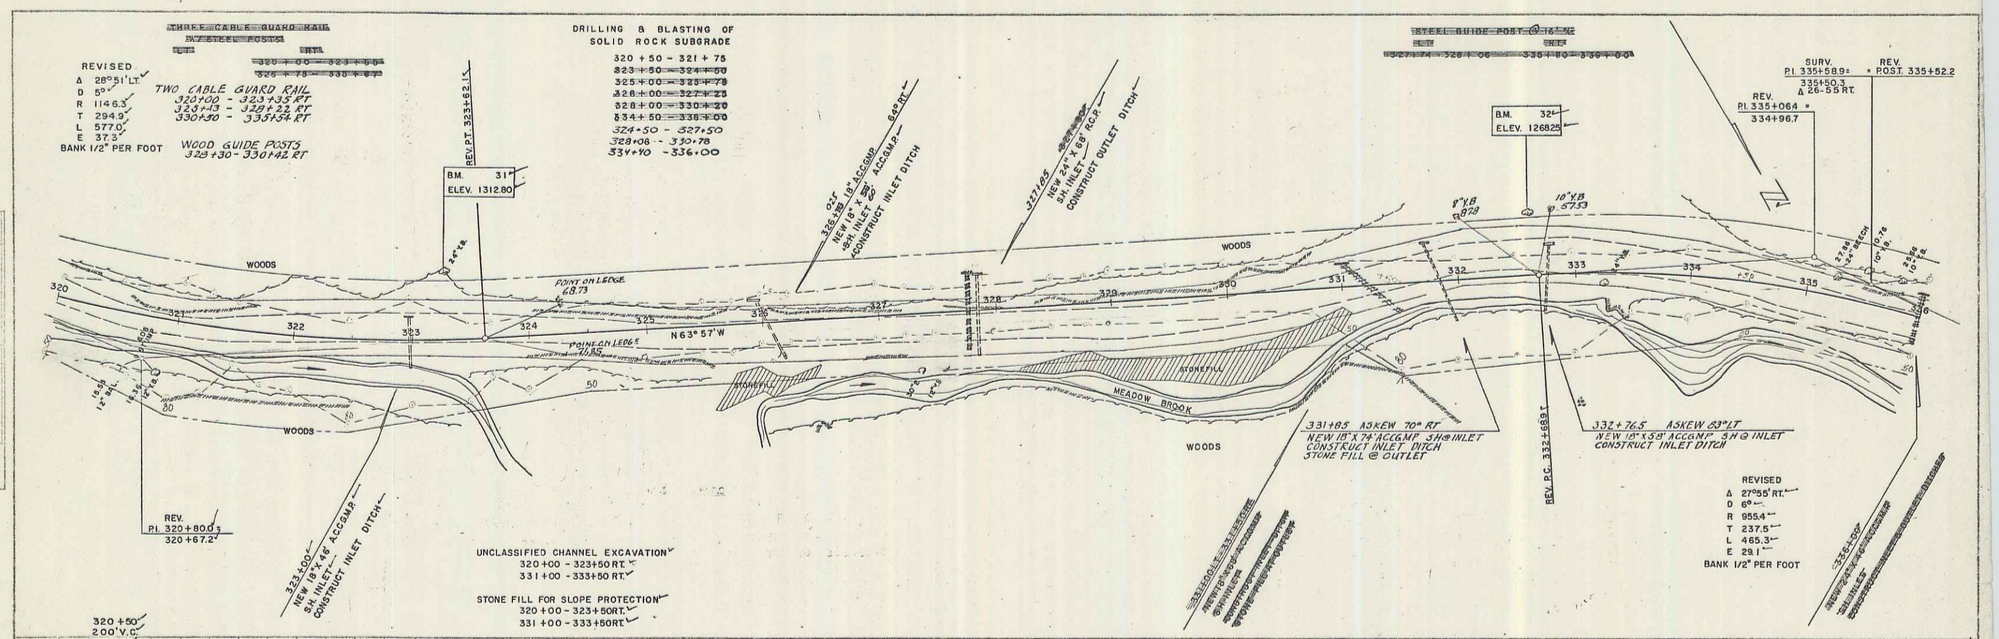

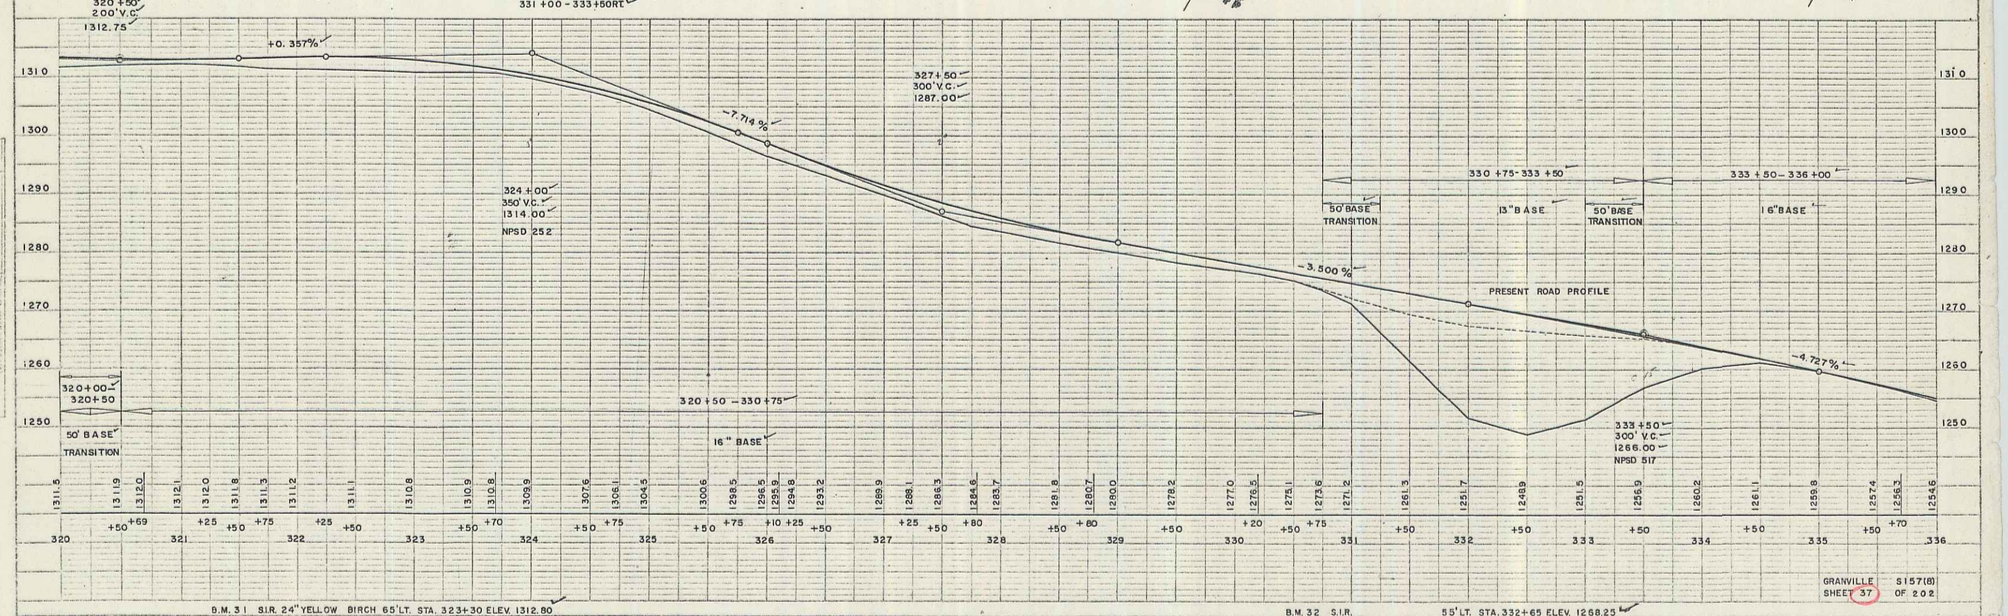

B.M. 31 S.I.R. 24" YELLOW BIRCH 65' LT. STA. 323+30 ELEV. 1312.80

B.M. 32 S.I.R. 55' LT. STA. 332+65 ELEV. 1268.25

GRANVILLE S157(8)
SHEET 37 OF 202

22