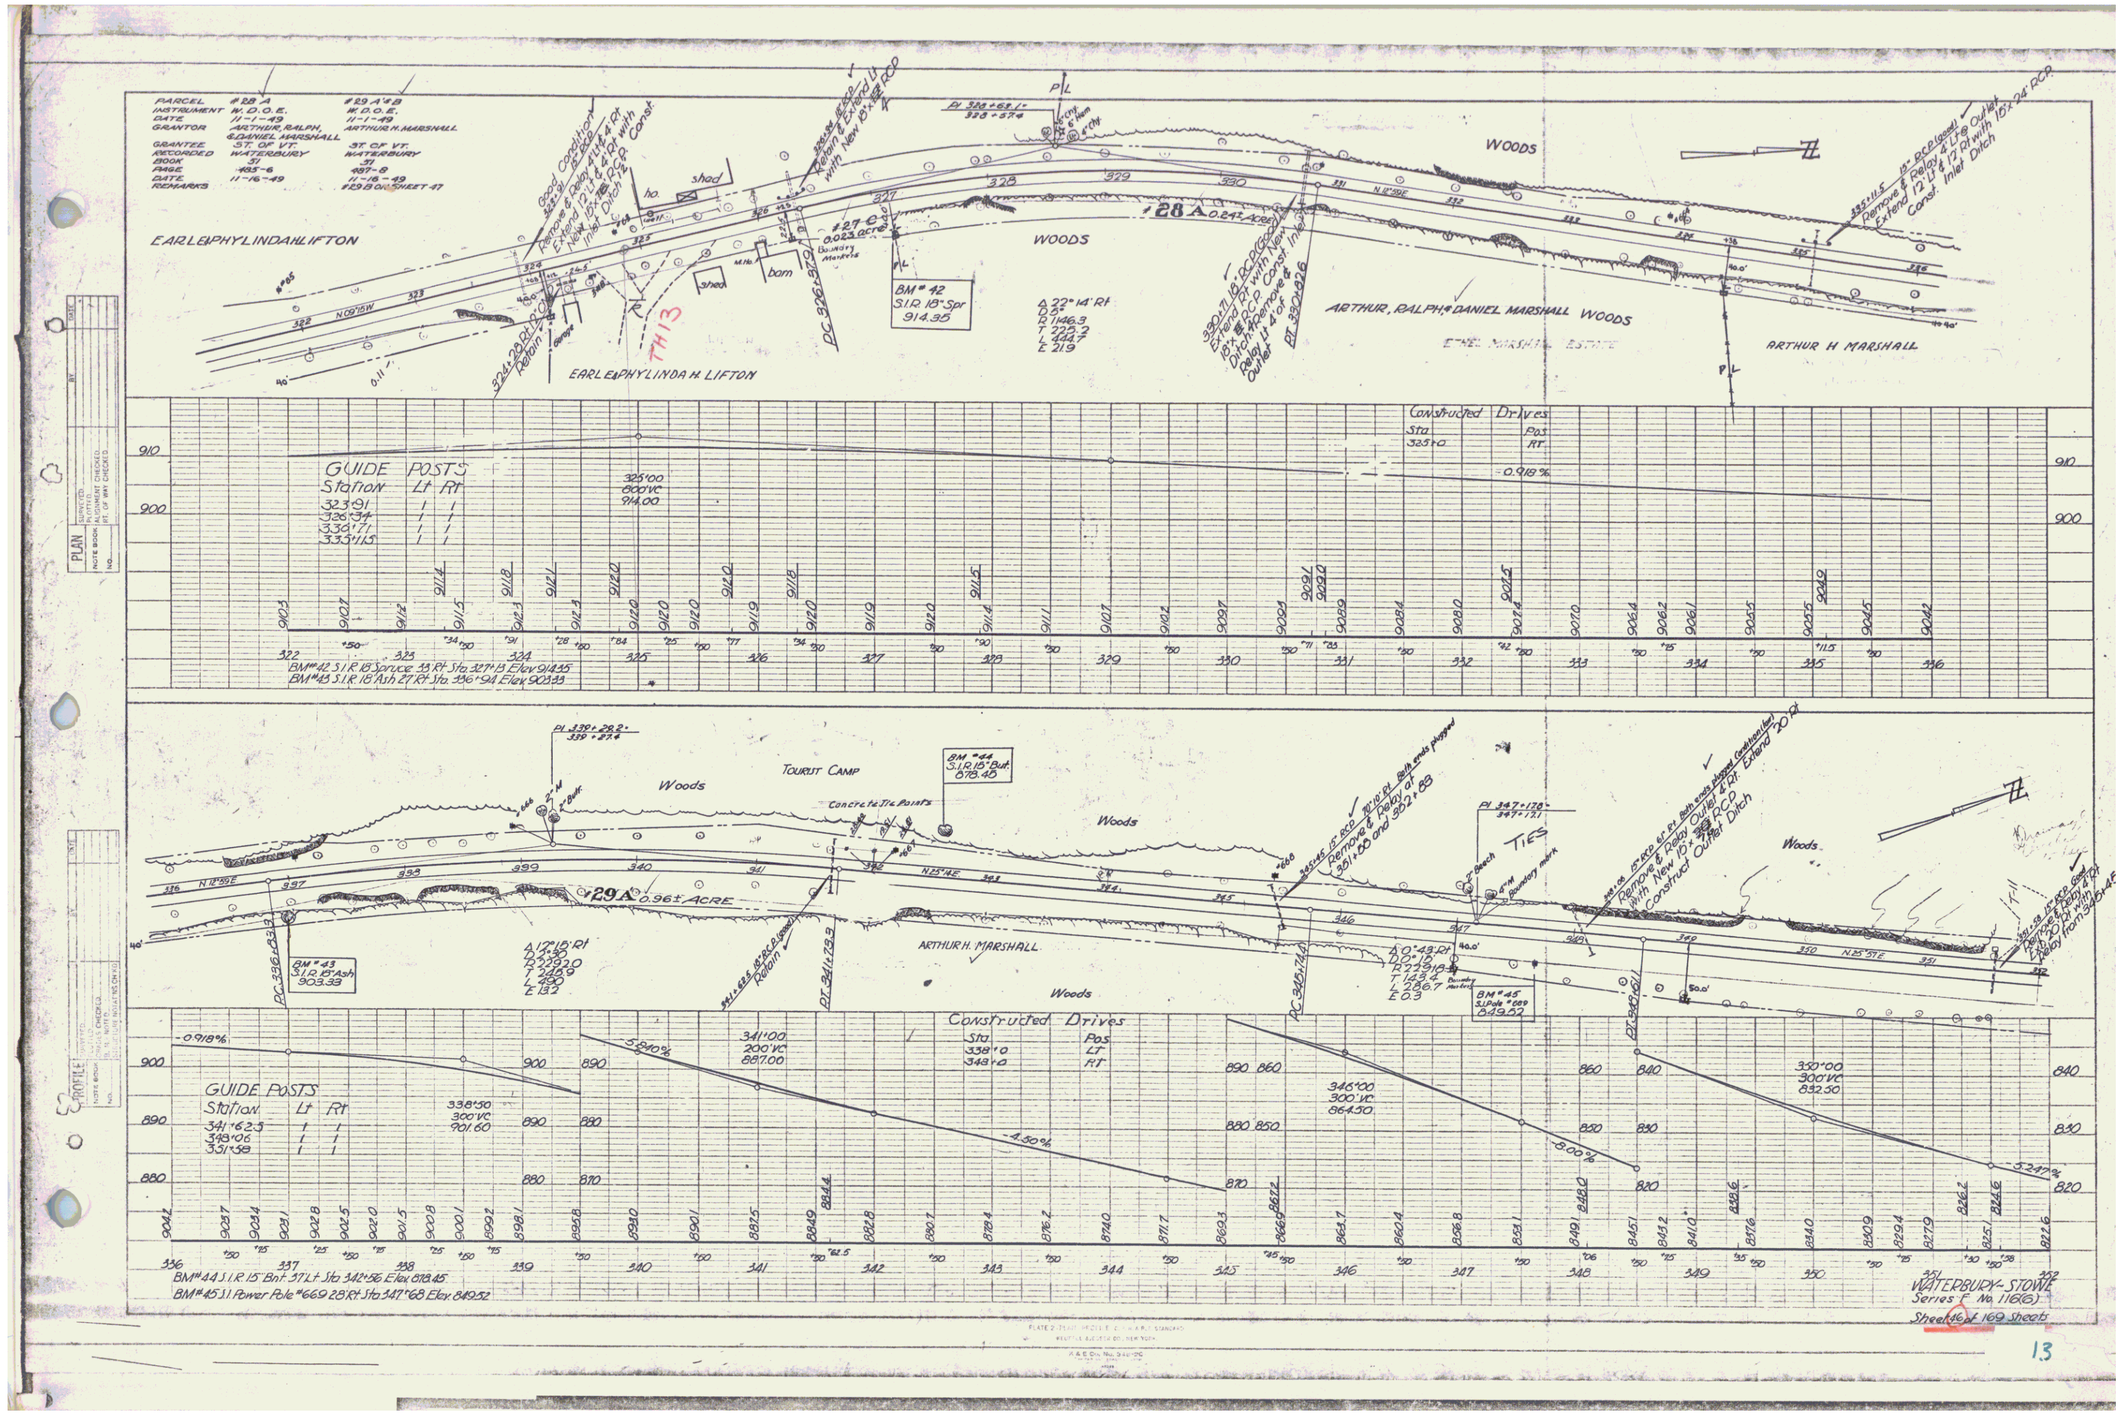
PARCEL #28 A #29 A & B
INSTRUMENT W.D.O.E. W.D.O.E.
DATE 11-1-49 11-1-49
GRANTOR ARTHUR, RALPH, & DANIEL MARSHALL ARTHUR H. MARSHALL
GRANTEE ST. OF VT. ST. OF VT.
RECORDED WATERBURY WATERBURY
BOOK 51 51
PAGE 485-6 487-8
DATE 11-16-49 11-16-49
REMARKS #29 B on SHEET 47
EARL EPHYLINDA H. LIFTON
EARL EPHYLINDA H LIFTON
WOODS
WOODS
#28 A 0.247 ACRE
#27 C 0.023 ACRE
ARTHUR, RALPH & DANIEL MARSHALL WOODS
ARTHUR H MARSHALL
BM # 42 S.I.R. 18" Spr 914.95
Constructed Drives
Sta Pos
325+10 RT
-0.918%
GUIDE POSTS
Station Lt Rt
323+91
326+34
330+77
333+15
325+00 800' VC 914.00
BM # 42 S.I.R. 18" Spruce 33' Rt Sta 327+13 Elev 914.35
BM # 43 S.I.R. 18" Ash 27' Rt Sta 336+94 Elev 903.33
Tourist Camp
Woods
Woods
#29 A 0.96± ACRE
ARTHUR H. MARSHALL
Woods
Concrete Tie Points
TIES
BM # 44 S.I.R. 15" Bnt. 37' Lt Sta 342+56 Elev 878.45
BM # 45 S.I.R. Power Pole #669 28' Rt Sta 347+68 Elev 849.52
Constructed Drives
Sta Pos
338+10 LT
348+10 RT
-5.940%
-4.50%
-8.00%
-5.247%
341+00 200' VC 887.00
338+50 300' VC 901.60
345+00 300' VC 864.50
350+00 300' VC 832.50
WATERBURY-STOWE
Series F No. 116(6)
Sheet 46 of 169 Sheets
13