FED. ROAD DIST. NO.	STATE	FED. AID PROJ. NO.	F. SCA. YEAR	SHEET NO.	TOTAL SHEETS
9	VT.	NRH 116 D	1933	10	50

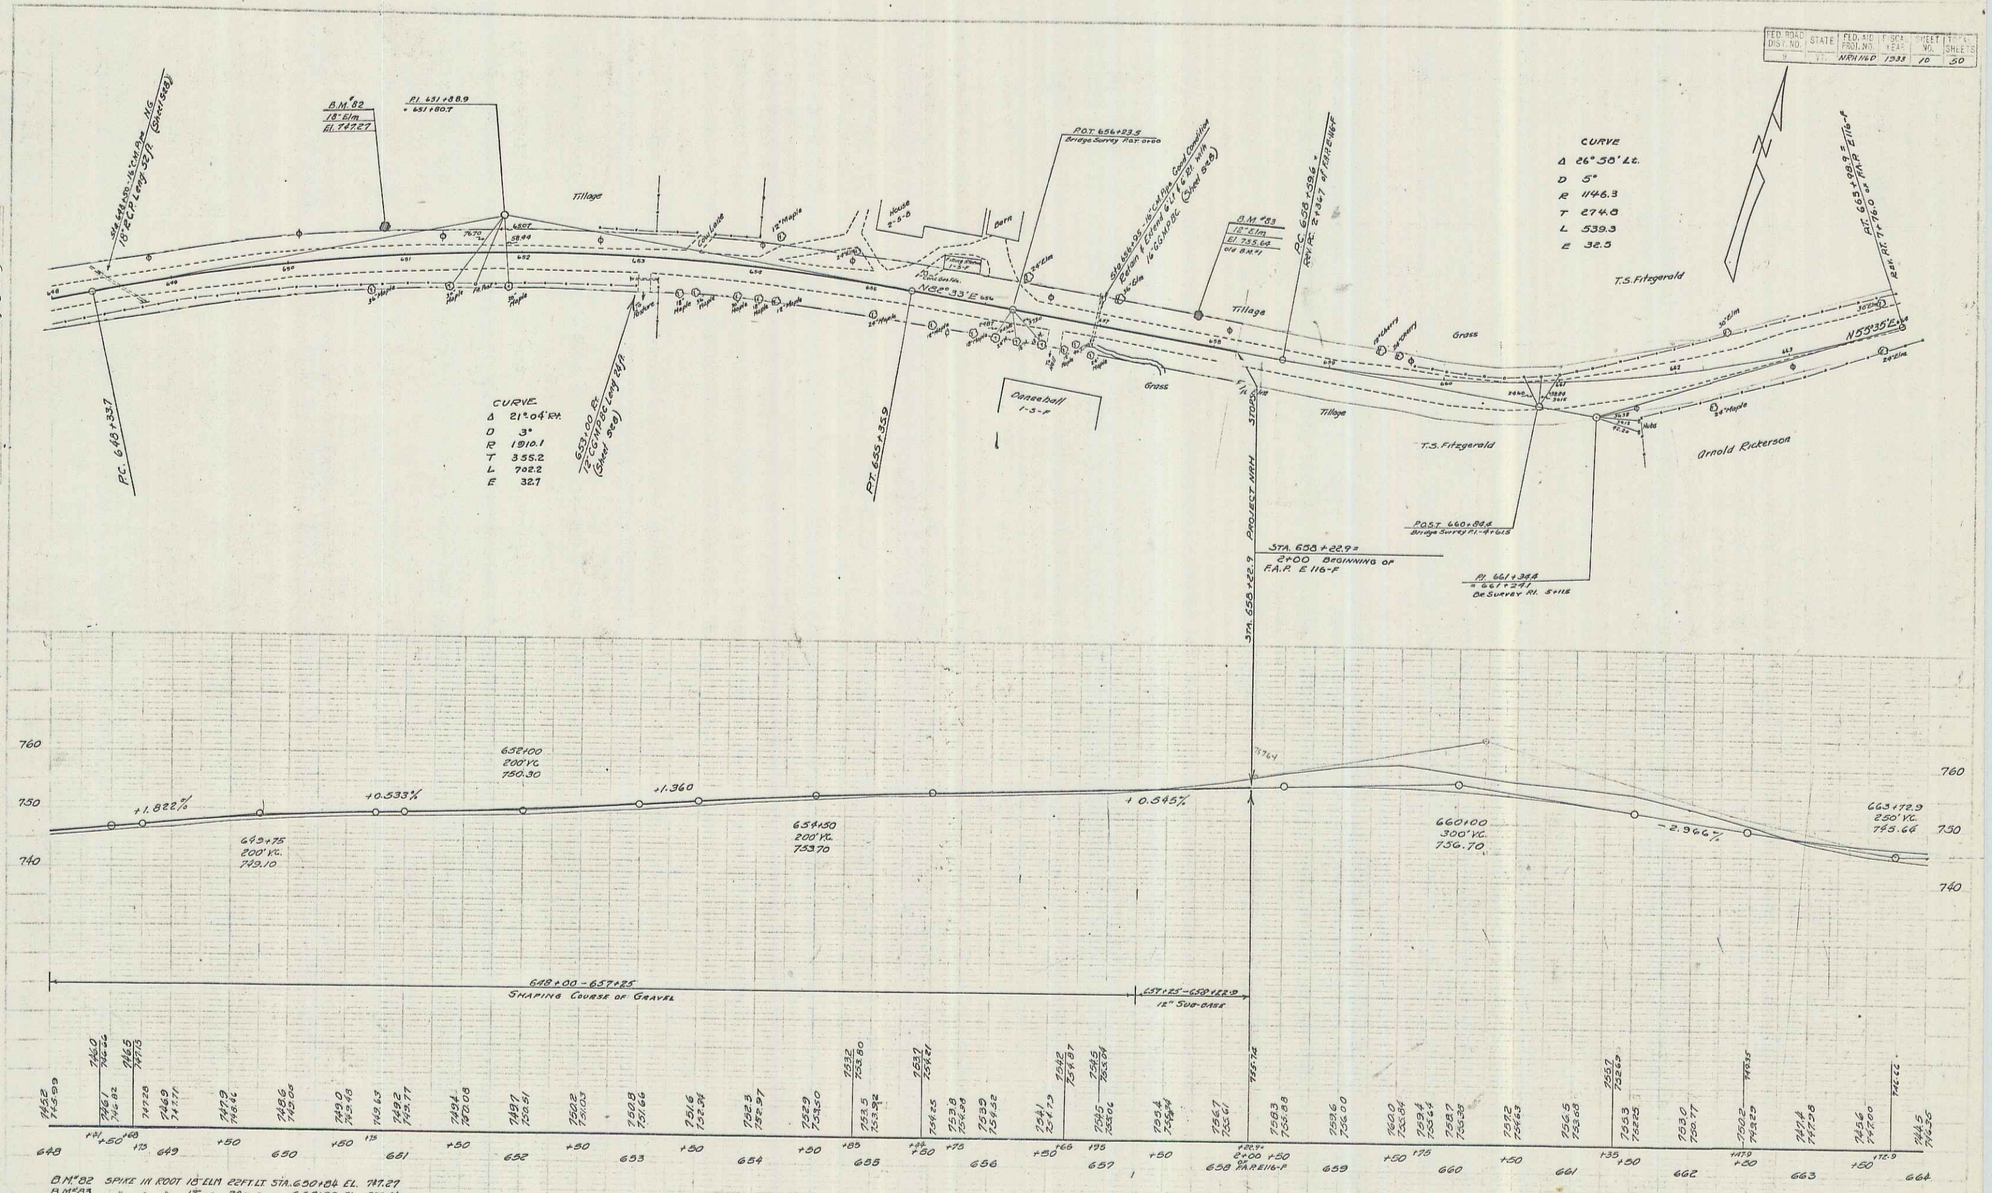

8