POOR ORIGINAL COPY

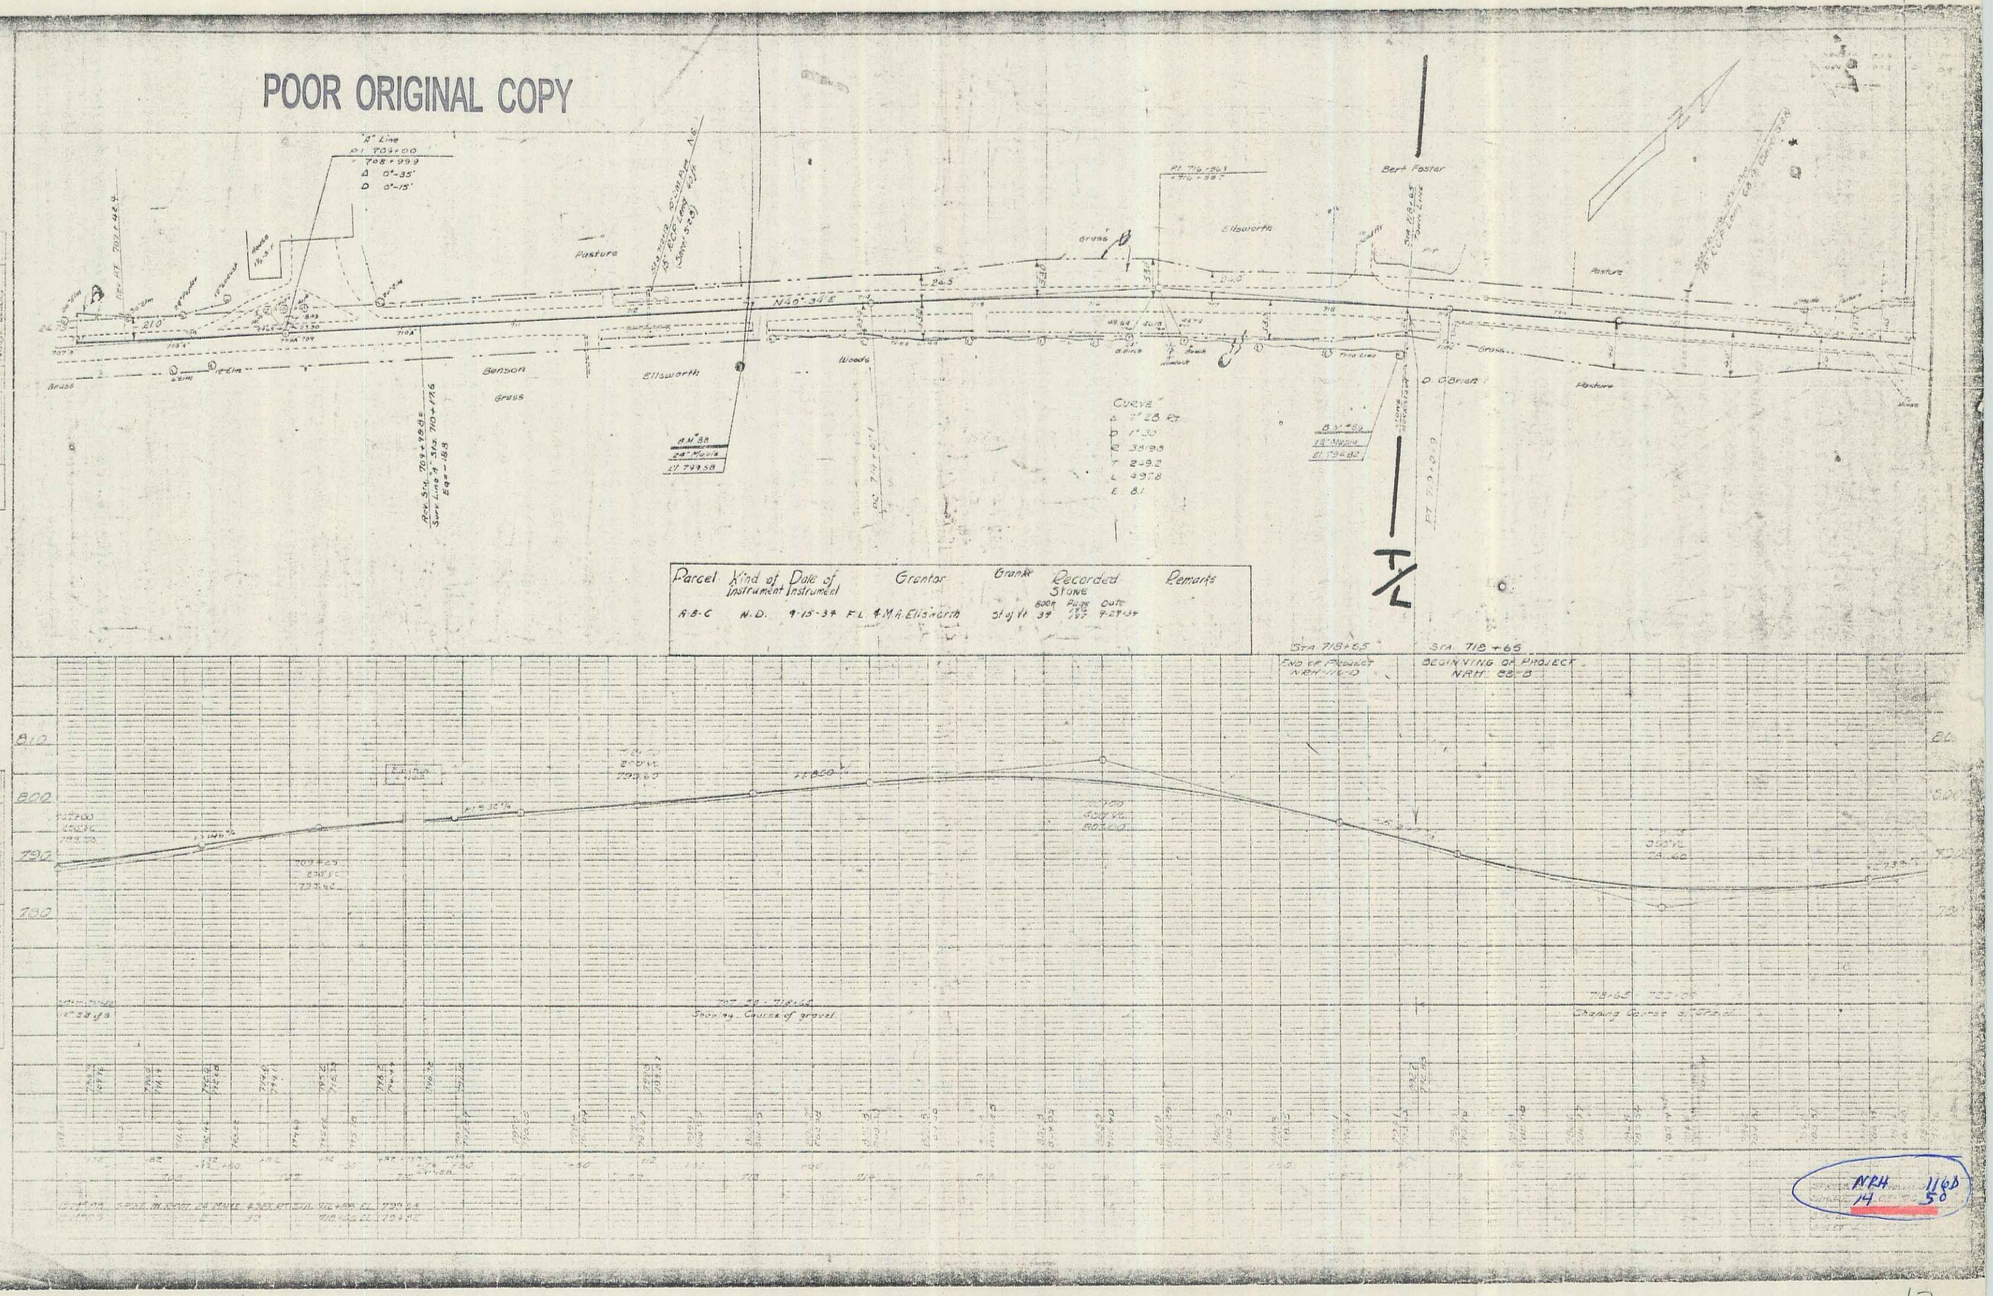

12