


PLAN
 CHECKED BY: []
 DESIGNED BY: []
 DRAWN BY: []
 DATE: []

PROFILE
 CHECKED BY: []
 DESIGNED BY: []
 DRAWN BY: []
 DATE: []

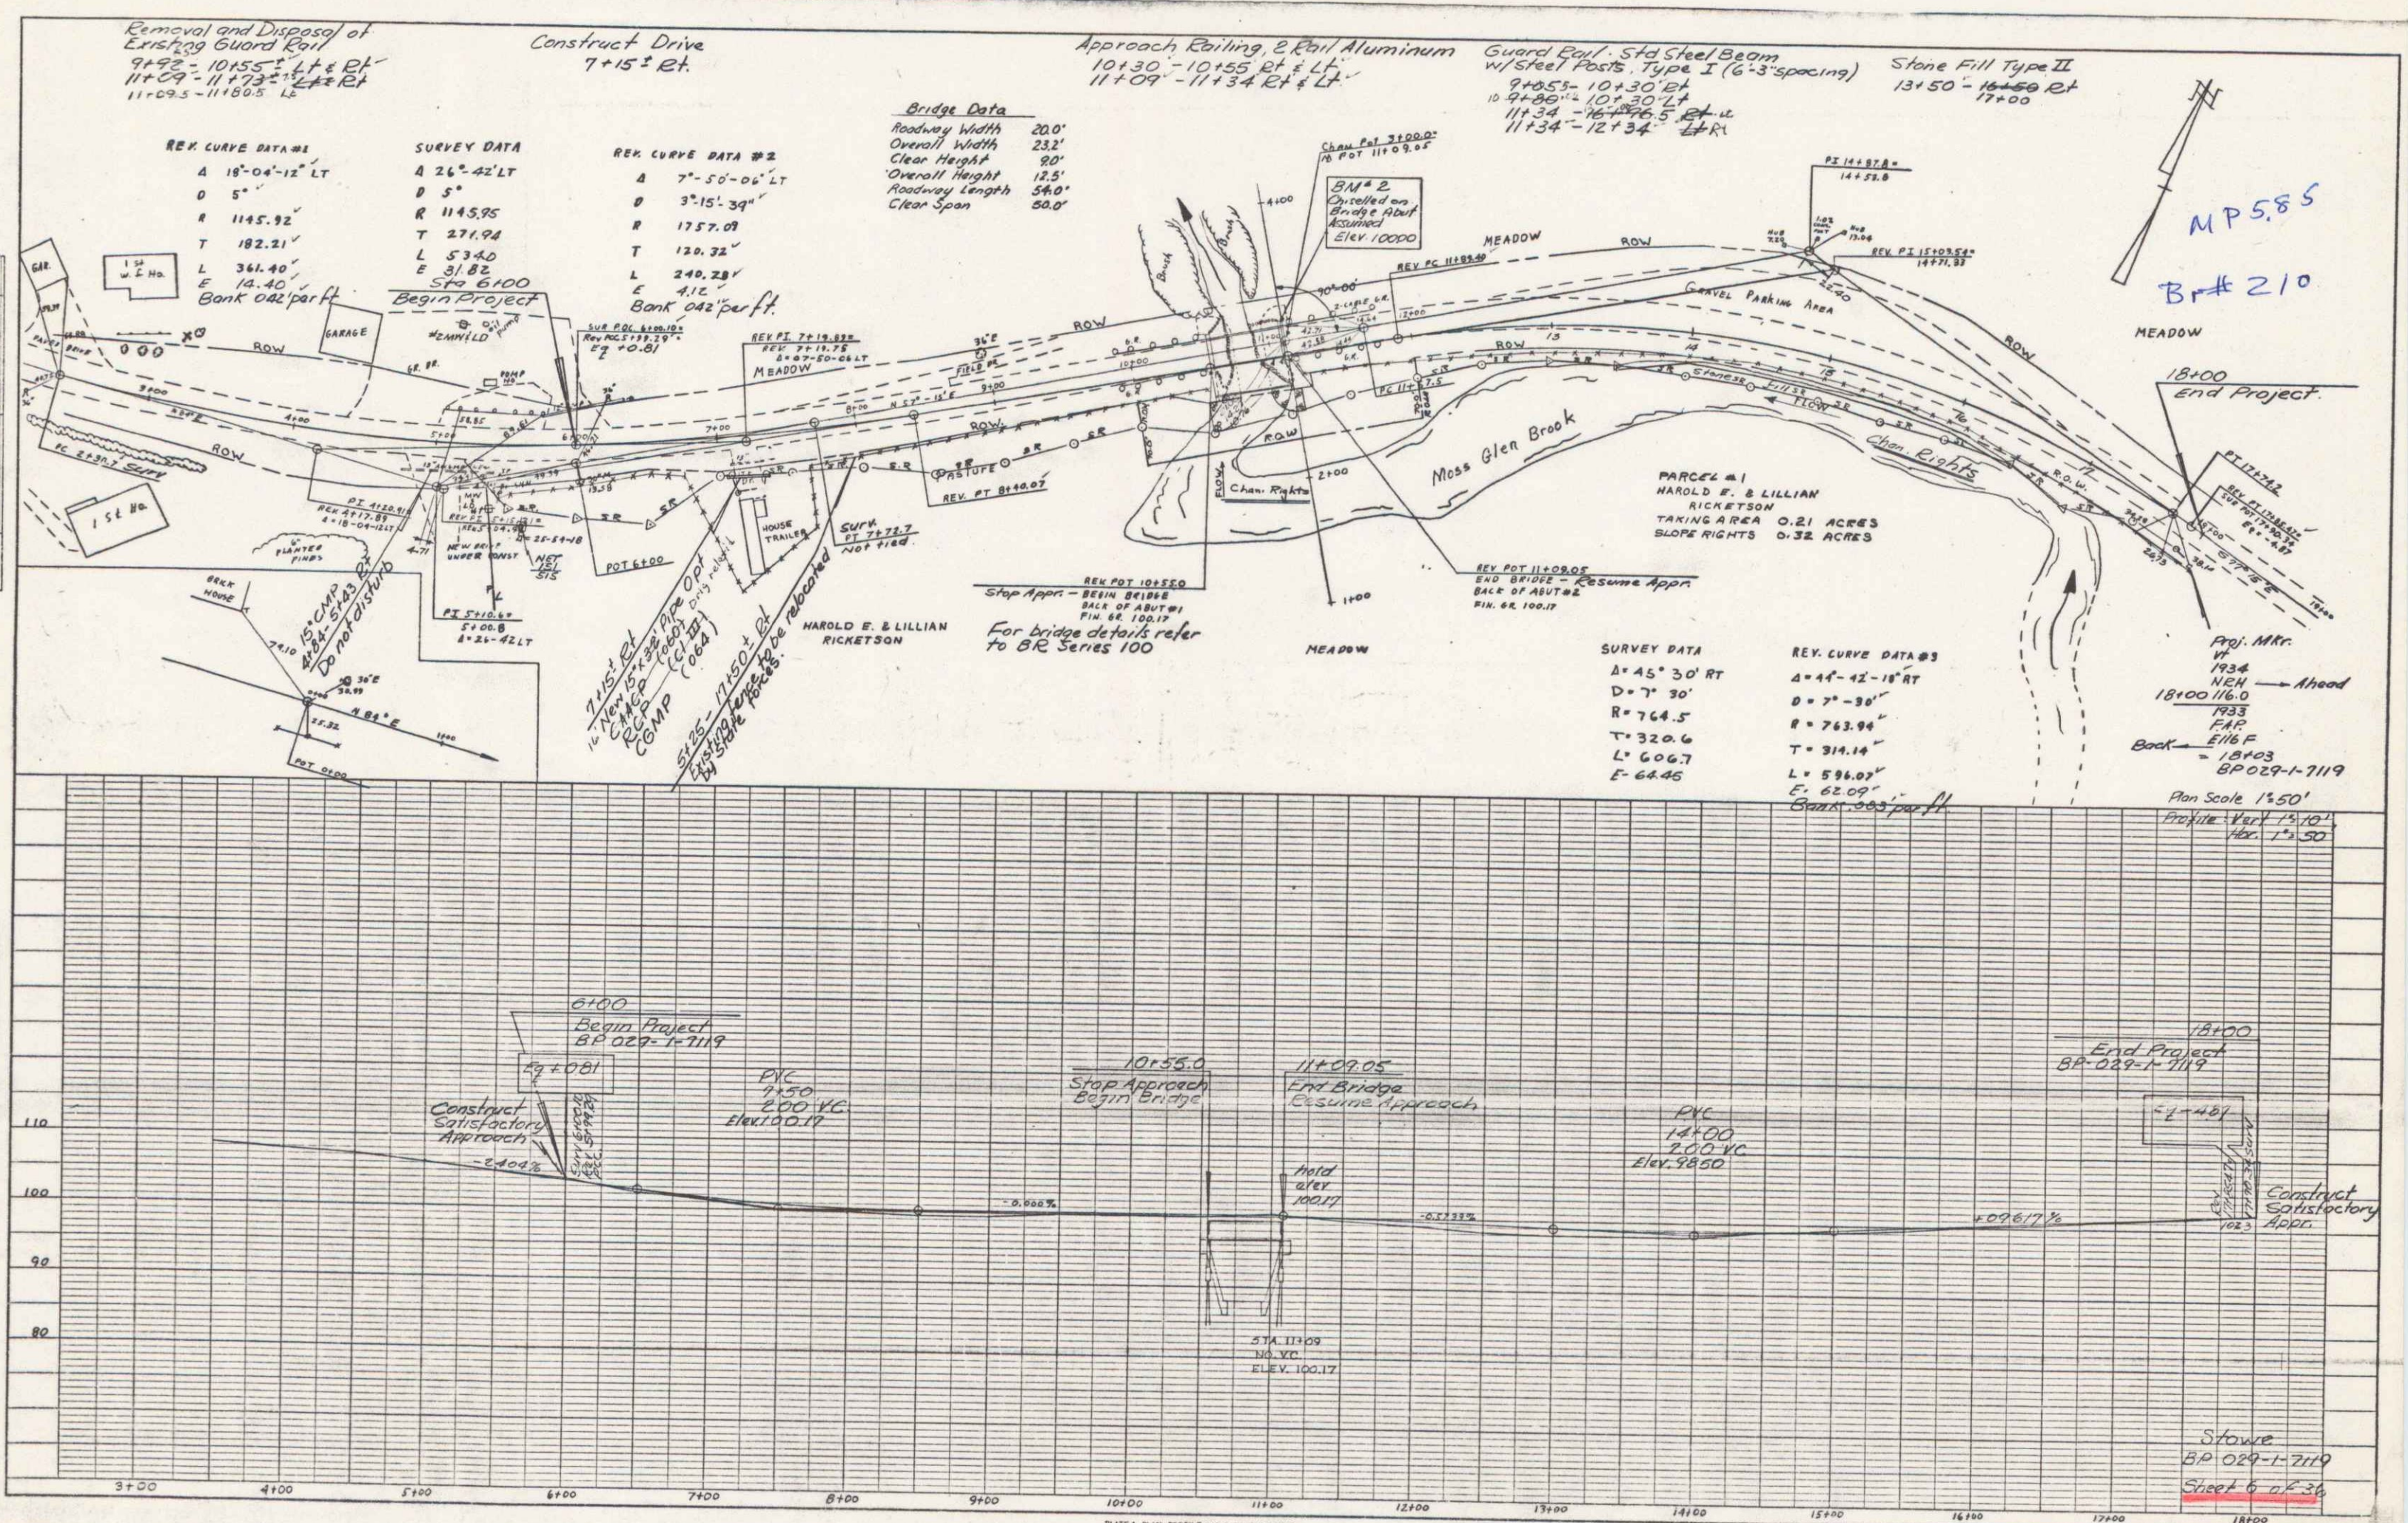

MP 5.85
 B# 210