POOR ORIGINAL COPY

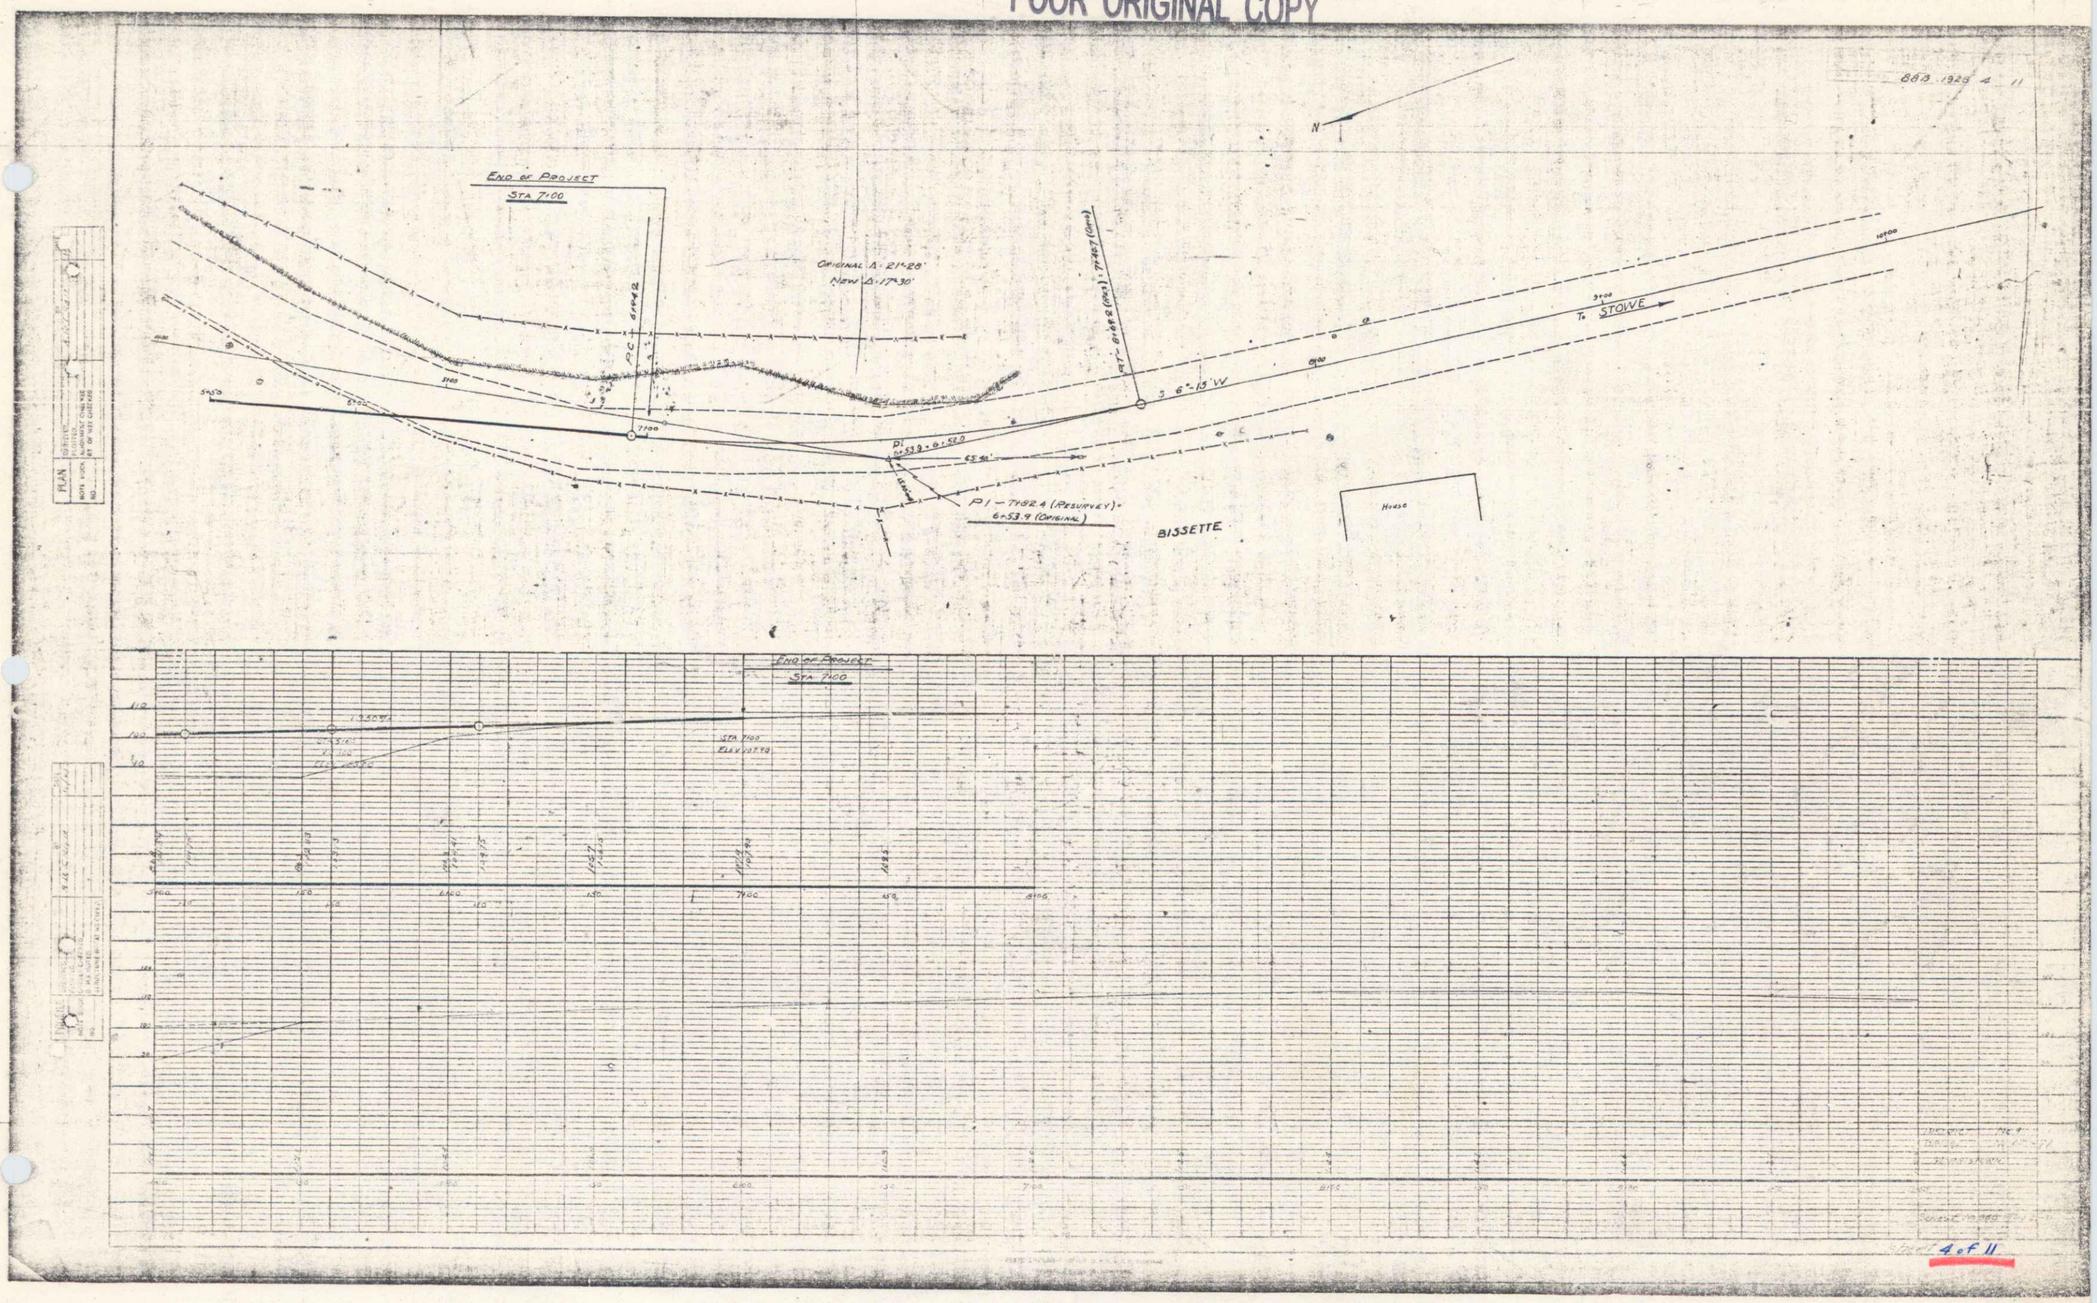

3