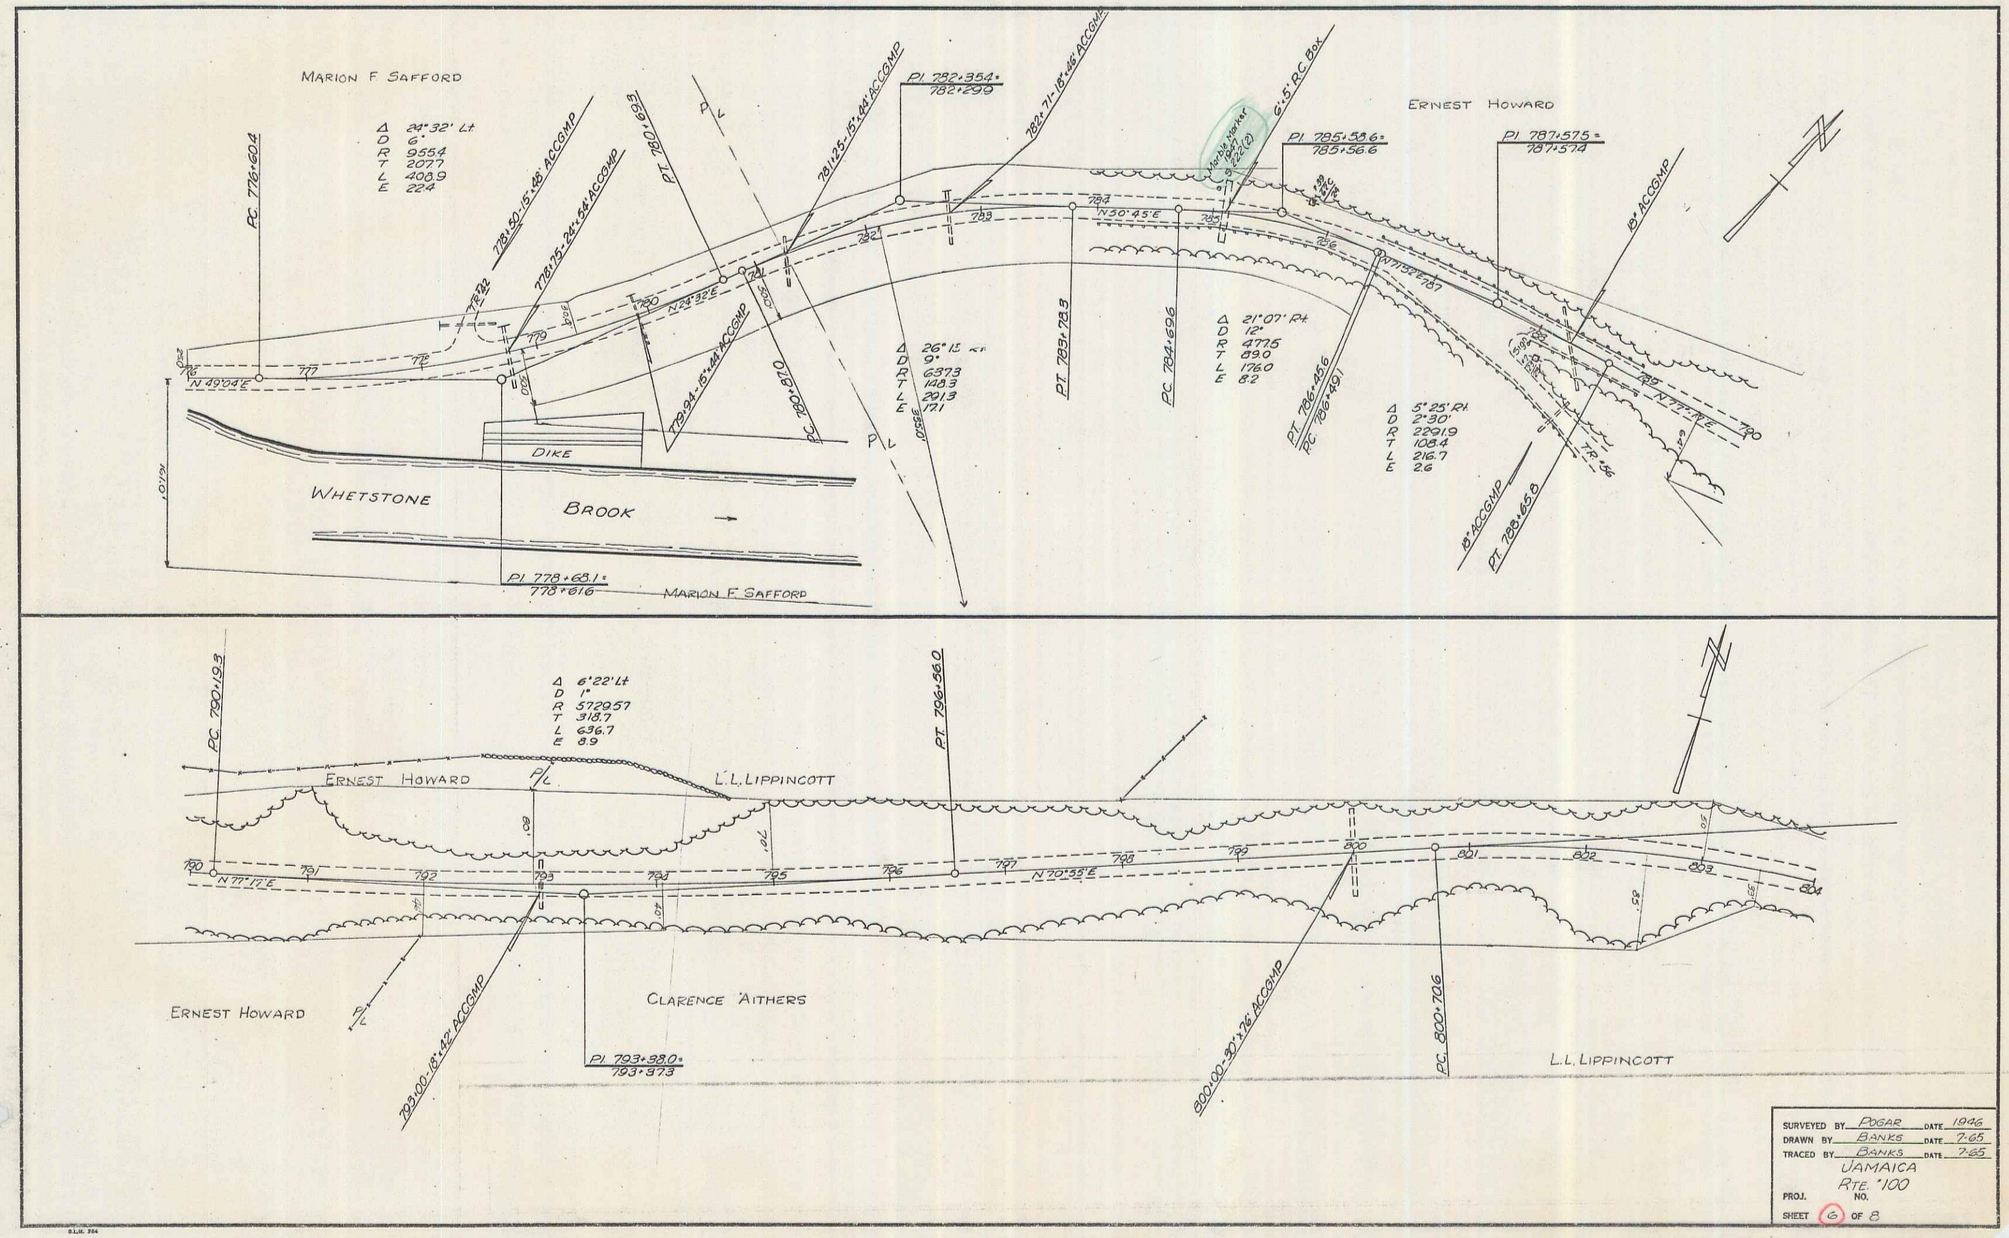

SURVEYED BY POGAR DATE 1946
DRAWN BY BANKS DATE 7-65
TRACED BY BANKS DATE 7-65
JAMAICA
PROJ. RTE. 100 NO.
SHEET 6 OF 8

6