FED. ROAD DIST.	STATE	STATE FLOOD CONTROL NO.	FISCAL YEAR	TOTAL SHEETS
9	VT.	222-L	1939	5 57

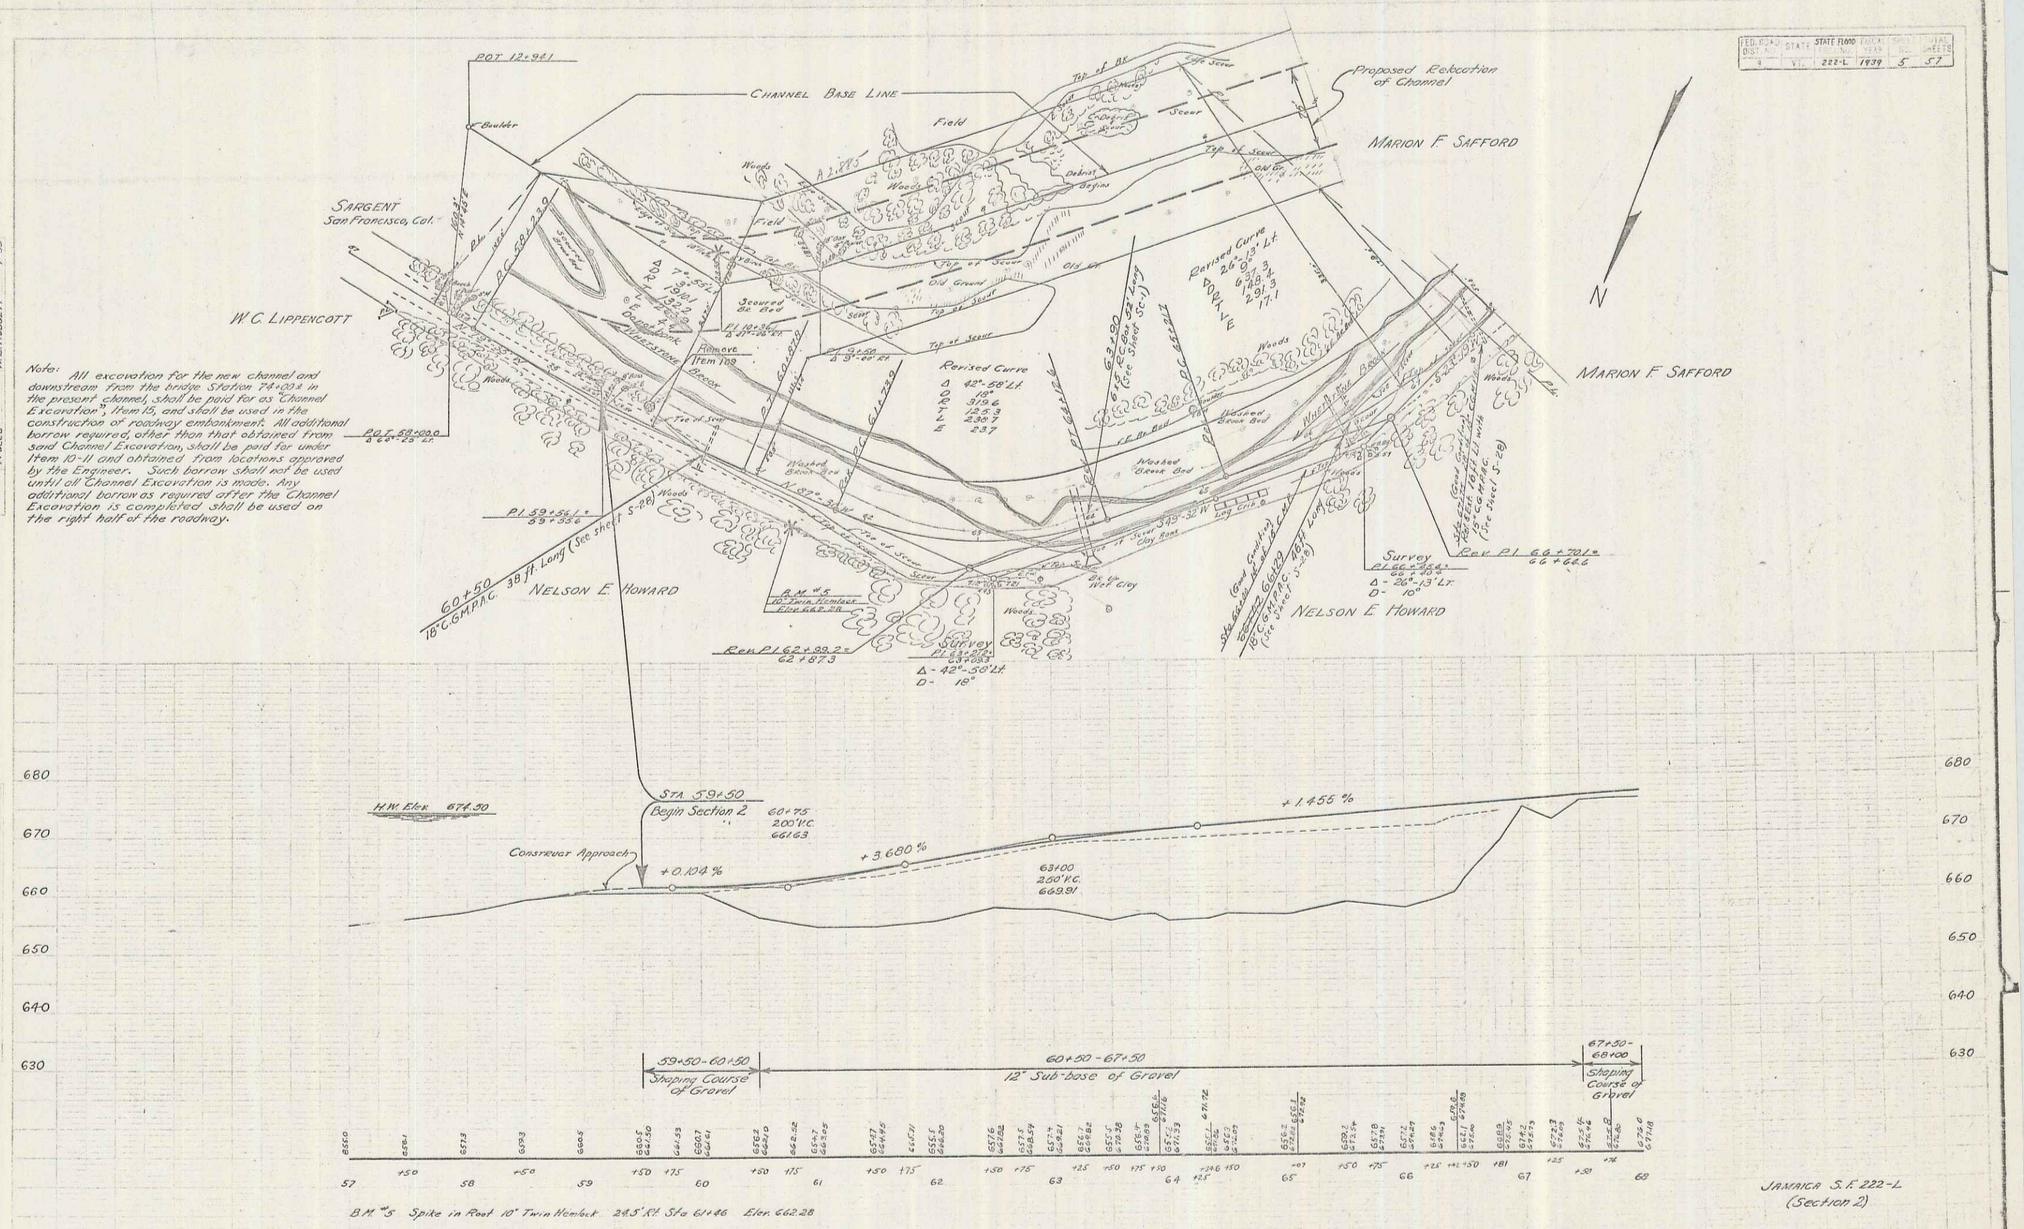

JAMAICA S.F. 222-L
(Section 2)

Sheet 5 of 57

3