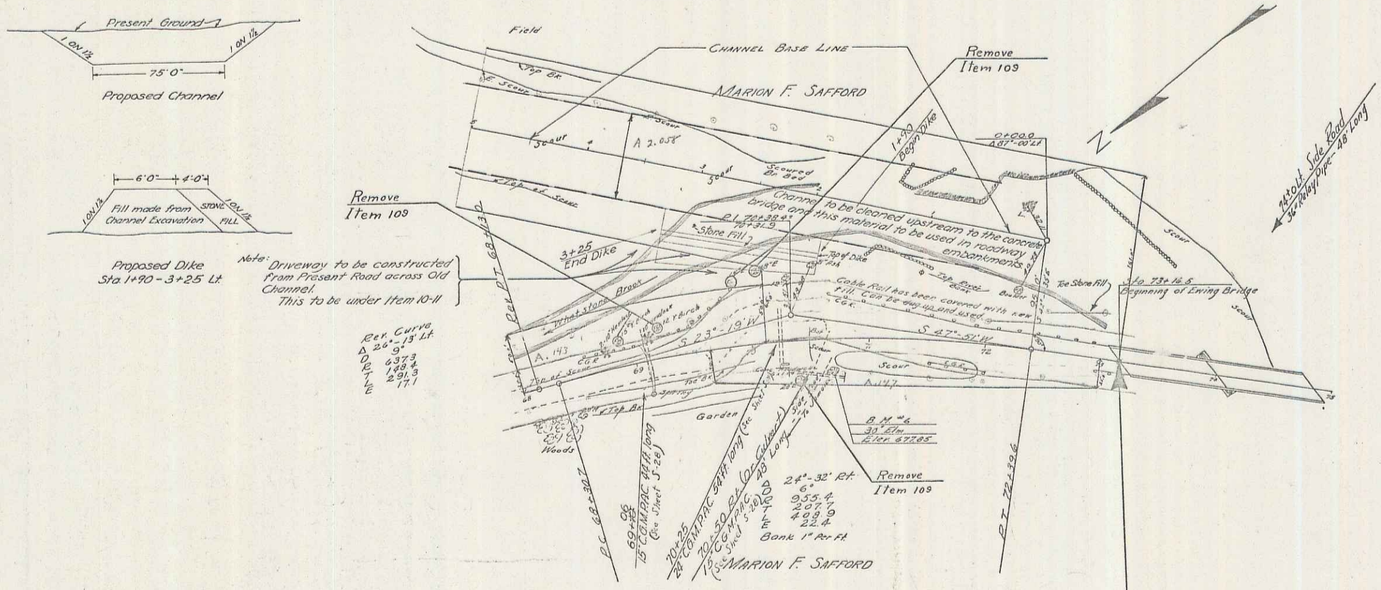FED. ROAD DIST. NO.	STATE	STATE FUND PROJ. NO.	FISCAL YEAR	SHEET NO.	TOTAL SHEETS
9	N.Y.	222-L	1939	6	57