FED. ROAD DIST. NO.	STATE	STATE FLOOD CONTROL NO.	FISCAL YEAR	SHEET NO.	TOTAL SHEETS
9	V.	222-L	1939	10	57

Note:- BOX CULVERT 122 + 22 – The Channel from the inlet upstream shall be cleaned out by the use of a power shovel and the material as excavated deposited on left of Channel to an extent and in a manner approved by the Engineer, this work shall be paid for under the item of Channel Excavation, Item 15.

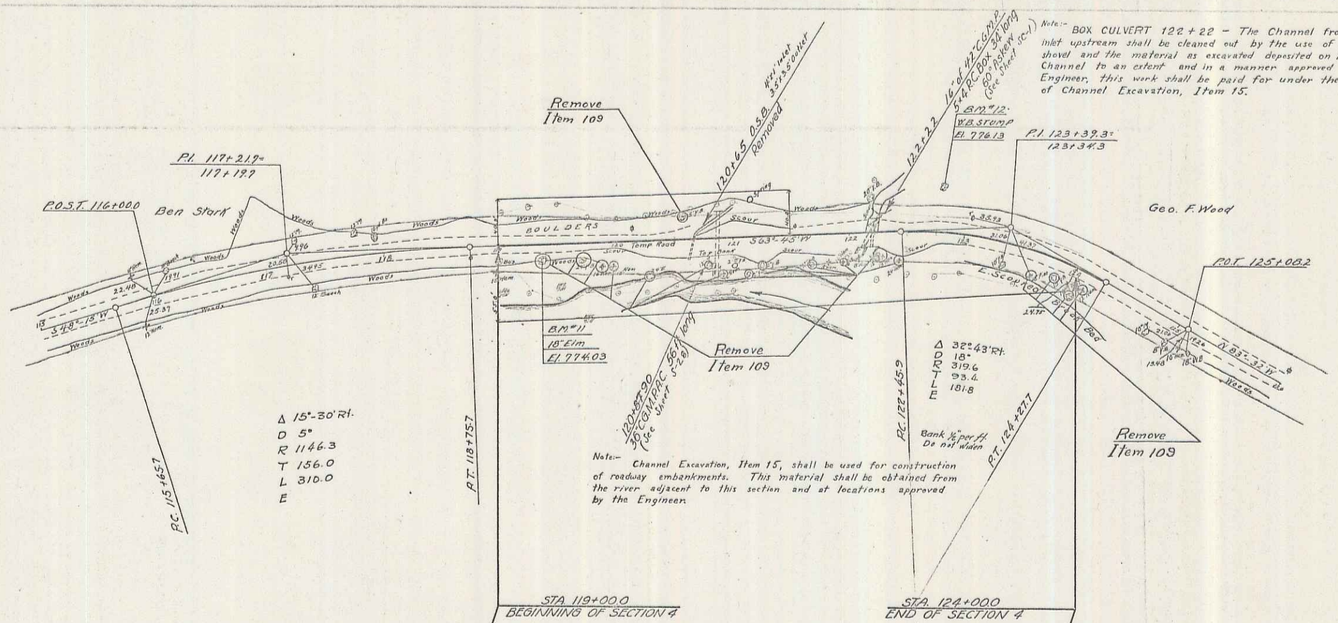

B.M.#11 Spike in Root 18" Elm 11 Ft. Rt. Sta. 119+37 Elev. 774.03

B.M.#12 Spike in Root of White Birch Stump 37.5 Ft. Lt. Sta. 122+83 Elev. 776.13

JAMAICA S.F. 222-L
Section 4
Sheet 10 of 57

8