INDEX OF SHEETS

SHEET NO. 1 TITLE PAGE
" " 2 TYPICAL CROSS-SECTION OF IMPROVEMENT (DOUBLE TACK COAT OF REFINED TAR WITH PEA STONE SEAL, ITEM 29A)
" " 3 BANKING AND WIDENING TABLES
" " 4-9 PLAN AND PROFILE
" " 10 STANDARD STRUCTURE SHEET S-28 PIPE CULVERTS
" " 11 " " " S-49-46 GUARD RAIL
" " 12 " " " S-30A BOUNDARY MARKERS
" " 13 " " " S-40 BARRICADES, SIGNS & LIGHTS
" " 14 " " " S-41 ROUNDING OF SLOPES
" 15-27 CROSS SECTIONS

STANDARD STRUCTURE SHEETS APPROVED
BY THE CHIEF ENGINEER
VERMONT STATE DEPARTMENT OF HIGHWAYS

S-28	APRIL	26, 1941
S-30	MAY	12, 1941
S-30A	APRIL	19, 1941
S-40	DECEMBER	18, 1945
S-49-46	JANUARY	13, 1947

(To Be Returned To R.O.W. Division)
Pt. ~~Bond~~ of
VT 100
PERPETUAL
TOWN FILE
RIGHT-OF-WAY DIVISION

FED. ROAD DIST. NO.	STATE	PROJECT NO.	FISCAL YEAR	SHEET NO.	TOTAL SHEETS
9	VT.	222(2)	1946	1	27

STATE OF VERMONT

STATE HIGHWAY DEPARTMENT

PLAN AND PROFILE OF PROPOSED STATE HIGHWAY

SECONDARY PROJECT

TOWN OF JAMAICA

~~ROUTE 8~~

EAST JAMAICA — WILMINGTON ROAD

BEGINNING AT A POINT ON ROUTE 8, 0.076 MILES SOUTHERLY FROM ITS INTERSECTION WITH ROUTE 30 AND EXTENDING SOUTHWESTERLY 0.951 MILES

LENGTH OF PROJECT 5018.8 FEET = 0.951 MILES

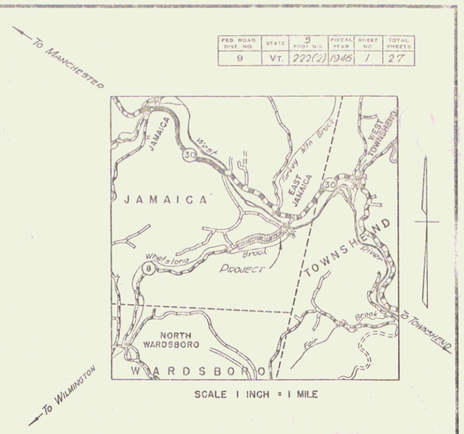

SCALE 1 INCH = 1 MILE

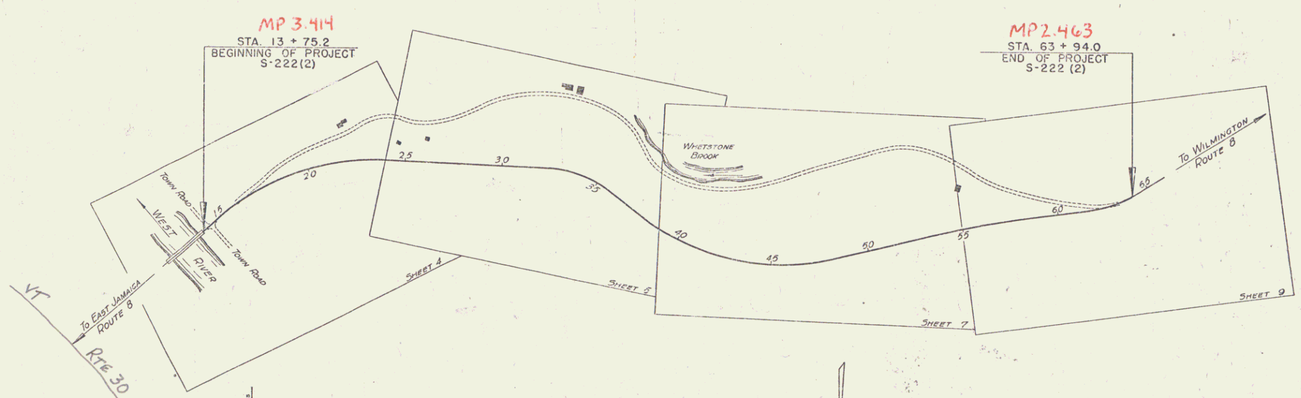

Pur: 00R698
ROUTE 1. VT100

APPROVED: Mar. 28, 1947
H. E. Laugust
COMMISSIONER OF HIGHWAYS

SUBMITTED BY ORDER OF THE STATE HIGHWAY BOARD

GROUND ELEVATION ..... DATUM ..... LINE

GRADE ELEVATION ..... DATUM ..... LINE

CURVE DATA

DEFLECTION ANGLE	Δ
DEGREE OF CURVE	D.
RADIUS OF CURVE	R.
TANGENT DISTANCE	T.
LENGTH OF CURVE	L.
EXTERNAL DISTANCE	E.
POINT OF INTERSECTION	P. I.
POINT OF CURVE	P. C.
POINT OF TANGENT	P. T.
POINT ON TANGENT	P. O. T.

SCALES

TITLE		1" = 300'
TYPICAL		1" = 2'
PLAN		1" = 50'
PROFILE	HORIZONTAL	1" = 50'
	VERTICAL	1" = 10'
CROSS SECTIONS		1" = 5'

THESE PLANS ARE SUBJECT TO SUCH REVISIONS AS MAY BE REQUIRED BY THE PUBLIC ROADS ADMINISTRATION OR THE COMMISSIONER OF HIGHWAYS.

CONSTRUCTION IS TO BE CARRIED ON IN ACCORDANCE WITH THE PLANS AND THE STANDARD ROAD AND BRIDGE SPECIFICATIONS OF 1936, AS APPROVED DECEMBER 29TH, 1936 BY THE PUBLIC ROADS ADMINISTRATION, INCLUDING ALL SUBSEQUENT APPROVED REVISIONS AND SUCH REVISED SPECIFICATIONS AND SPECIAL PROVISIONS AS ARE SUBMITTED WITH THE PLANS.

RECOMMENDED FOR APPROVAL

DISTRICT ENGINEER
PUBLIC ROADS ADMINISTRATION
FEDERAL WORKS AGENCY

APPROVED

DIVISION ENGINEER
PUBLIC ROADS ADMINISTRATION
FEDERAL WORKS AGENCY

APPROVED	APPROVED	SERIES 5 No. 222(2) FILED
HIGHWAY ENGINEER	DISTRICT HIGHWAY COMMISSIONER	SHEET 1 OF 27

~~STEARNS R. JENKINS~~

VT100

1