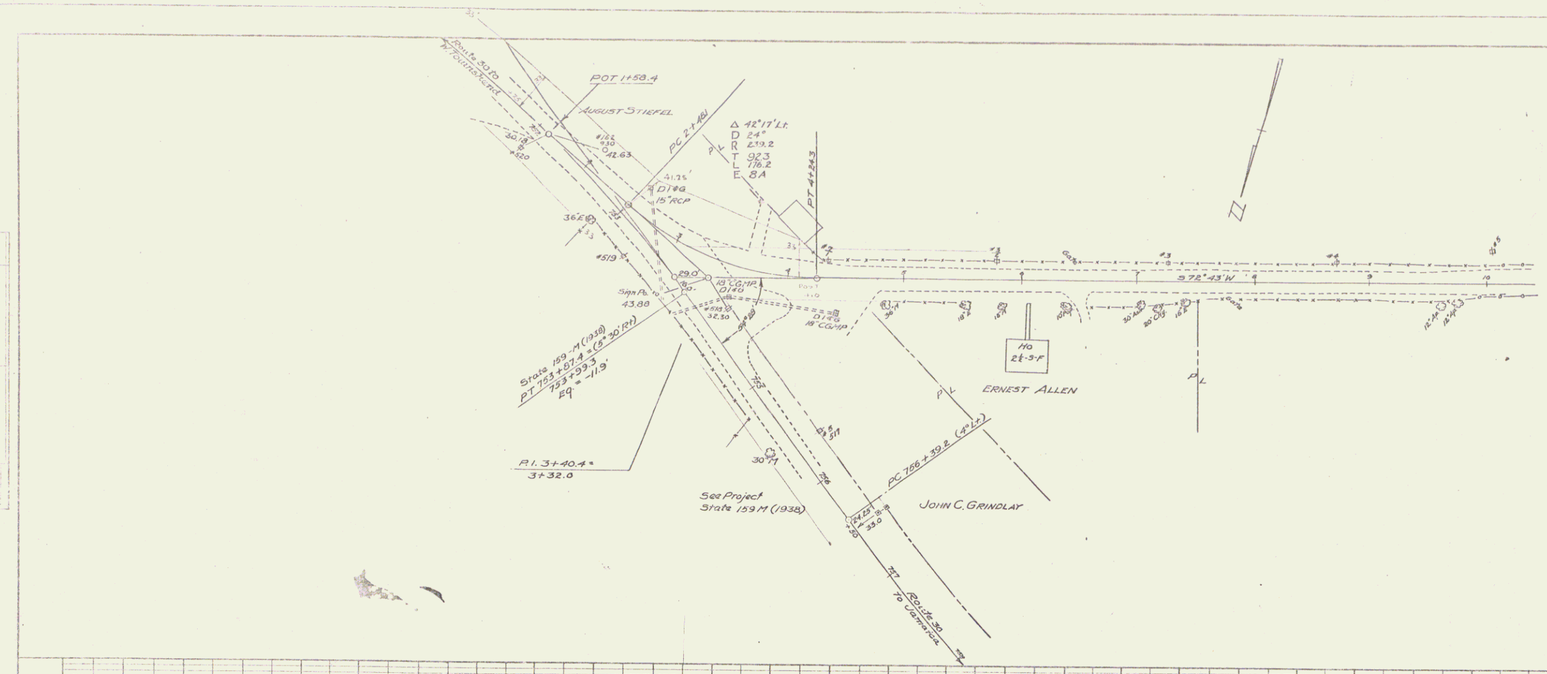
POT 1+58.4
AUGUST STIEFEL
PC 2+46
Δ 42°17' Lt.
D R T L E
24°
239.2
923
716.2
8A
PT 4+243
D18G
15" RCP
36.0
4+19
89.0
18" CGMP
D14G
Sign Pl.
43.88
State 159-M (1938)
EQ = -11.9'
P.I. 3+40.4 =
3+32.0
See Project
State 159 M (1938)
PC 7+66+39.2 (4°1.2)
JOHN C. GRINDLAY
S72°43'W
ERNEST ALLEN
P.L.
PROFILE
SCALE
VERT. 1" = 10'
HOR. 1" = 100'
VERT. BOOK
HORIZ. BOOK
DATE
BY
REVISED
BY
REVISED
BY
STRUCTURE NO. (IF ANY)
PLAN
SCALE
1" = 100'
DATE
BY
REVISED
BY
REVISED
BY
STRUCTURE NO. (IF ANY)
SERIES S NO. 2220(2)
SHEET 3 OF 27
PLATE 1 - PLAN & PROFILE C.P.R.&R.R. STANDARD
KEUFFEL & ESSER CO. NEW YORK.
K.E.Co. No. 326-1C

2