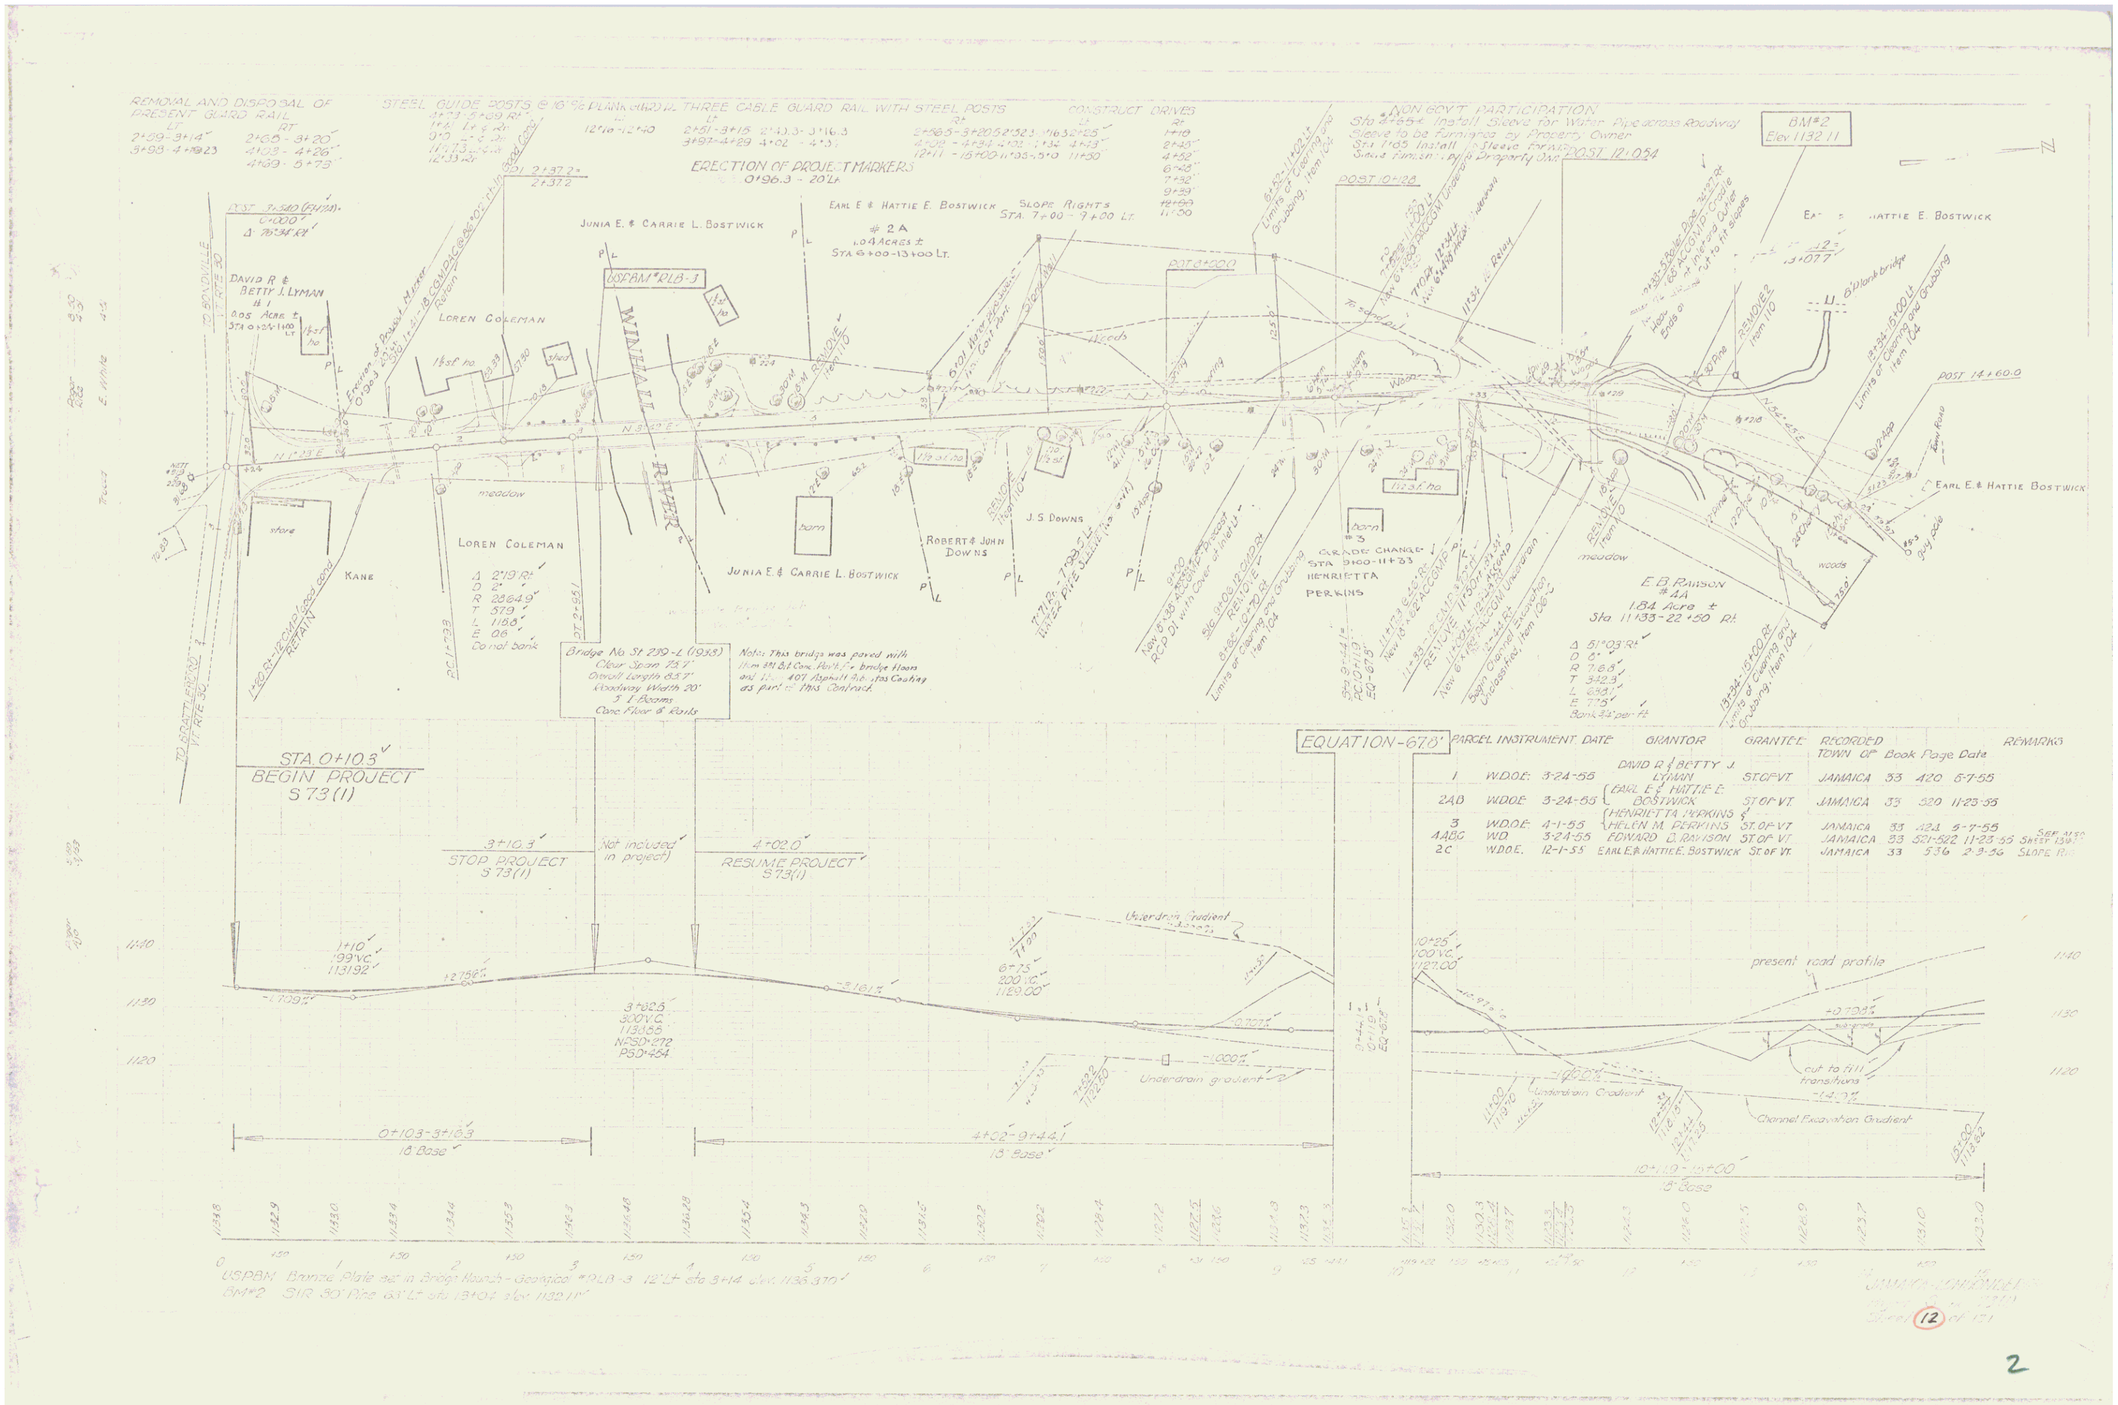


| PARCEL | INSTRUMENT | DATE | GRANTOR | GRANTEE | RECORDED TOWN | Of Book | Page | Date | REMARKS |
|---|---|---|---|---|---|---|---|---|---|
| 1 | W.D.O.E. | 3-24-55 | DAVID R & BETTY J. LYMAN | ST. OF VT. | JAMAICA | 33 | 420 | 5-7-55 | |
| 2AB | W.D.O.E. | 3-24-55 | EARL E & HATTIE E. BOSTWICK | ST. OF VT. | JAMAICA | 33 | 520 | 11-23-55 | |
| 3 | W.D.O.E. | 4-1-55 | HENRIETTA PERKINS & HELEN M. PERKINS | ST. OF VT. | JAMAICA | 33 | 424 | 5-7-55 | |
| 4ABG | W.D. | 3-24-55 | EDWARD C. RAWSON | ST. OF VT. | JAMAICA | 33 | 521-522 | 11-23-55 | SEE #450 SHEET 13 & 14 |
| 2C | W.D.O.E. | 12-1-55 | EARL E. & HATTIE E. BOSTWICK | ST. OF VT. | JAMAICA | 33 | 536 | 2-9-56 | SLOPE RIGHT |