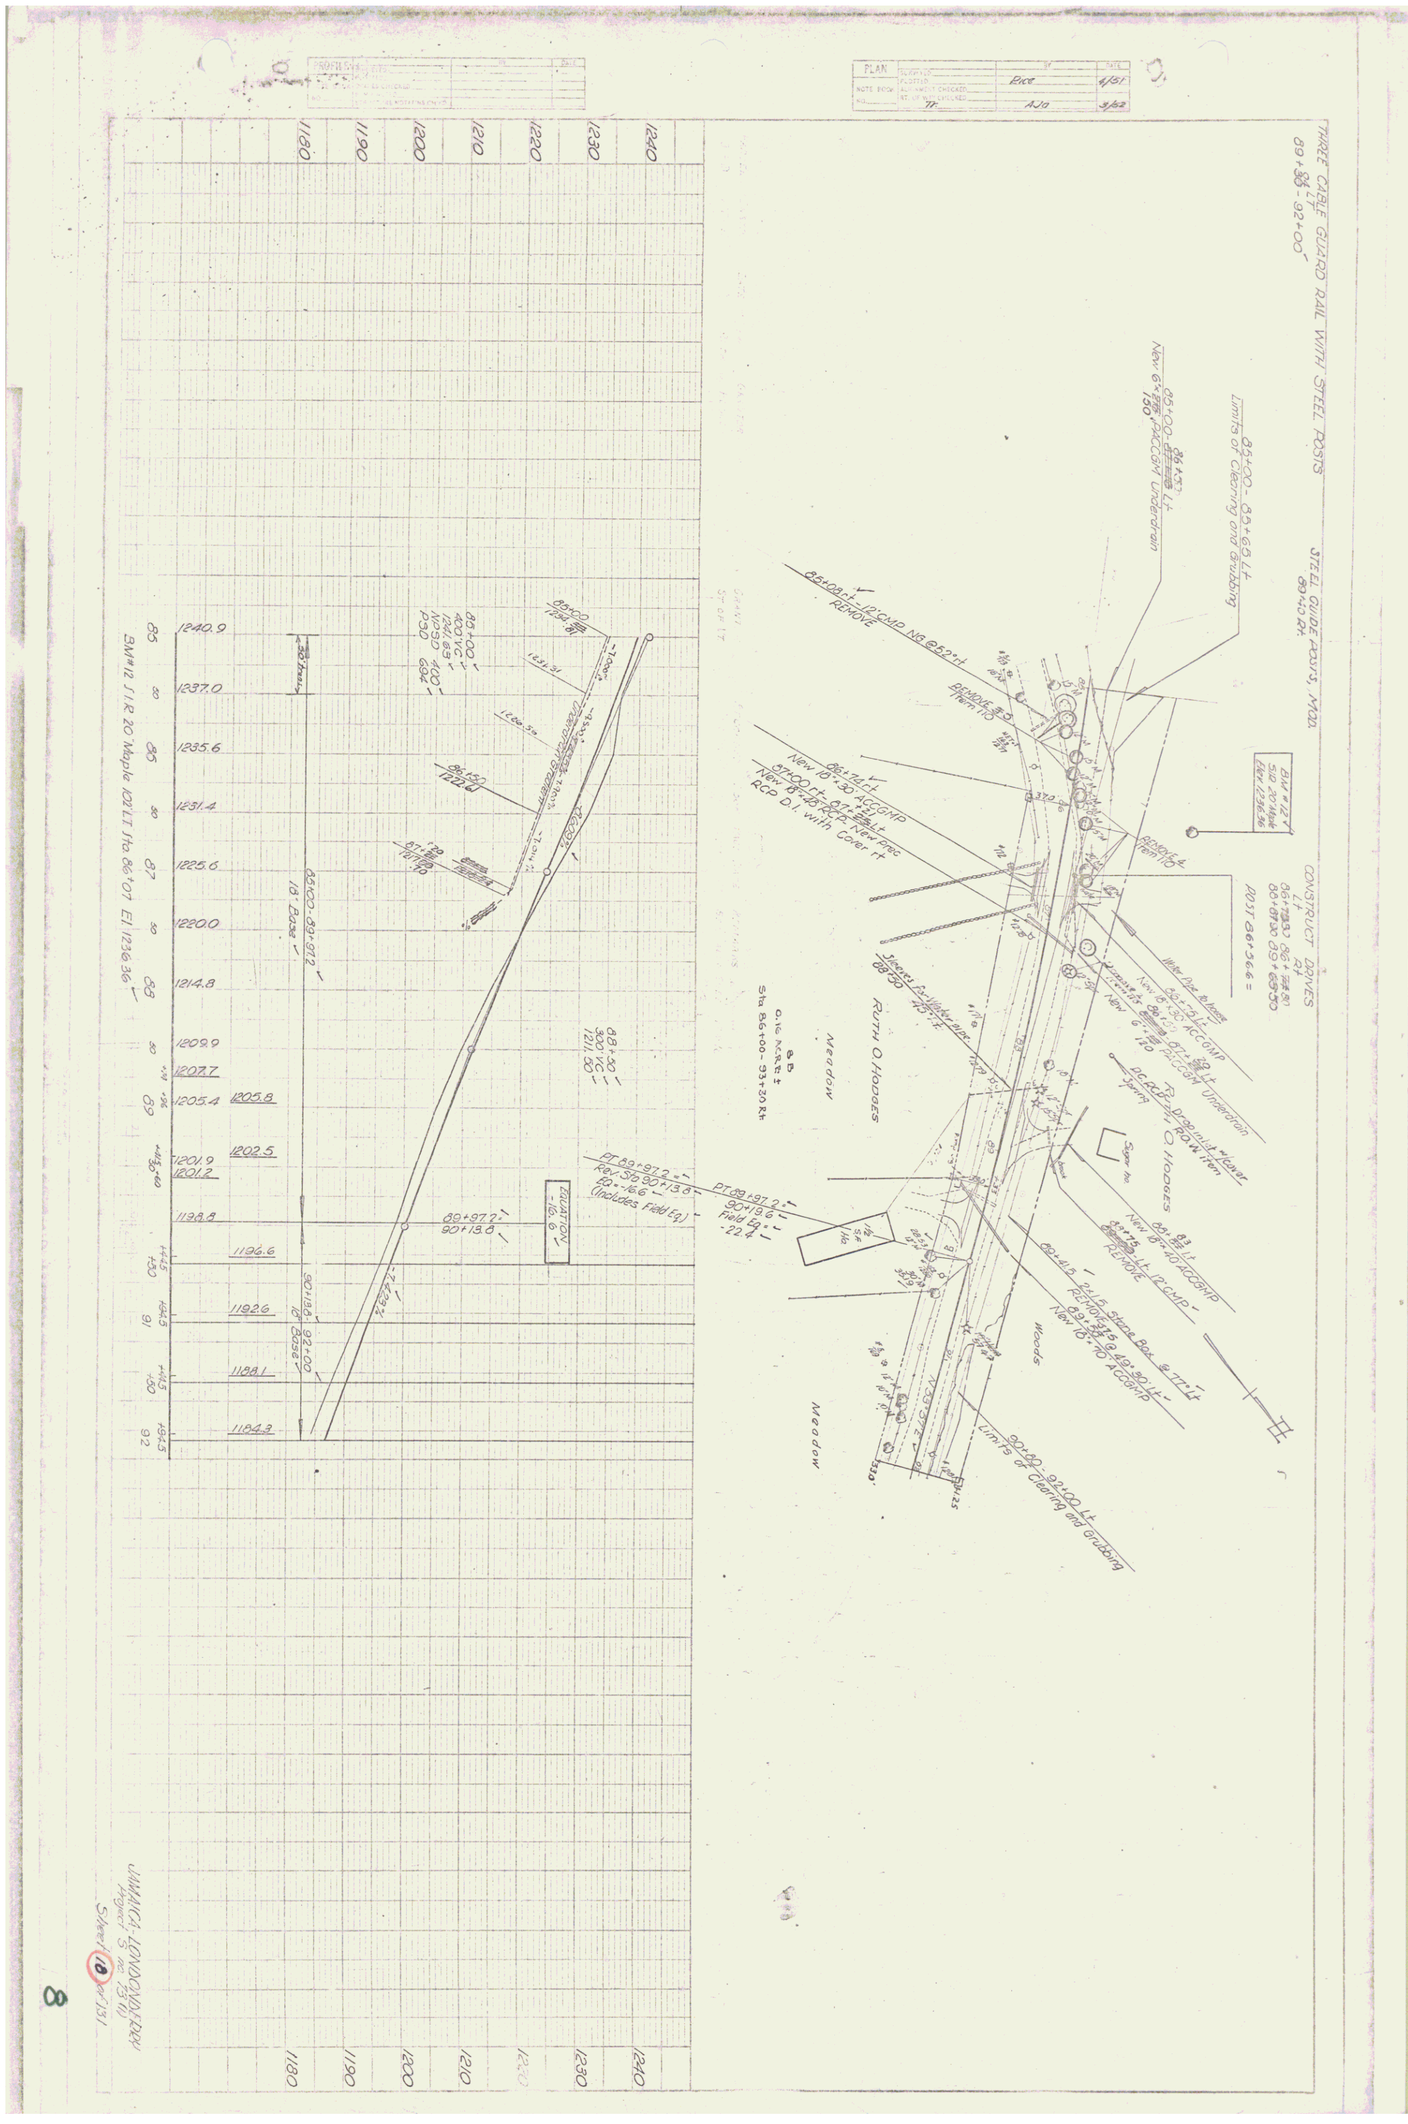
THREE CABLE GUARD RAIL WITH STEEL POSTS
89+35 - 92+00
STEEL GUIDE POSTS, MOA
89+40 Rt.
CONSTRUCT DRIVES
Limits of Clearing and Grubbing
Limits of Clearing and Grubbing
RUTH O. HODGES
Meadow
Woods
Meadow
EQUATION
BM #12 S.R. 20 Maple 101' Lt. Ho. 86+01 El. 1236.36
Sheet 10 of 131