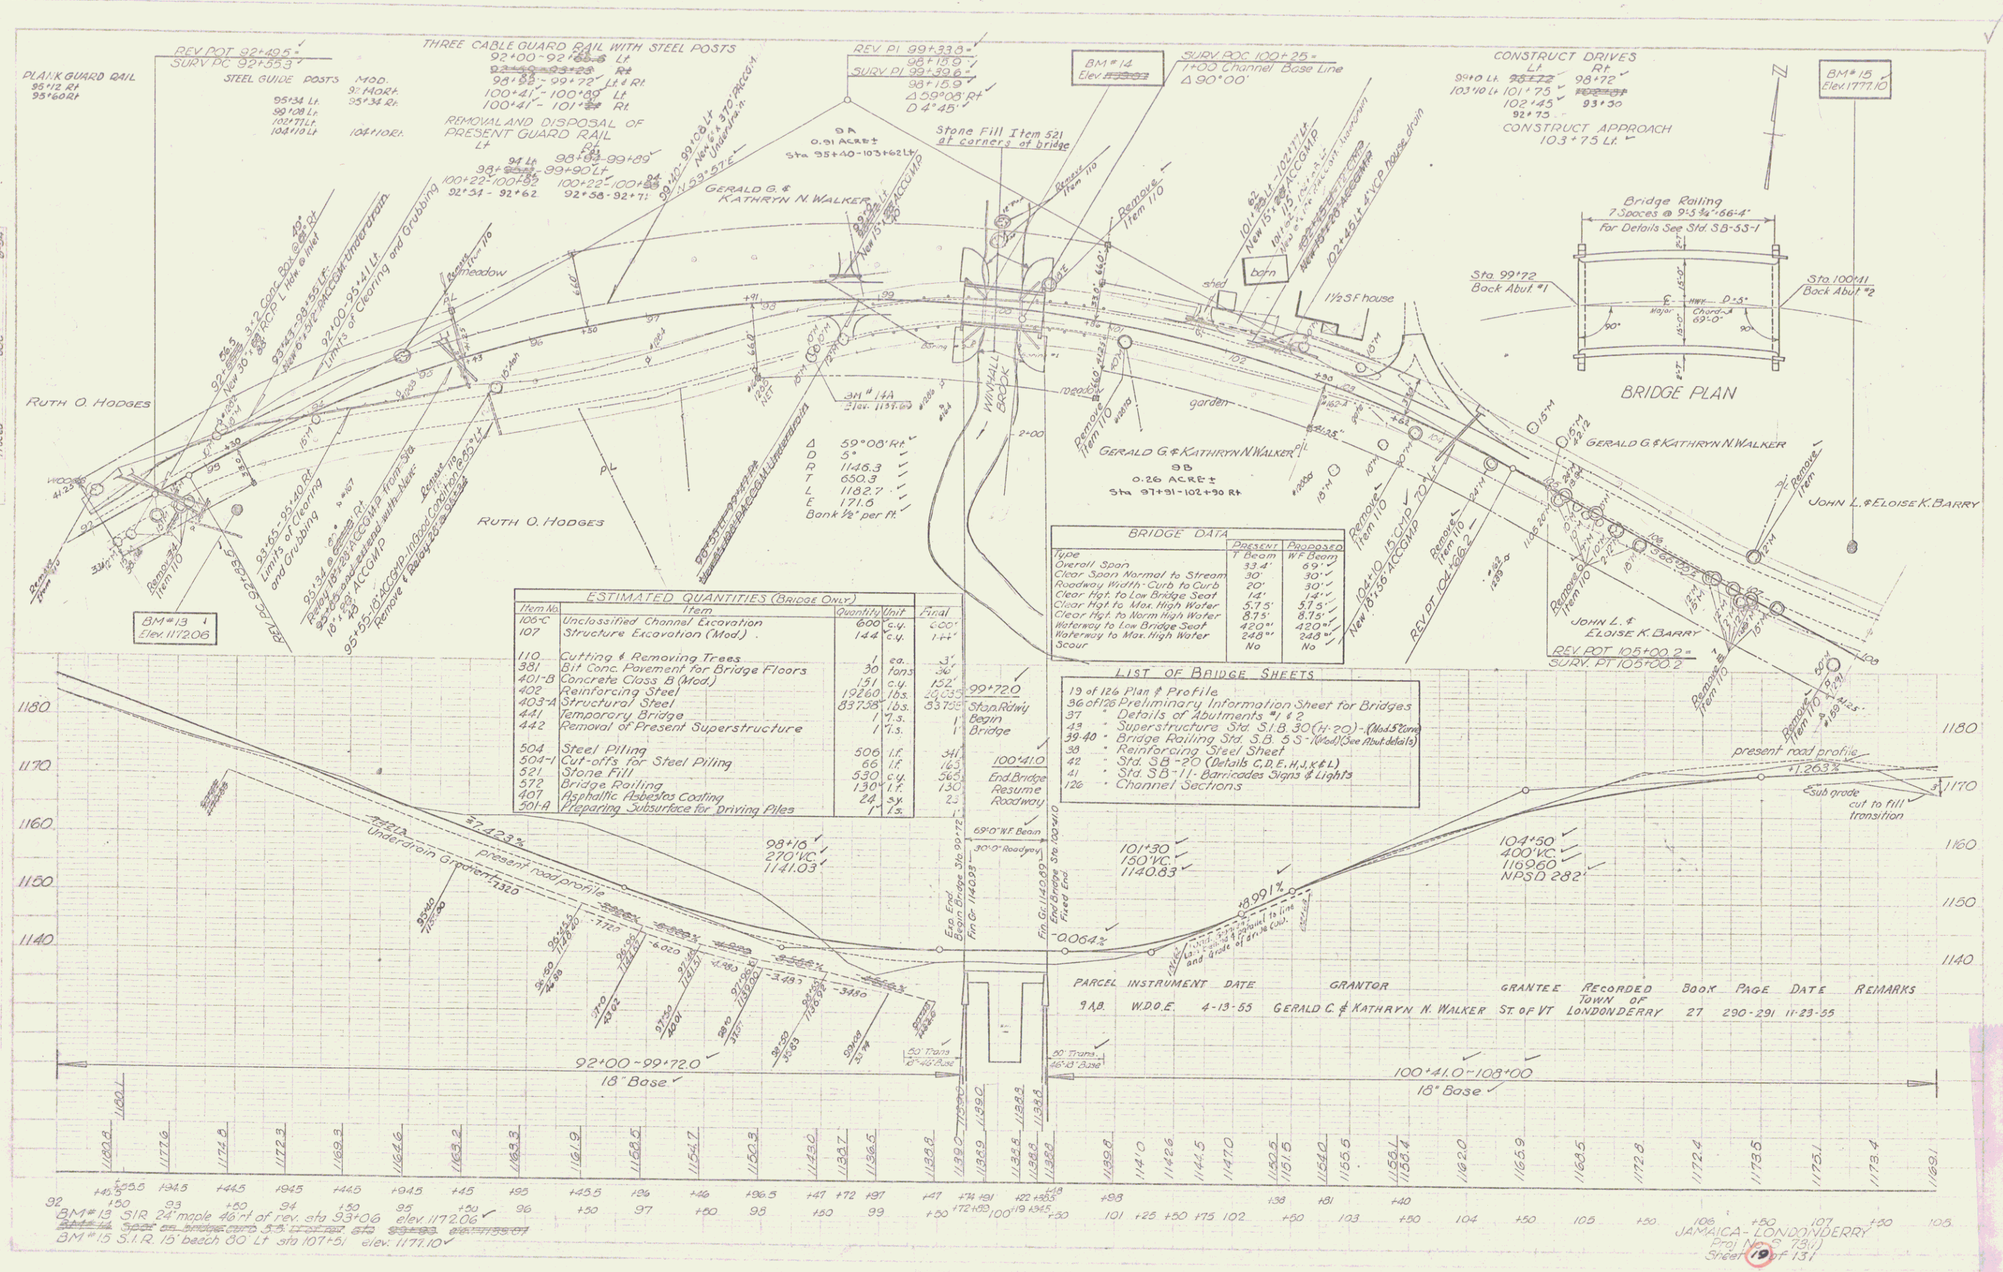

BRIDGE DATA		
	PRESENT	PROPOSED
Type	T Beam	WF Beam
Overall Span	33.4'	69'-0"
Clear Span Normal to Stream	30'	30'-0"
Roadway Width-Curb to Curb	20'	30'-0"
Clear Hgt. to Low Bridge Seat	14'	14'-0"
Clear Hgt. to Max. High Water	5.75'	5.75'
Clear Hgt. to Norm. High Water	8.75'	8.75'
Waterway to Low Bridge Seat	420 sq ft	420 sq ft
Waterway to Max. High Water	248 sq ft	248 sq ft
Scour	No	No

ESTIMATED QUANTITIES (BRIDGE ONLY)				
Item No.	Item	Quantity	Unit	Final
106-C	Unclassified Channel Excavation	600	c.y.	600
107	Structure Excavation (Mod.)	144	c.y.	144
110	Cutting & Removing Trees	1	ea.	3
381	Bit. Conc. Pavement for Bridge Floors	30	tons	36
401-B	Concrete Class B (Mod.)	151	c.y.	152
402	Reinforcing Steel	19260	lbs.	20,035
403-A	Structural Steel	83738	lbs.	83,738
441	Temporary Bridge	1	l.s.	1
442	Removal of Present Superstructure	1	l.s.	1
504	Steel Piling	506	l.f.	341
504-1	Cut-offs for Steel Piling	66	l.f.	165
521	Stone Fill	530	c.y.	565
572	Bridge Railing	130	l.f.	130
407	Asphaltic Asbestos Coating	24	s.y.	22
501-A	Preparing Subsurface for Driving Piles	1	l.s.	1

LIST OF BRIDGE SHEETS

19 of 126	Plan & Profile
36 of 126	Preliminary Information Sheet for Bridges
37	Details of Abutments #1 & 2
43	Superstructure Std. S.I.B. 30 (H-20) - (Mod. 5 Cons)
39-40	Bridge Railing Std. S.B. 53-1 (Mod) (See Abut. details)
38	Reinforcing Steel Sheet
42	Std. SB-20 (Details C, D, E, H, J, K & L)
41	Std. SB-11 - Barricades Signs & Lights
126	Channel Sections

PARCEL	INSTRUMENT	DATE	GRANTOR	GRANTEE	RECORDED TOWN OF	BOOK	PAGE	DATE	REMARKS
9.A.B.	W.D.O.E.	4-13-55	GERALD C. & KATHRYN N. WALKER	ST. OF VT	LONDONDERRY	27	290-291	11-23-55	