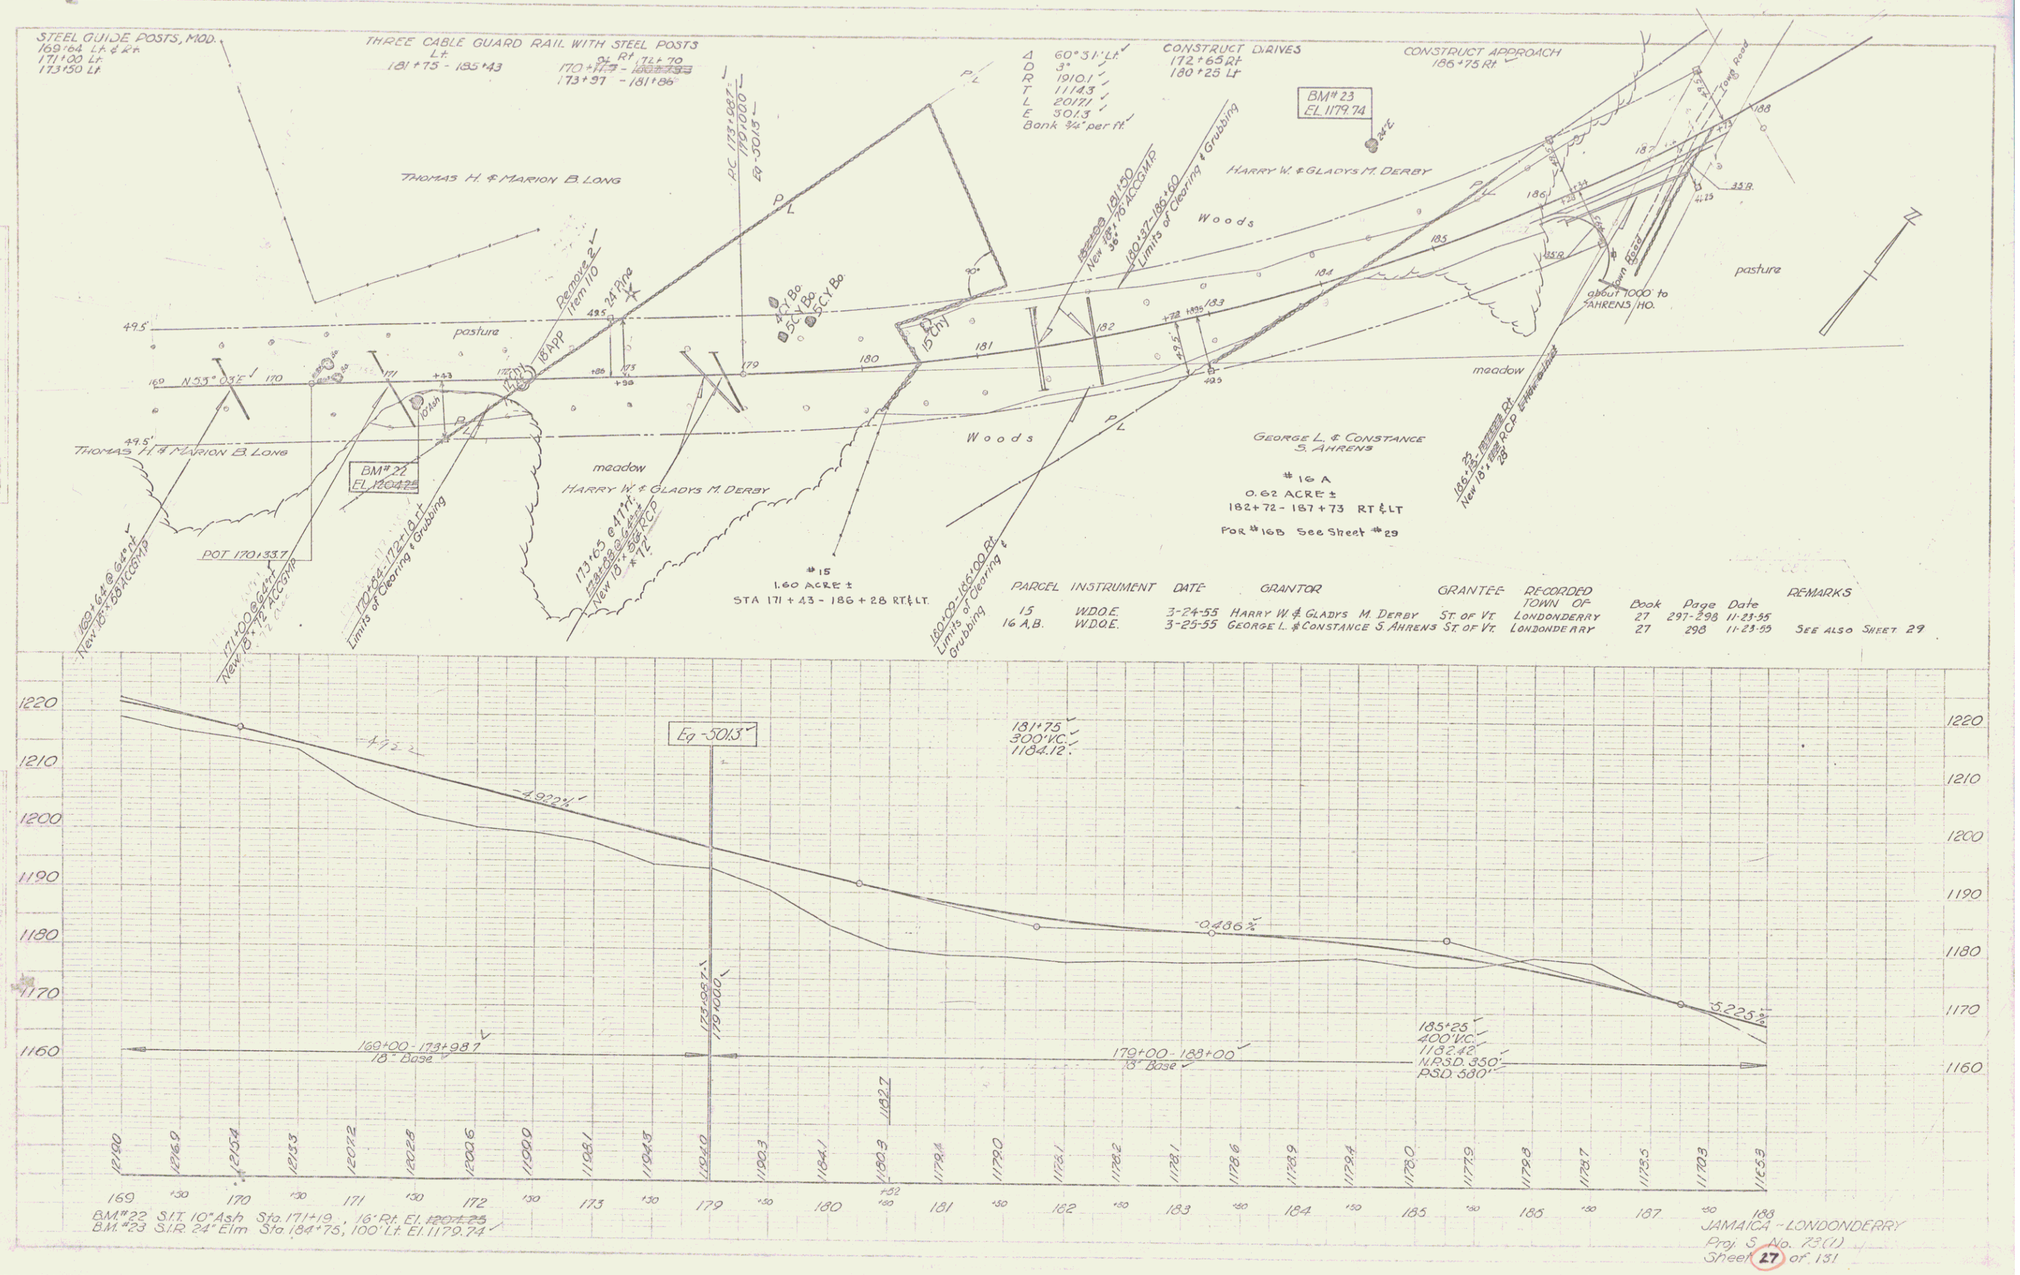
STEEL GUIDE POSTS, MOD.
169+64 Lt. & Rt.
171+00 Lt.
173+50 Lt.
THREE CABLE GUARD RAIL WITH STEEL POSTS
Lt. 181+75 - 185+43
Rt 171+70 - 173+97
CONSTRUCT DRIVES
172+65 Rt
180+25 Lt
CONSTRUCT APPROACH
186+75 Rt
A 60° 31' Lt.
D 3°
R 1910.1'
T 1114.3'
L 2017.1'
E 301.3'
Bank 3/4" per ft.
BM# 23
EL 1179.74
THOMAS H. & MARION B. LONG
HARRY W. & GLADYS M. DERBY
Woods
pastura
meadow
about 1000' to AHRENS HO.
Town Road
GEORGE L. & CONSTANCE S. AHRENS
#16 A
0.62 ACRE ±
182+72 - 187+73 RT & LT
For #16B See Sheet #29
#15
1.60 ACRE ±
STA 171+43 - 186+28 RT & LT.
BM# 22
EL 1207.25
POT 170+33.7
Eq -301.3'
181+75
300' VC
1184.12'
-1.922%
-0.486%
-5.225%
185+25
400' VC
1182.42'
M.P.S.D. 350'
P.S.D. 580'
169+00 - 173+98.7
18" Base
179+00 - 188+00
18" Base
PARCEL INSTRUMENT DATE GRANTOR GRANTEE RECORDED TOWN OF Book Page Date REMARKS
15 W.D.O.E. 3-24-55 HARRY W. & GLADYS M. DERBY ST. OF VT. LONDONDERRY 27 297-298 11-23-55
16 A.B. W.D.O.E. 3-25-55 GEORGE L. & CONSTANCE S. AHRENS ST. OF VT. LONDONDERRY 27 298 11-23-55 SEE ALSO SHEET 29
BM# 22 S.I.T. 10" Ash Sta. 171+19, 16' Rt. El. 1207.25
BM# 23 S.I.R. 24" Elm Sta. 184+75, 100' Lt. El. 1179.74
JAMAICA - LONDONDERRY
Proj. S No. 73(1)
Sheet 27 of 131