


WEBSTER-MARTIN INC. 6-57  
 WEBSTER-MARTIN INC. 6-57  
 JUN 1957

WEBSTER-MARTIN INC. 6-57  
 WEBSTER-MARTIN INC. 6-57

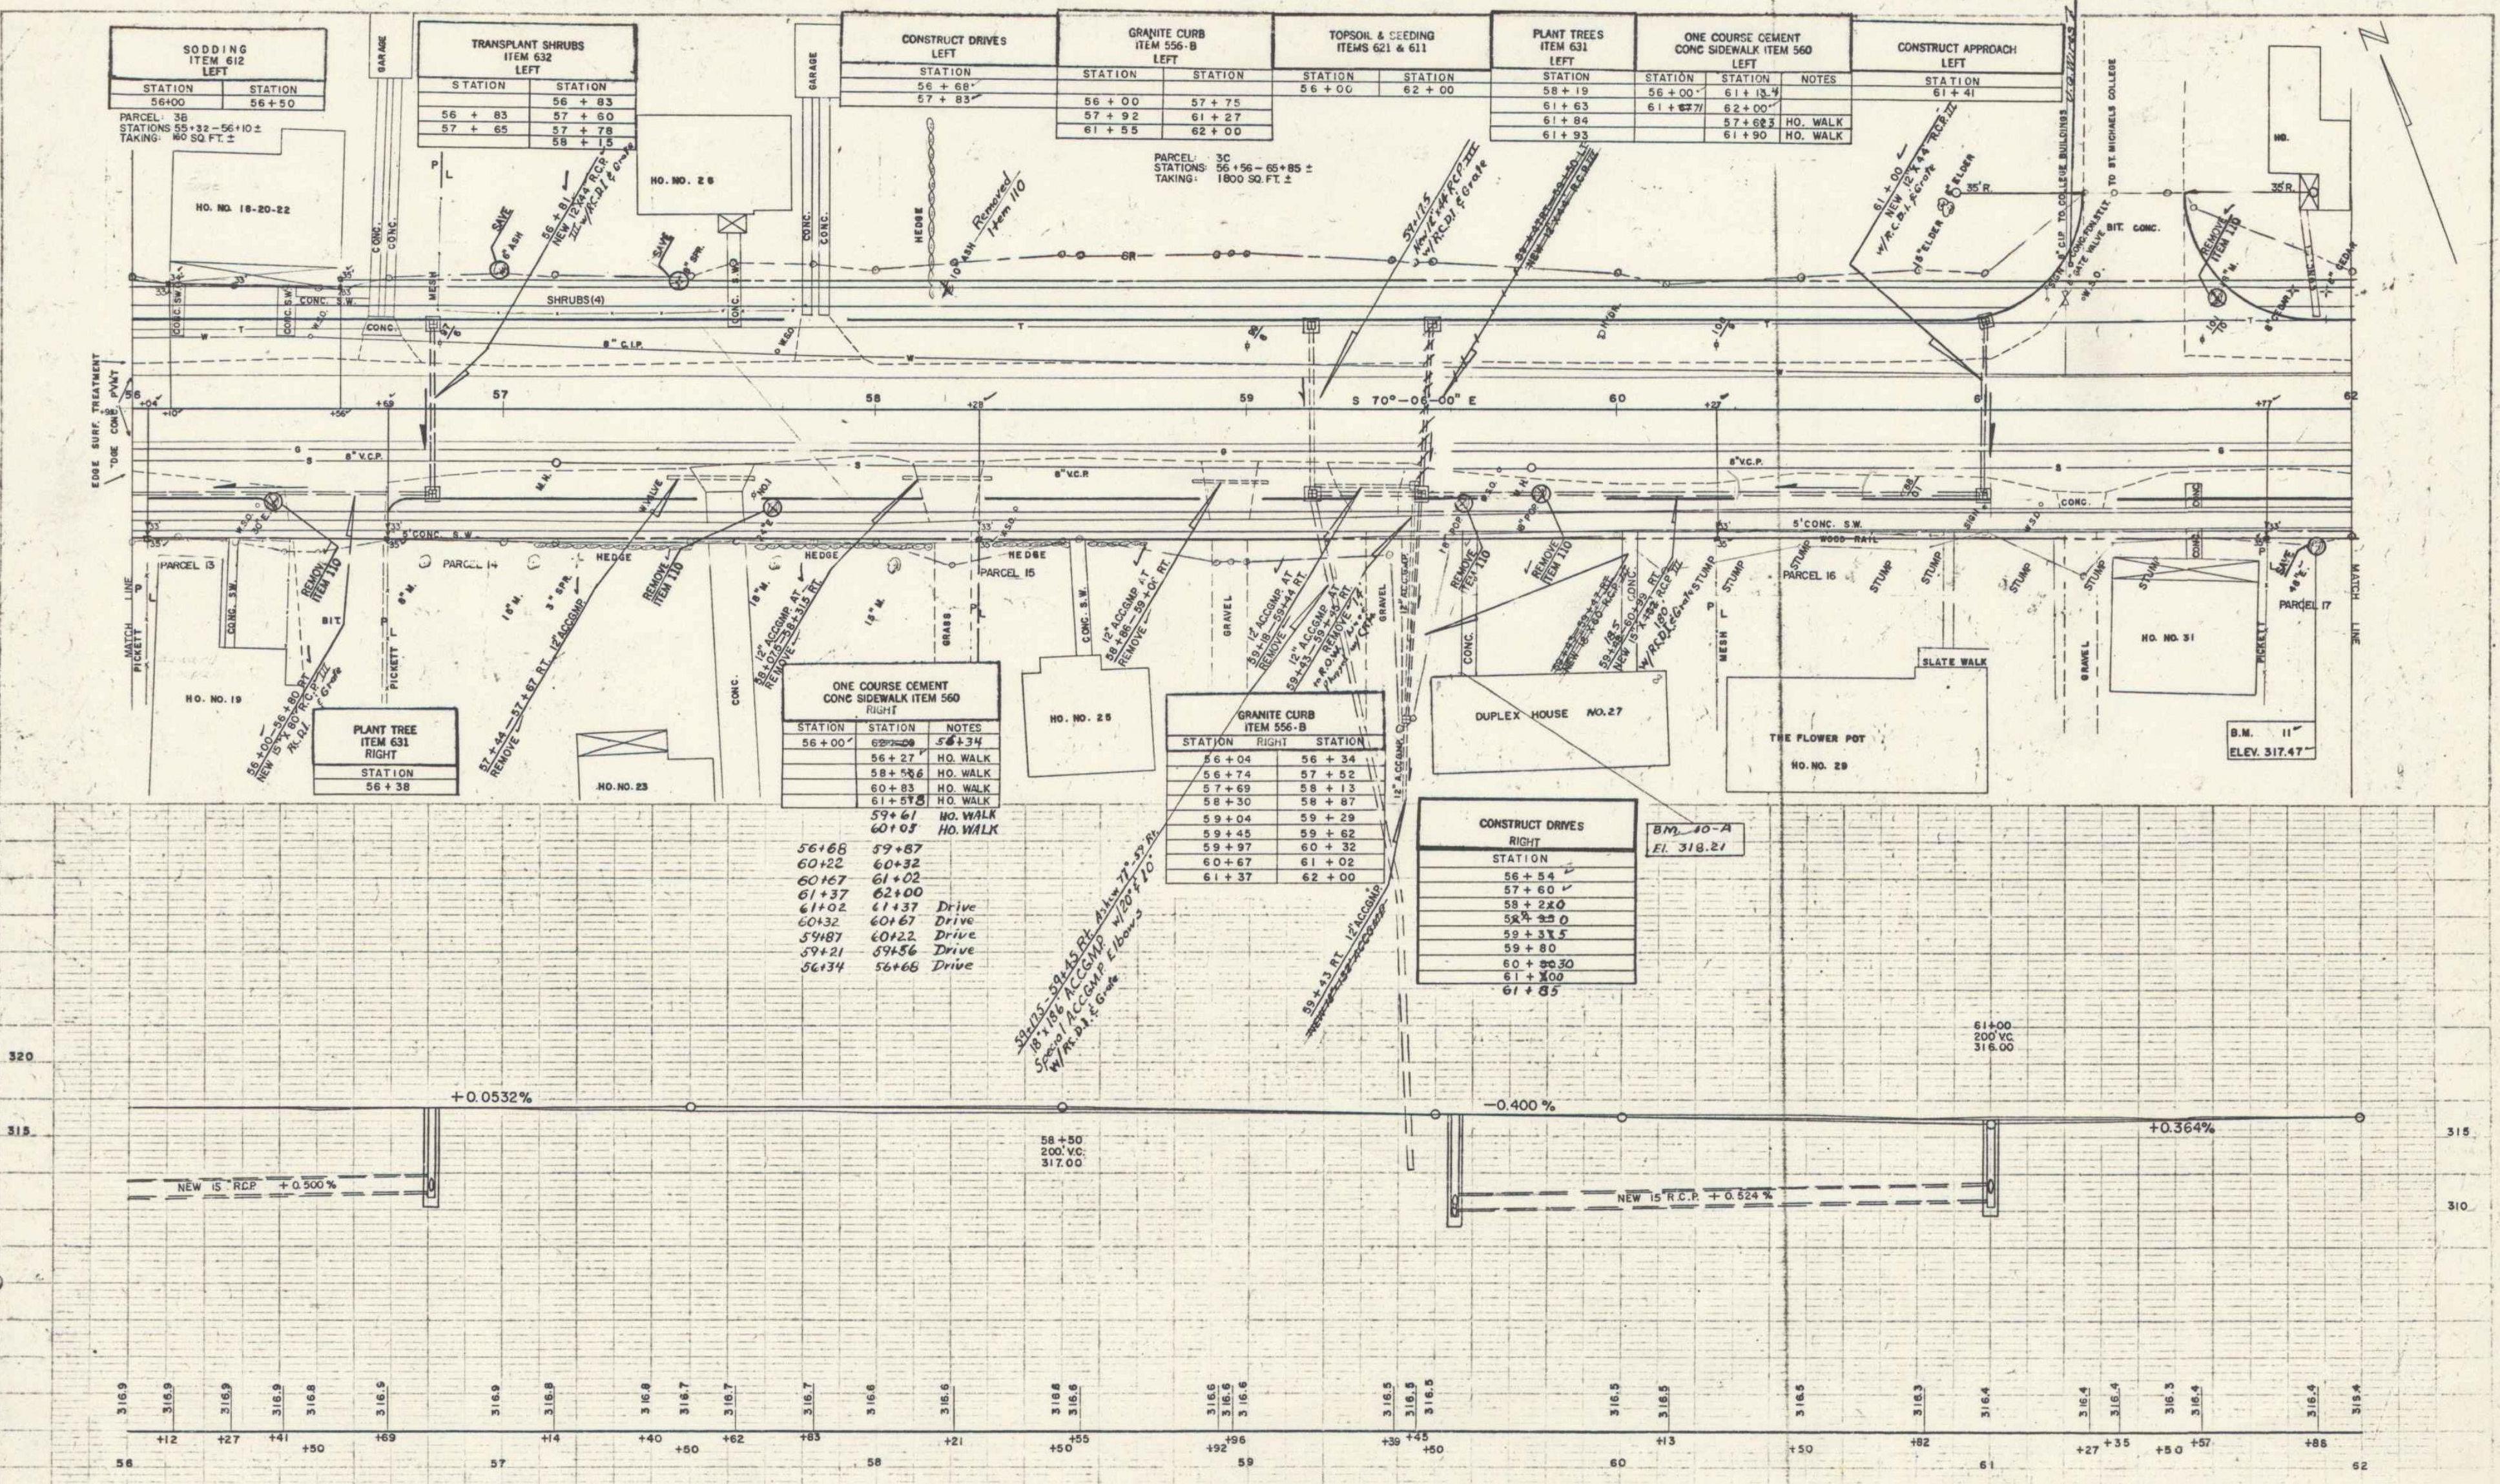

STATION	STATION	NOTES
56+68	59+87	
60+22	60+32	
60+67	61+02	
61+37	62+00	
61+02	61+37	Drive
60+32	60+67	Drive
59+87	60+22	Drive
59+21	59+56	Drive
56+134	56+68	Drive

STATION	STATION	NOTES
56+04	56+34	
56+74	57+52	
57+69	58+13	
58+30	58+87	
59+04	59+29	
59+45	59+62	
59+97	60+32	
60+67	61+02	
61+37	62+00	

