


WESTER-MARTIN INC. 6-87
7-87
WESTER-MARTIN INC.
6-87
7-87

WESTER-MARTIN INC. 6-87
7-87
WESTER-MARTIN INC.
6-87
7-87

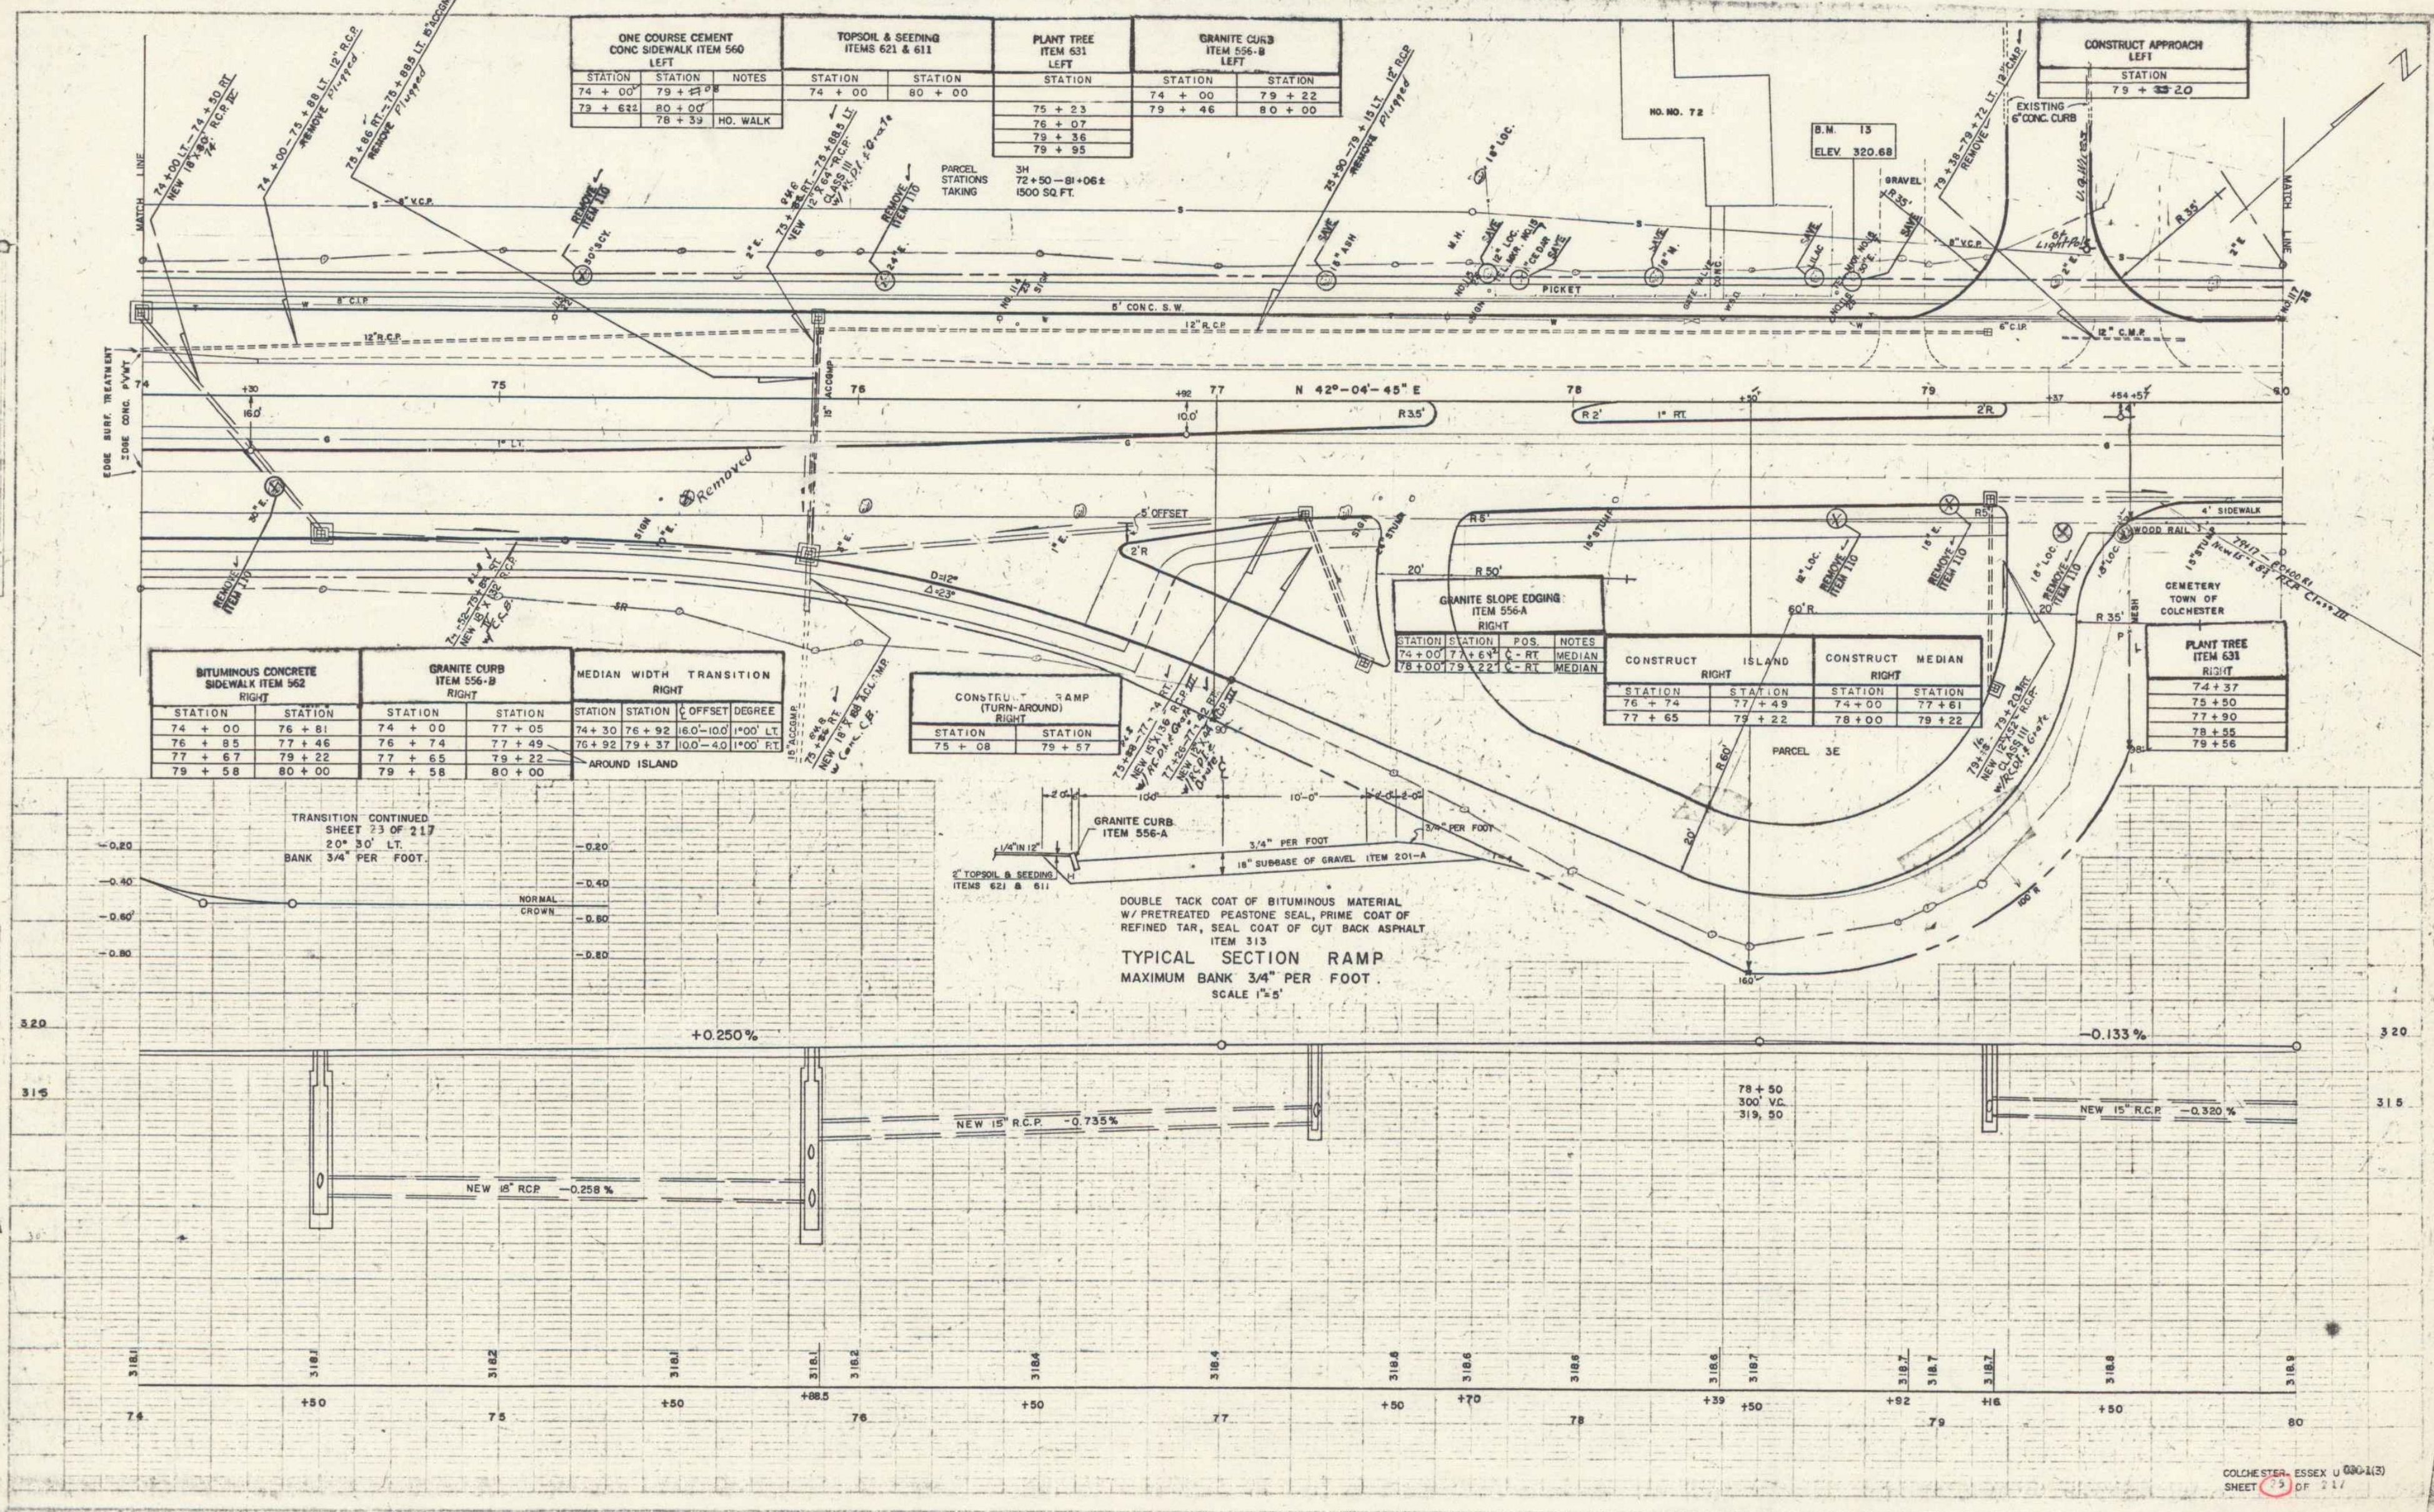

ONE COURSE CEMENT CONC SIDEWALK ITEM 560 LEFT			TOPSOIL & SEEDING ITEMS 621 & 611		PLANT TREE ITEM 631 LEFT		GRANITE CURB ITEM 556-B LEFT		
STATION	STATION	NOTES	STATION	STATION	STATION	STATION	STATION	STATION	STATION
74 + 00	79 + 21		74 + 00	80 + 00	75 + 23	74 + 00	79 + 22		
79 + 61	80 + 00	HO. WALK			76 + 07	79 + 46	80 + 00		
					79 + 36				
					79 + 95				

BITUMINOUS CONCRETE SIDEWALK ITEM 562 RIGHT		GRANITE CURB ITEM 556-B RIGHT		MEDIAN WIDTH TRANSITION RIGHT		
STATION	STATION	STATION	STATION	STATION	STATION	OFFSET DEGREE
74 + 00	76 + 81	74 + 00	77 + 05	74 + 30	76 + 92	10.0'-10.0' 100° LT.
76 + 85	77 + 46	76 + 74	77 + 49	76 + 92	79 + 37	10.0'-4.0' 100° RT.
77 + 67	79 + 22	77 + 65	79 + 22			
79 + 58	80 + 00	79 + 58	80 + 00			

CONSTRUCT RAMP (TURN-AROUND) RIGHT	
STATION	STATION
75 + 08	79 + 57

CONSTRUCT ISLAND RIGHT		CONSTRUCT MEDIAN RIGHT	
STATION	STATION	STATION	STATION
76 + 74	77 + 49	74 + 00	77 + 61
77 + 65	79 + 22	78 + 00	79 + 22

PLANT TREE ITEM 631 RIGHT	
STATION	STATION
74 + 37	
75 + 50	
77 + 90	
78 + 35	
79 + 56	

DOUBLE TACK COAT OF BITUMINOUS MATERIAL W/ PRETREATED PEASTONE SEAL, PRIME COAT OF REFINED TAR, SEAL COAT OF CUT BACK ASPHALT ITEM 313
TYPICAL SECTION RAMP
MAXIMUM BANK 3/4" PER FOOT
SCALE 1"=5'

B.M. 13 S.I.R. 30' ELM 35.5' LT. STA 78 + 79 ELEV 320.68