

ONE COURSE CEMENT CONC SIDWALK ITEM 560 LEFT		
STATION	STATION	
86+90	88+68.2	
89+23.7	92+07.5	
JOHNSON AVE		
STATION	STATION	NOTES
86+00	87+00	
	86+40	HOWALK
	86+66	HOWALK
	87+55	BUS STOP
	88+28	
	89+00	

TOPSOIL & SEEDING ITEMS 621 & 611		
STATION	STATION	
86+00	92+00	


GRANITE CURB ITEM 556-B LEFT		
STATION	STATION	
86+25	88+77	
89+12	90+71	
91+11	91+38	
91+76	92+00	
JOHNSON AVE		
STATION	STATION	POS.
86+00	86+24	LT.
86+25	88+77	RT.
86+41	86+85	LT.
87+02	87+70	LT.
87+87	88+37	LT.
88+54	88+66	LT.
88+83	89+21	LT.
89+12	89+41	RT.

CONSTRUCT ISLAND LEFT		
STATION	STATION	
86+25	88+77	


TRANSPLANT SHRUBS ITEM 632 LEFT			
STATION	STATION	NOTES	
88+80	88+90	JOHNSON AVE	
89+01	89+03		

CONSTRUCT APPROACH LEFT		
STATION	STATION	
88+93		

CONSTRUCT DRIVE LEFT		
STATION	STATION	
90+00	90+60	
91+56		
JOHNSON AVE		
86+24	87+40	
87+28	88+00	
87+28	88+25	
88+45		
88+77		
89+40		

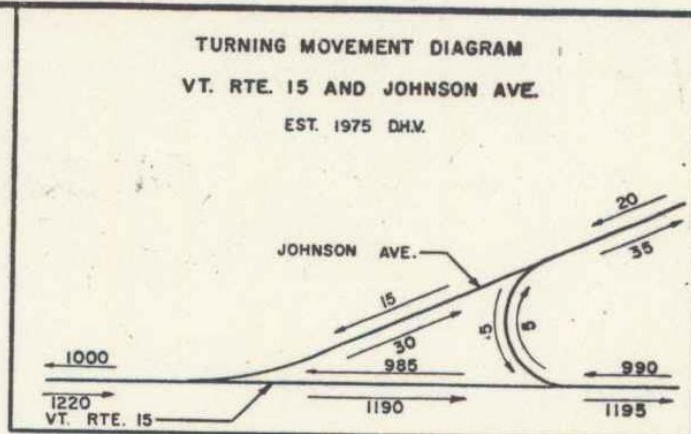

PARCEL 30
GRANTOR ALLEN CORPORATION
STATIONS 91+33-92+82+
TAKING 1100 SQ. FT.
REMAINDER 0.3 A I
RIGHTS: SLOPE-ST. 91+33-92+82+(1000SQ.FT.)
TITLE TAKEN COND 4/30/62
RECORDED COLCHESTER SERVICE
BK 12 PS 120-132 5/10/62

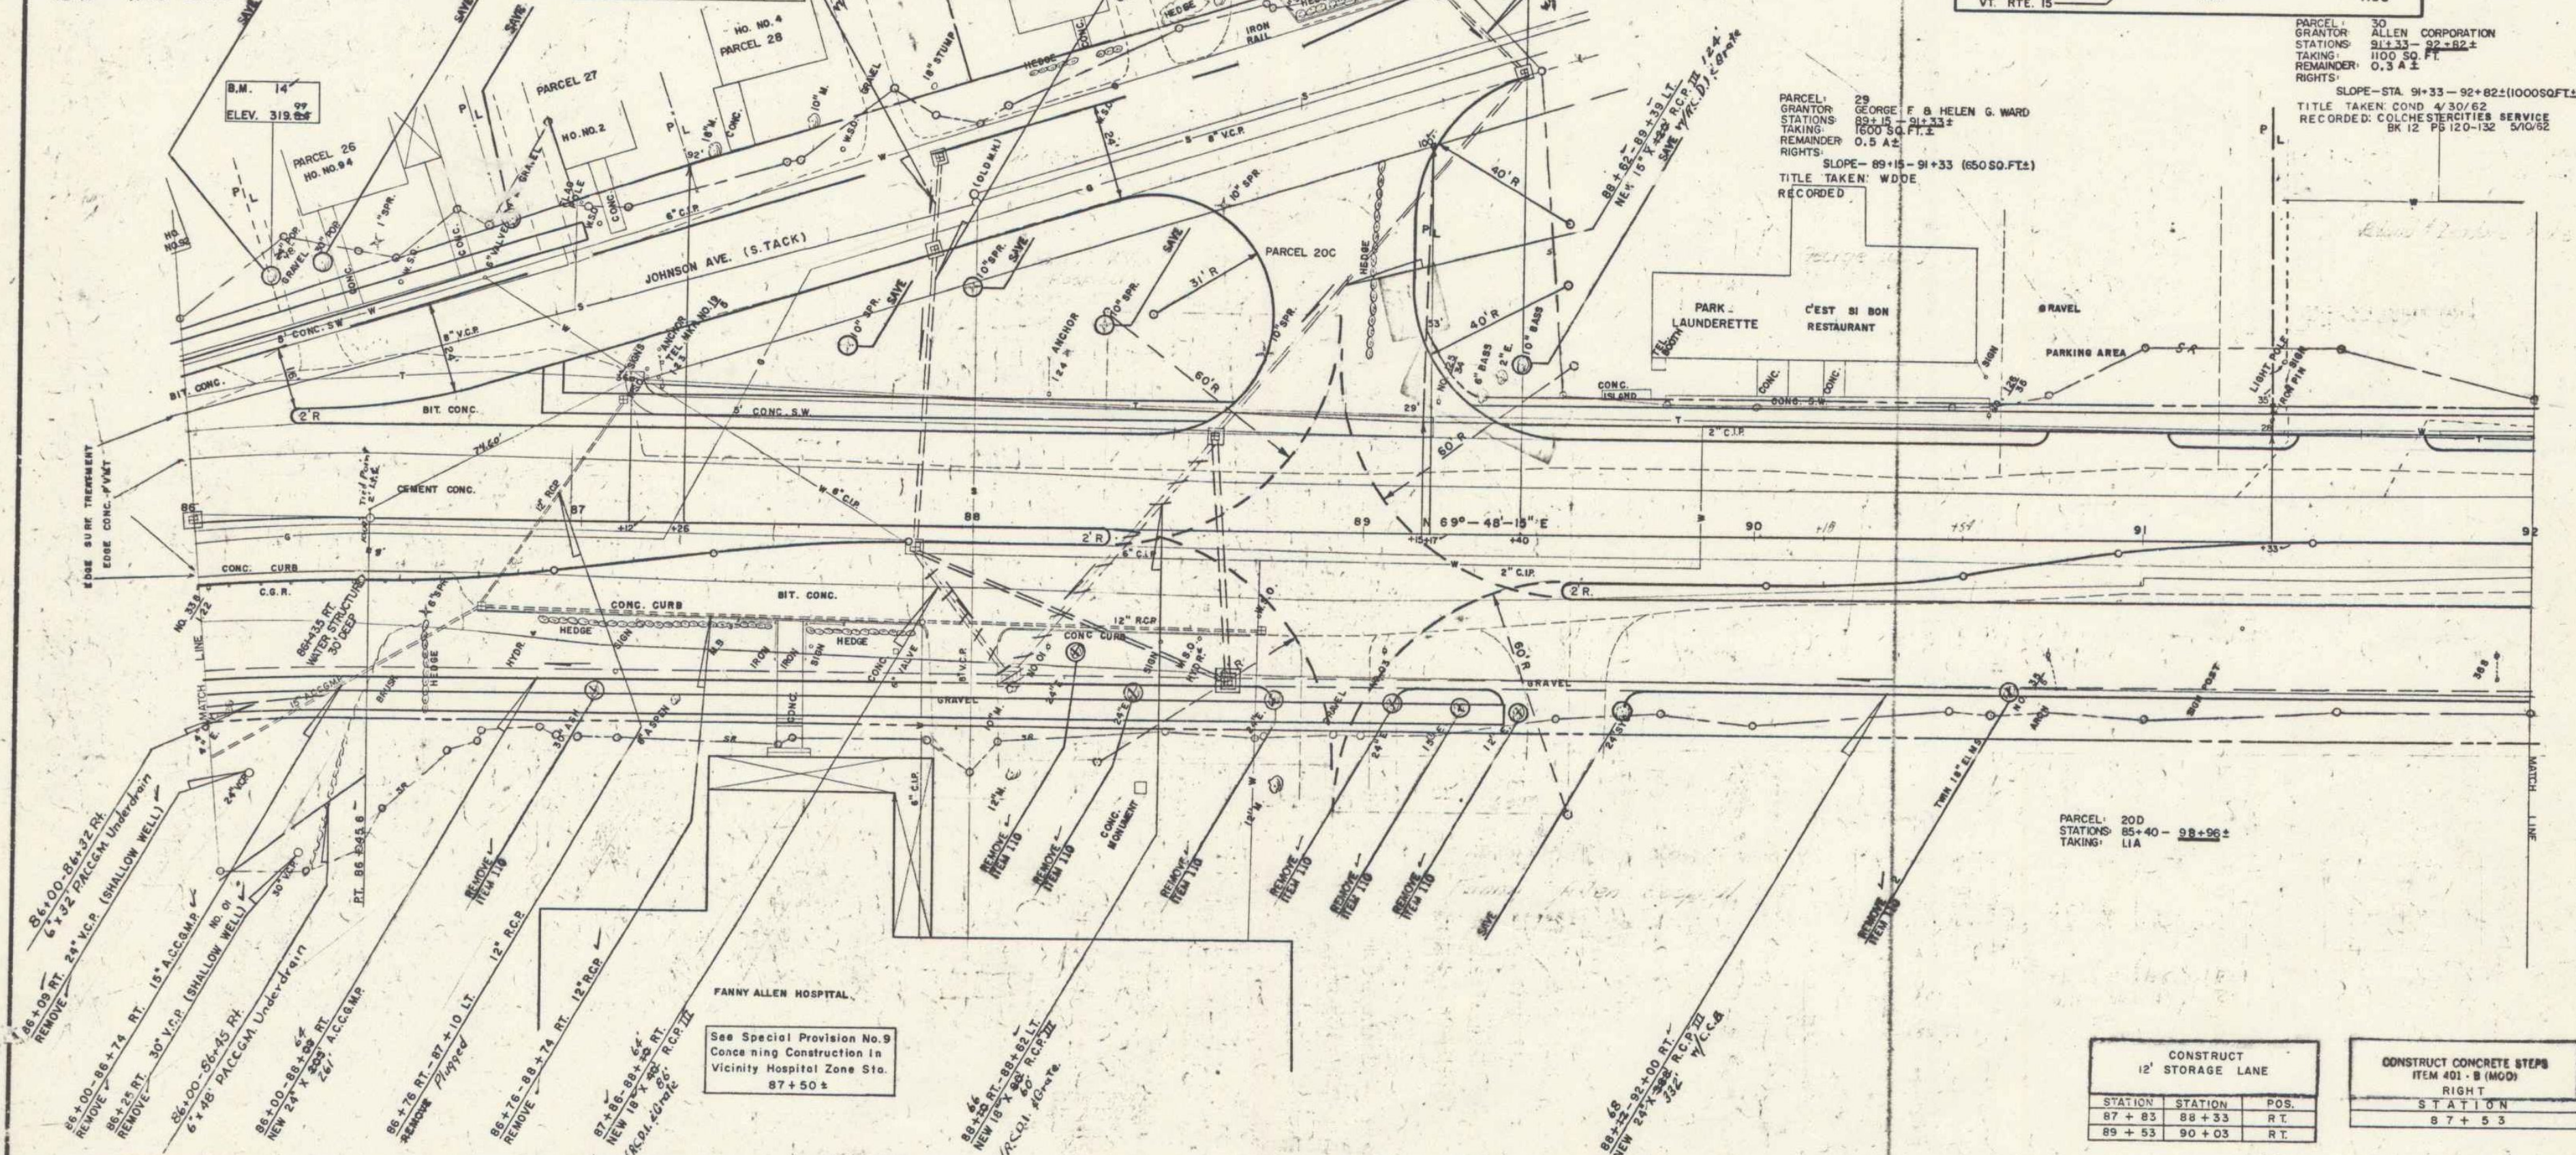

ONE COURSE CEMENT CONC SIDWALK ITEM 560 RIGHT		
STATION	STATION	NOTES
87+53	88+00	HOWALK

BITUMINOUS CONCRETE SIDWALK ITEM 562 RIGHT		
STATION	STATION	
86+00	89+37	

GRANITE CURB ITEM 556-B RIGHT		
STATION	STATION	
86+00	87+91	
88+08	88+73	
89+13	89+32	
89+72	92+00	

GRANITE SLOPE EDGING ITEM 556-B RIGHT		
STATION	STATION	
86+00	88+35	
89+53	92+00	

THREE CABLE GUARD RAIL WITH STEEL POSTS ITEM 543 RIGHT		
STATION	STATION	
86+00	86+50	

CONSTRUCT MEDIAN RIGHT		
STATION	STATION	
86+00	88+33	
89+51	92+00	

CONSTRUCT DRIVE RIGHT		
STATION	STATION	
88+00	88+00	
88+25	88+25	
89+50	89+50	

REMOVAL & DISPOSAL OF PRESENT GUARD RAIL ITEM 550 RIGHT		
STATION	STATION	
86+00	86+57	

PLANT TREE ITEM 631 RIGHT		
STATION	STATION	
86+60	88+42	
87+04	88+55	
87+25	89+23	
87+60		

TRANSPLANT SHRUBS ITEM 632 RIGHT		
STATION	STATION	
86+60		
86+89	87+49	
87+57	87+65	