


WESTER-MARTIN INC.
 6-87
 1070 N. 10th St.
 MILWAUKEE, WIS. 53233

WESTER-MARTIN INC.
 6-87
 1070 N. 10th St.
 MILWAUKEE, WIS. 53233

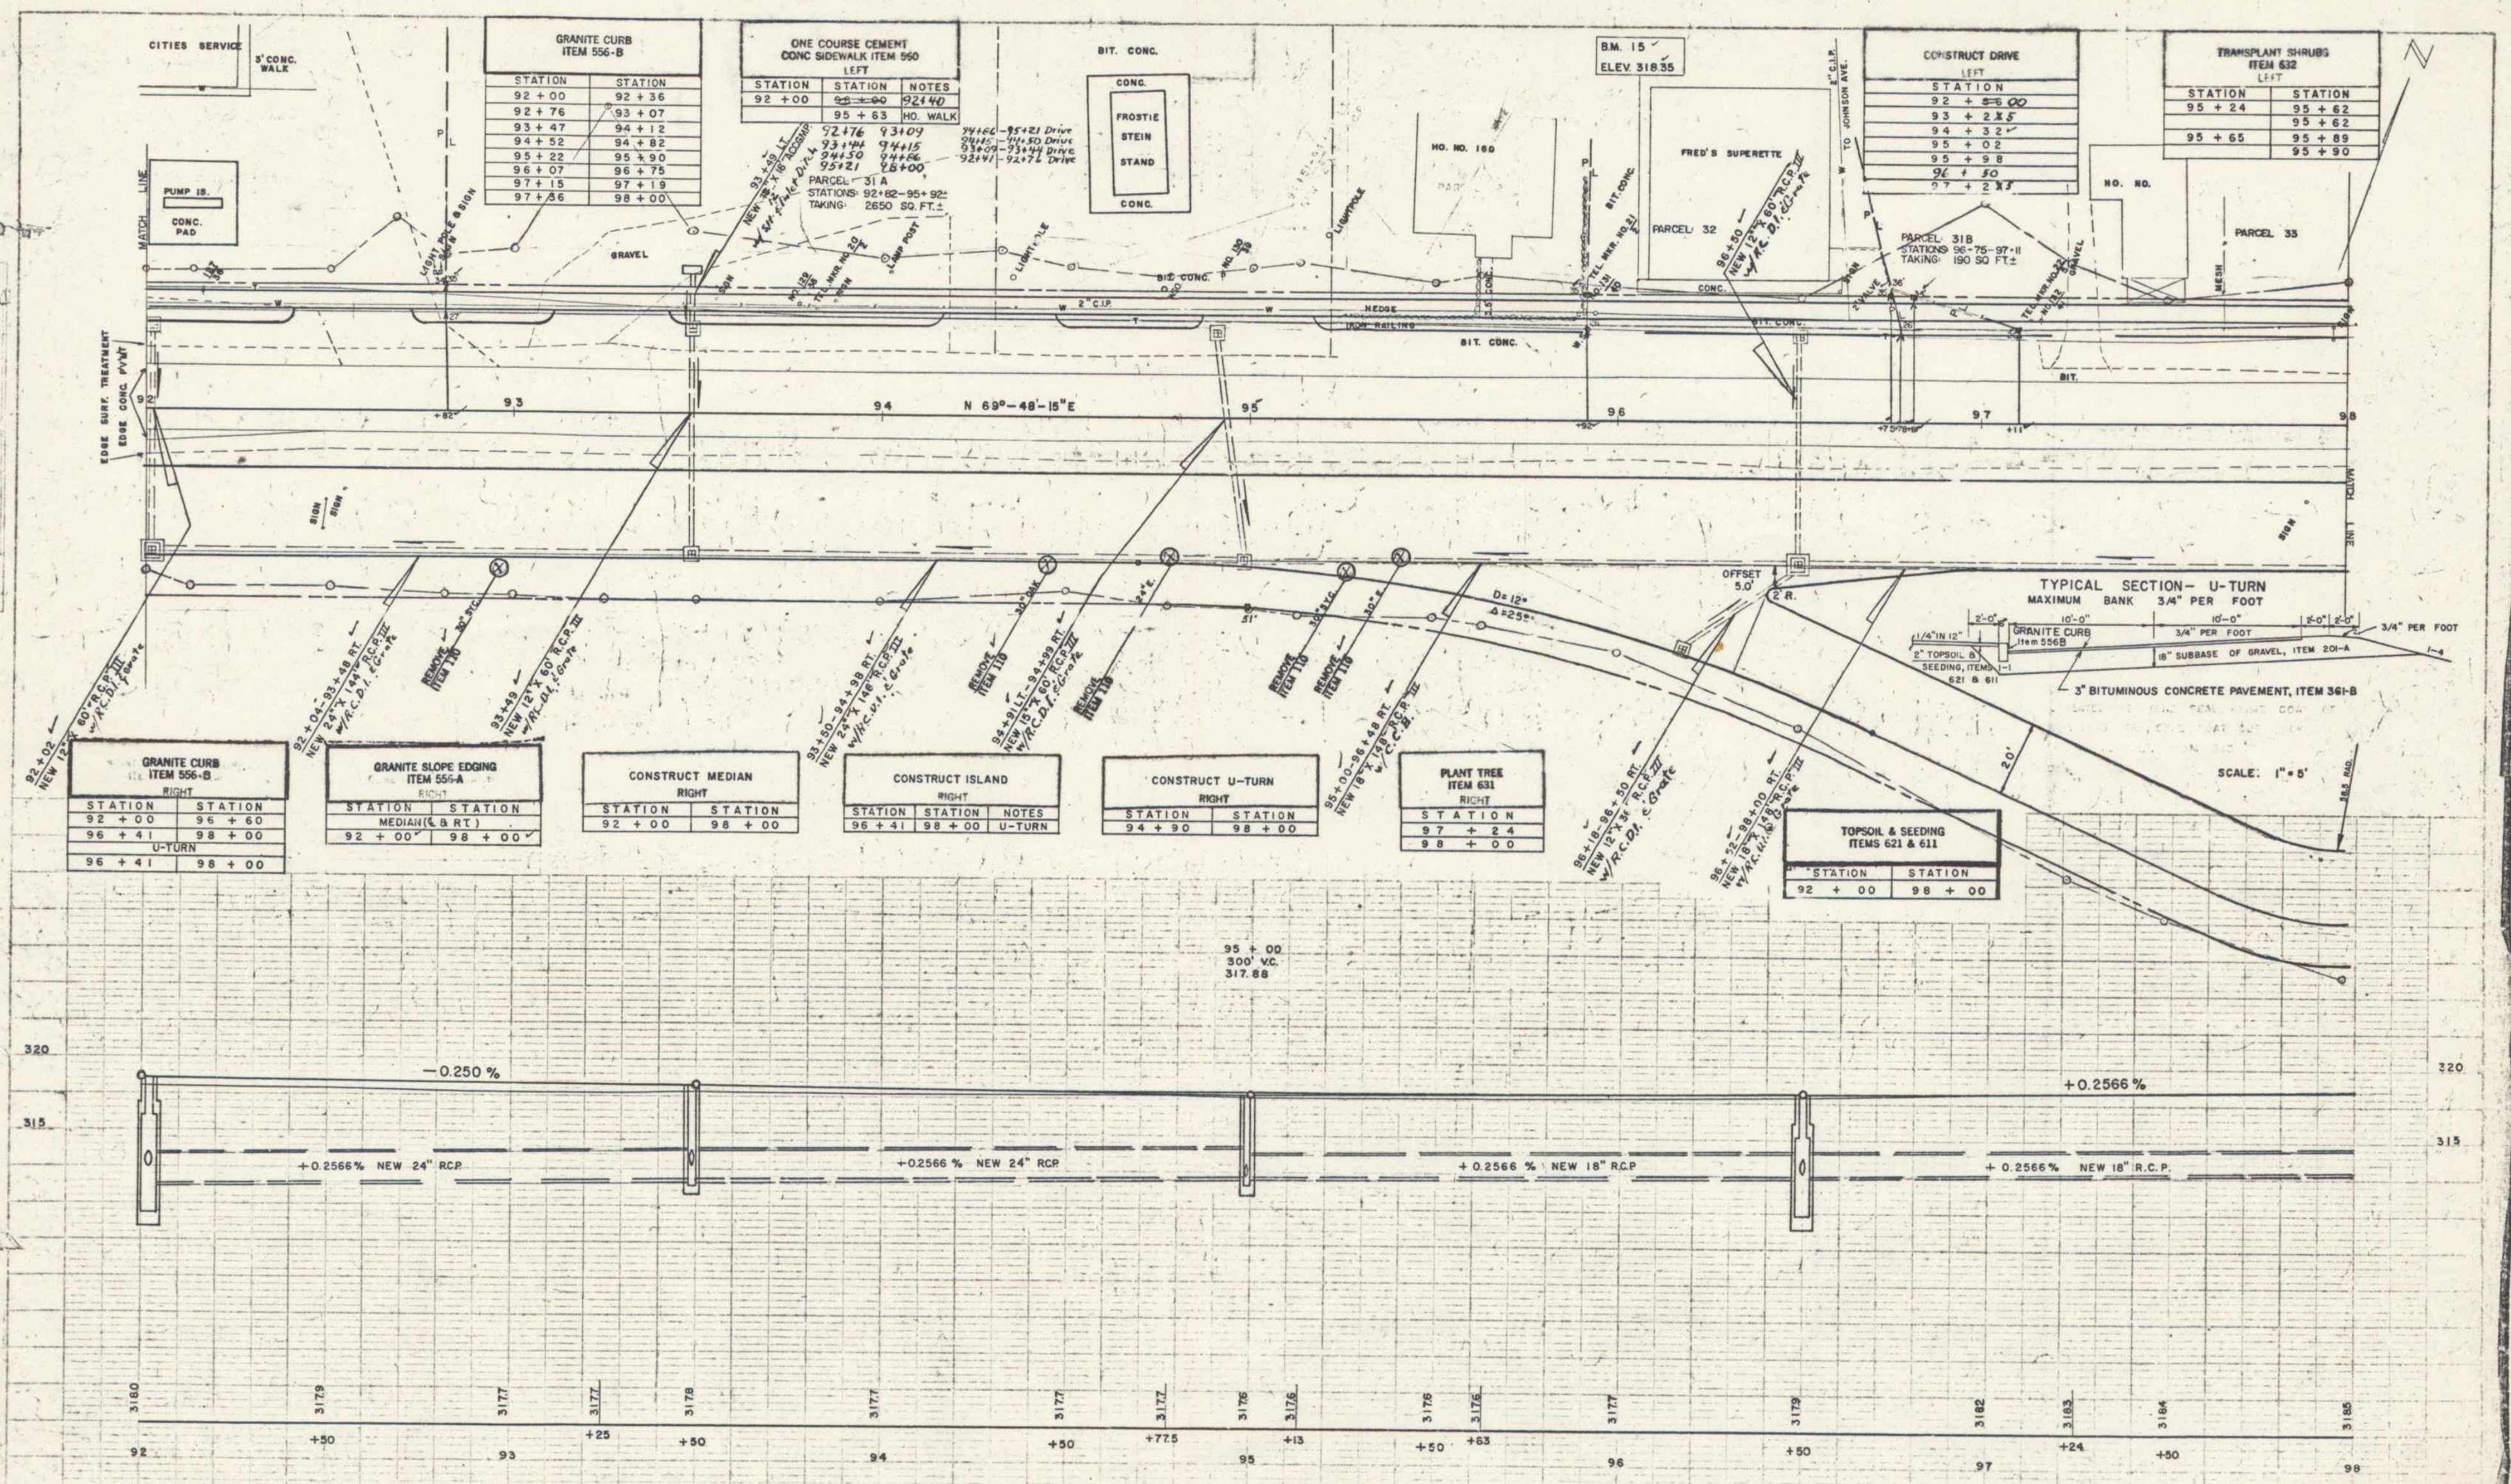

GRANITE CURB ITEM 556-B	
STATION	STATION
92+00	92+36
92+76	93+07
93+47	94+12
94+52	94+82
95+22	95+90
96+07	96+75
97+15	97+19
97+86	98+00

ONE COURSE CEMENT CONC SIDEWALK ITEM 960		
STATION	STATION	NOTES
92+00	92+00	92+40
95+63		HO. WALK

CONSTRUCT DRIVE	
STATION	STATION
92+00	92+00
93+23.5	
94+32.5	
95+02	
95+9.8	
96+50	
97+23.7	

TRANSPLANT SHRUBS ITEM 632	
STATION	STATION
95+24	95+62
95+65	95+89
95+90	

GRANITE CURB ITEM 556-B	
STATION	STATION
92+00	96+60
96+41	98+00
U-TURN	
96+41	98+00

GRANITE SLOPE EDGING ITEM 555-A	
STATION	STATION
92+00	98+00

CONSTRUCT MEDIAN	
STATION	STATION
92+00	98+00

CONSTRUCT ISLAND	
STATION	STATION
96+41	98+00
U-TURN	

CONSTRUCT U-TURN	
STATION	STATION
94+90	98+00

PLANT TREE ITEM 631	
STATION	STATION
97+24	
98+00	

TOPSOIL & SEEDING ITEMS 621 & 611	
STATION	STATION
92+00	98+00

