


PLAN  
 WESTER-MARTIN INC. 6-57  
 7-57  
 NOTE: SEE SHEET 35 OF 217  
 0+00 SIDE RD. STA. 116+95  
 40' RT. M.L. STA. 116+95

PROFILE  

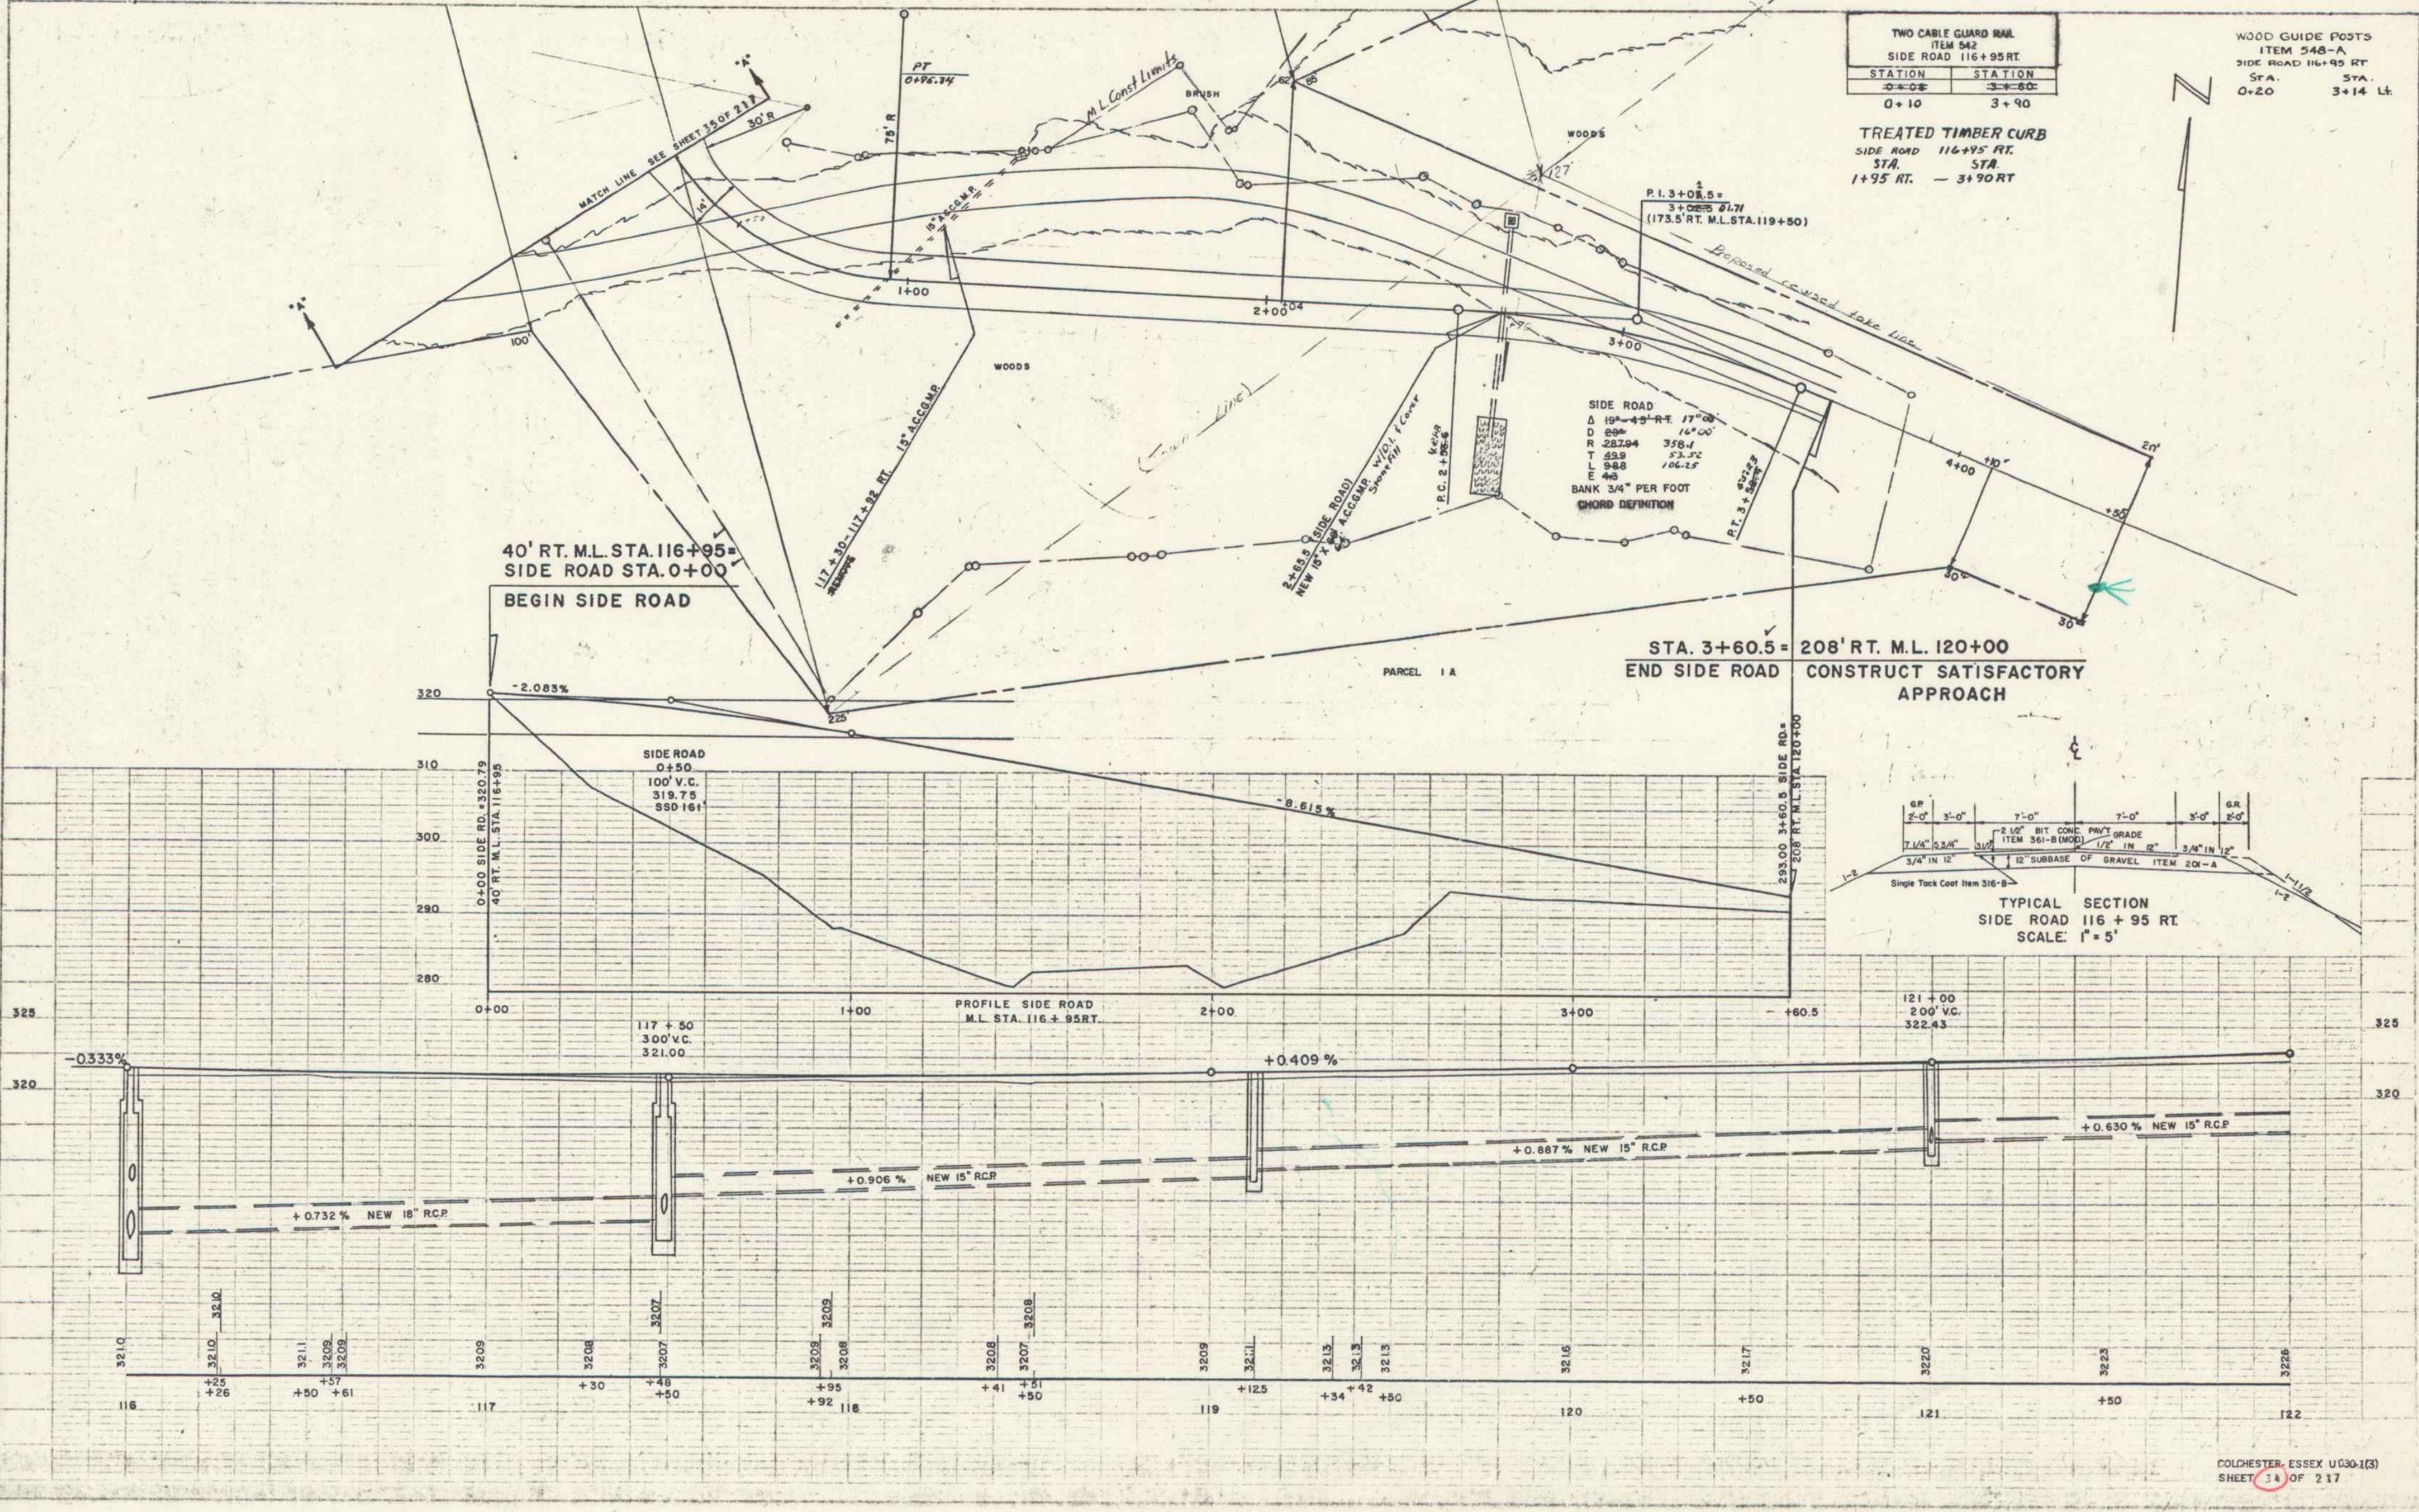

TWO CABLE GUARD RAIL ITEM 542	
STATION	STATION
0+00	3+60
0+10	3+90

WOOD GUIDE POSTS ITEM 548-A	
STATION	STATION
0+20	3+14

SIDE ROAD  
 R 287.94 358.1  
 T 43.9 53.52  
 L 98.5 106.15  
 E 48  
 BANK 3/4" PER FOOT  
 CHORD DEFINITION

B.M. 18 S.I.R. 18" LOCUST 84.5' RT. STA. 120 + 22 ELEV. 321.53

13