




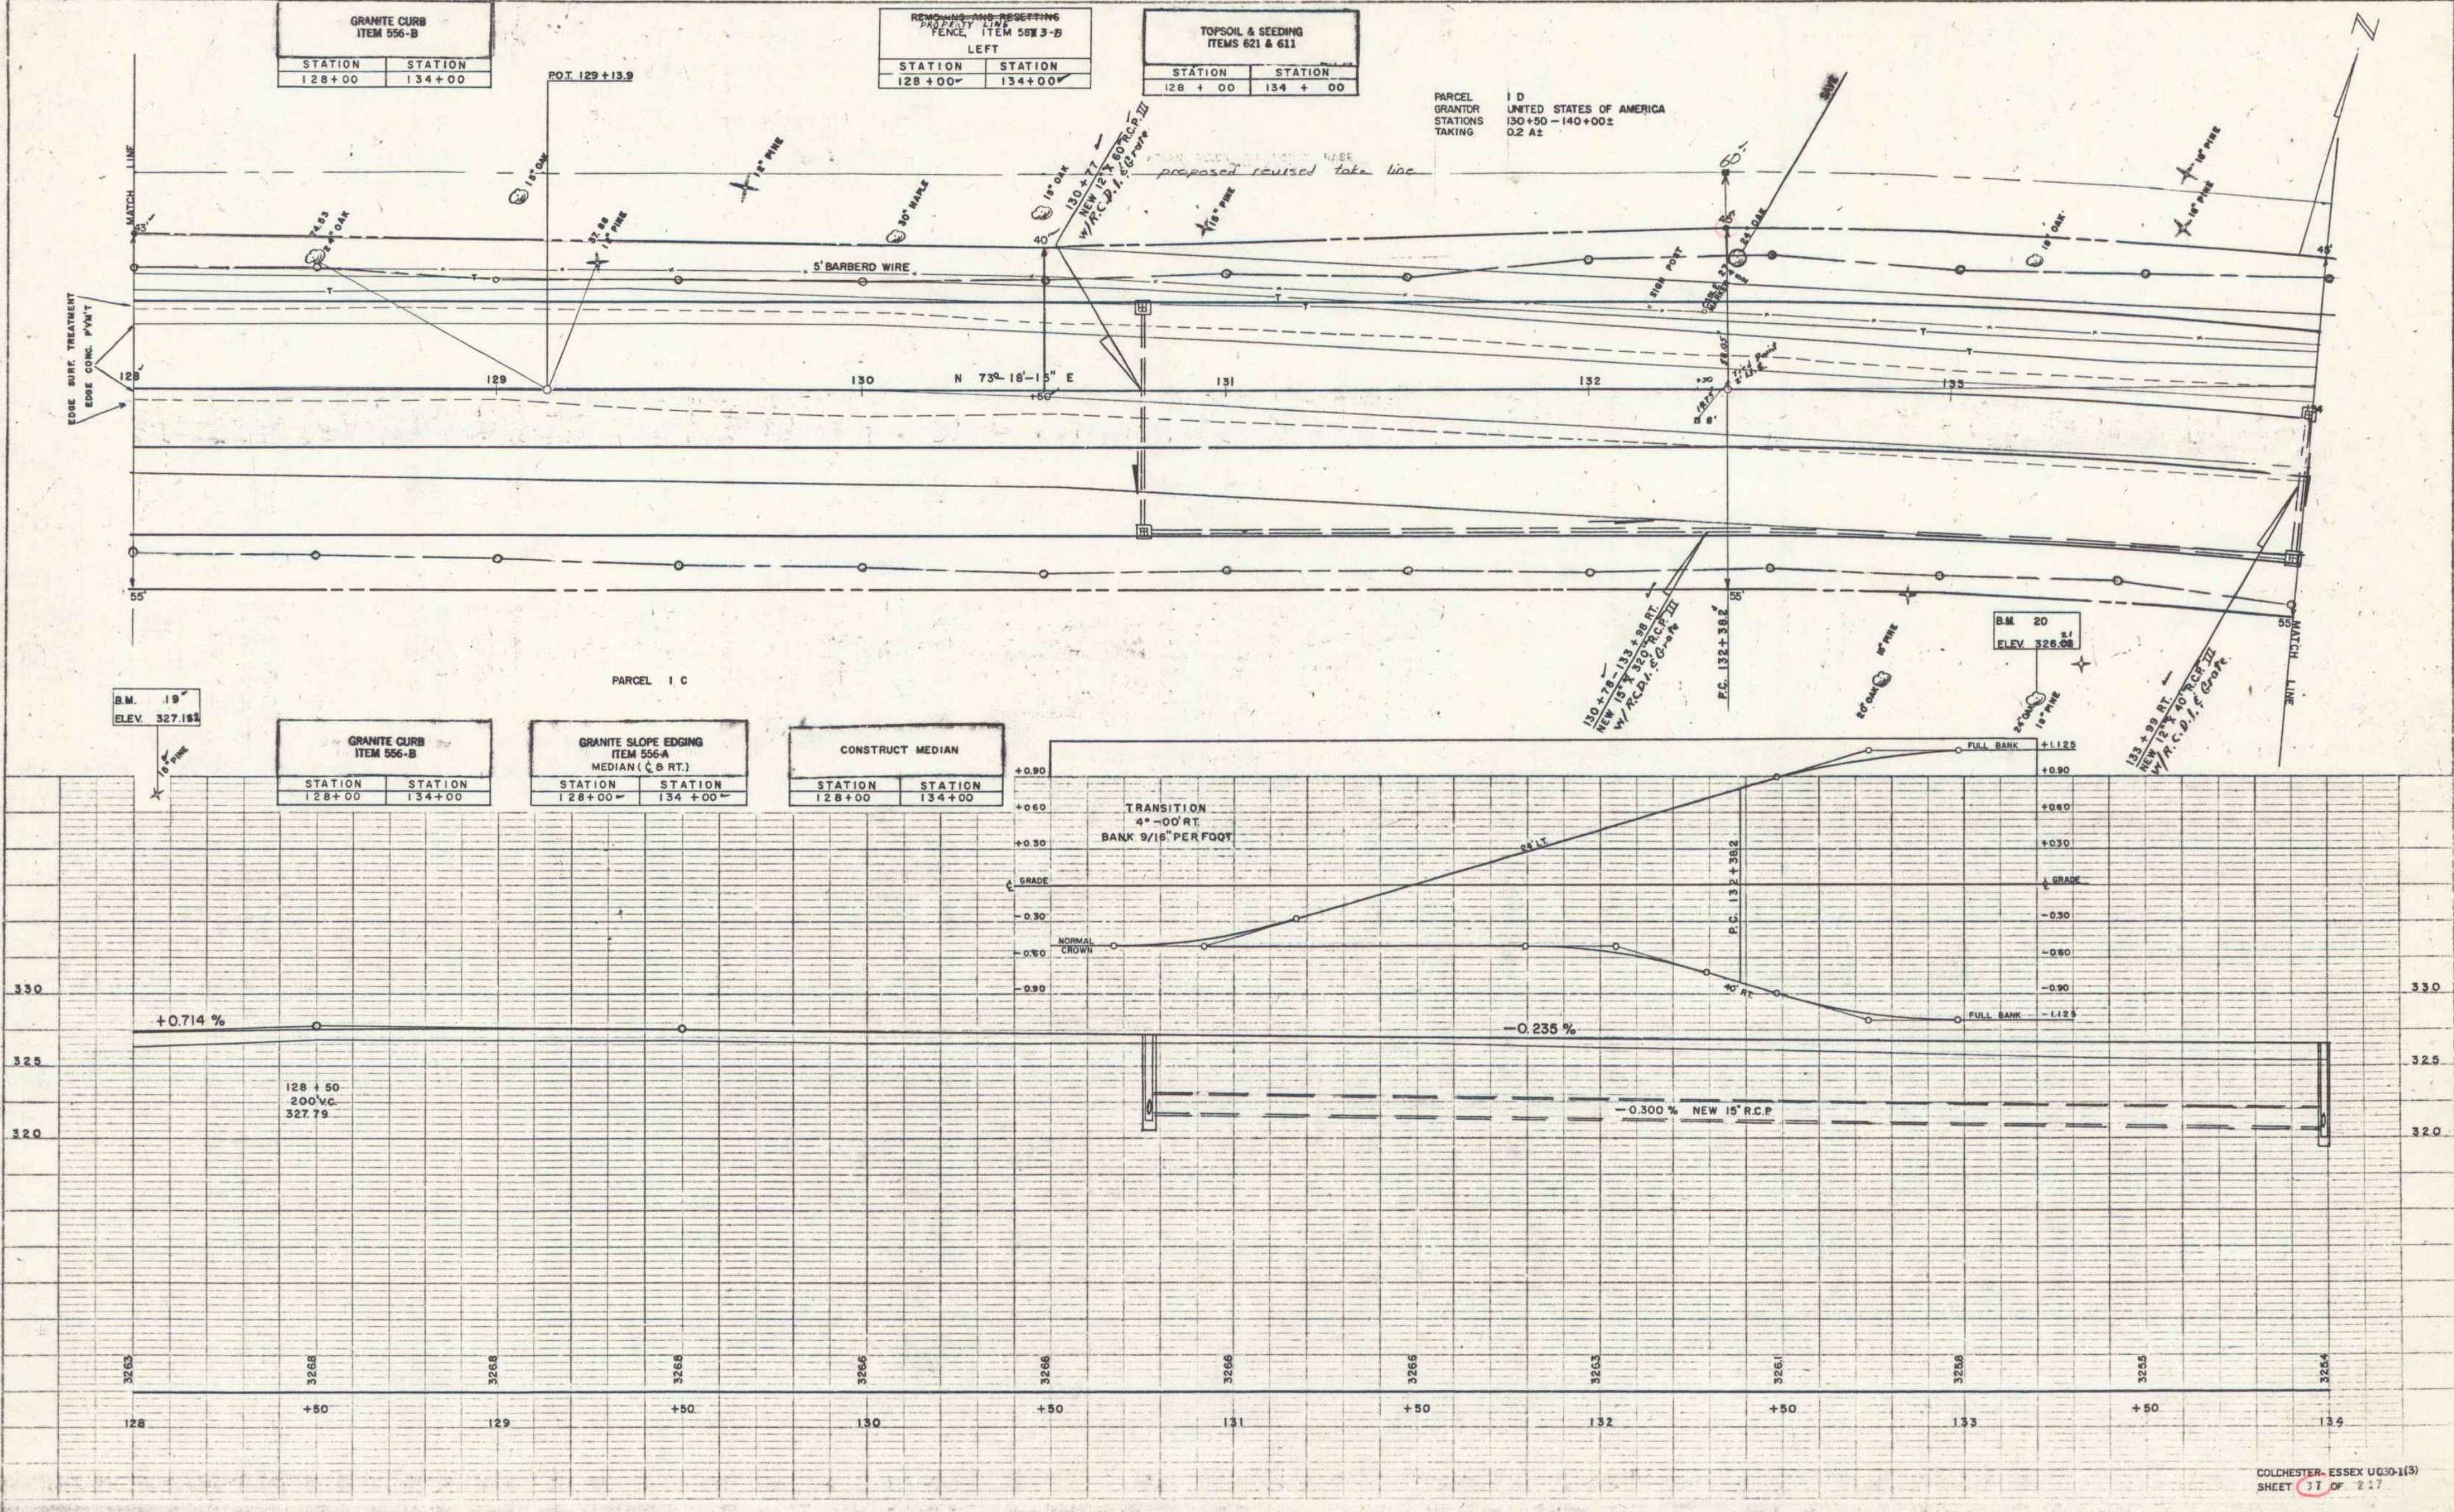

GRANITE CURB ITEM 556-B	
STATION	STATION
128+00	134+00

REMOVING AND RESETTING PROPERTY LINE FENCE, ITEM 558 3-B	
LEFT	
STATION	STATION
128+00	134+00


TOPSOIL & SEEDING ITEMS 621 & 611	
STATION	STATION
128+00	134+00

PARCEL I D
 GRANTR
 STATIONS
 TAKING
 1 D
 UNITED STATES OF AMERICA
 130+50 - 140+00
 02 A2

GRANITE CURB ITEM 556-B	
STATION	STATION
128+00	134+00

GRANITE SLOPE EDGING ITEM 556-A MEDIAN (C & RT.)	
STATION	STATION
128+00	134+00

CONSTRUCT MEDIAN	
STATION	STATION
128+00	134+00

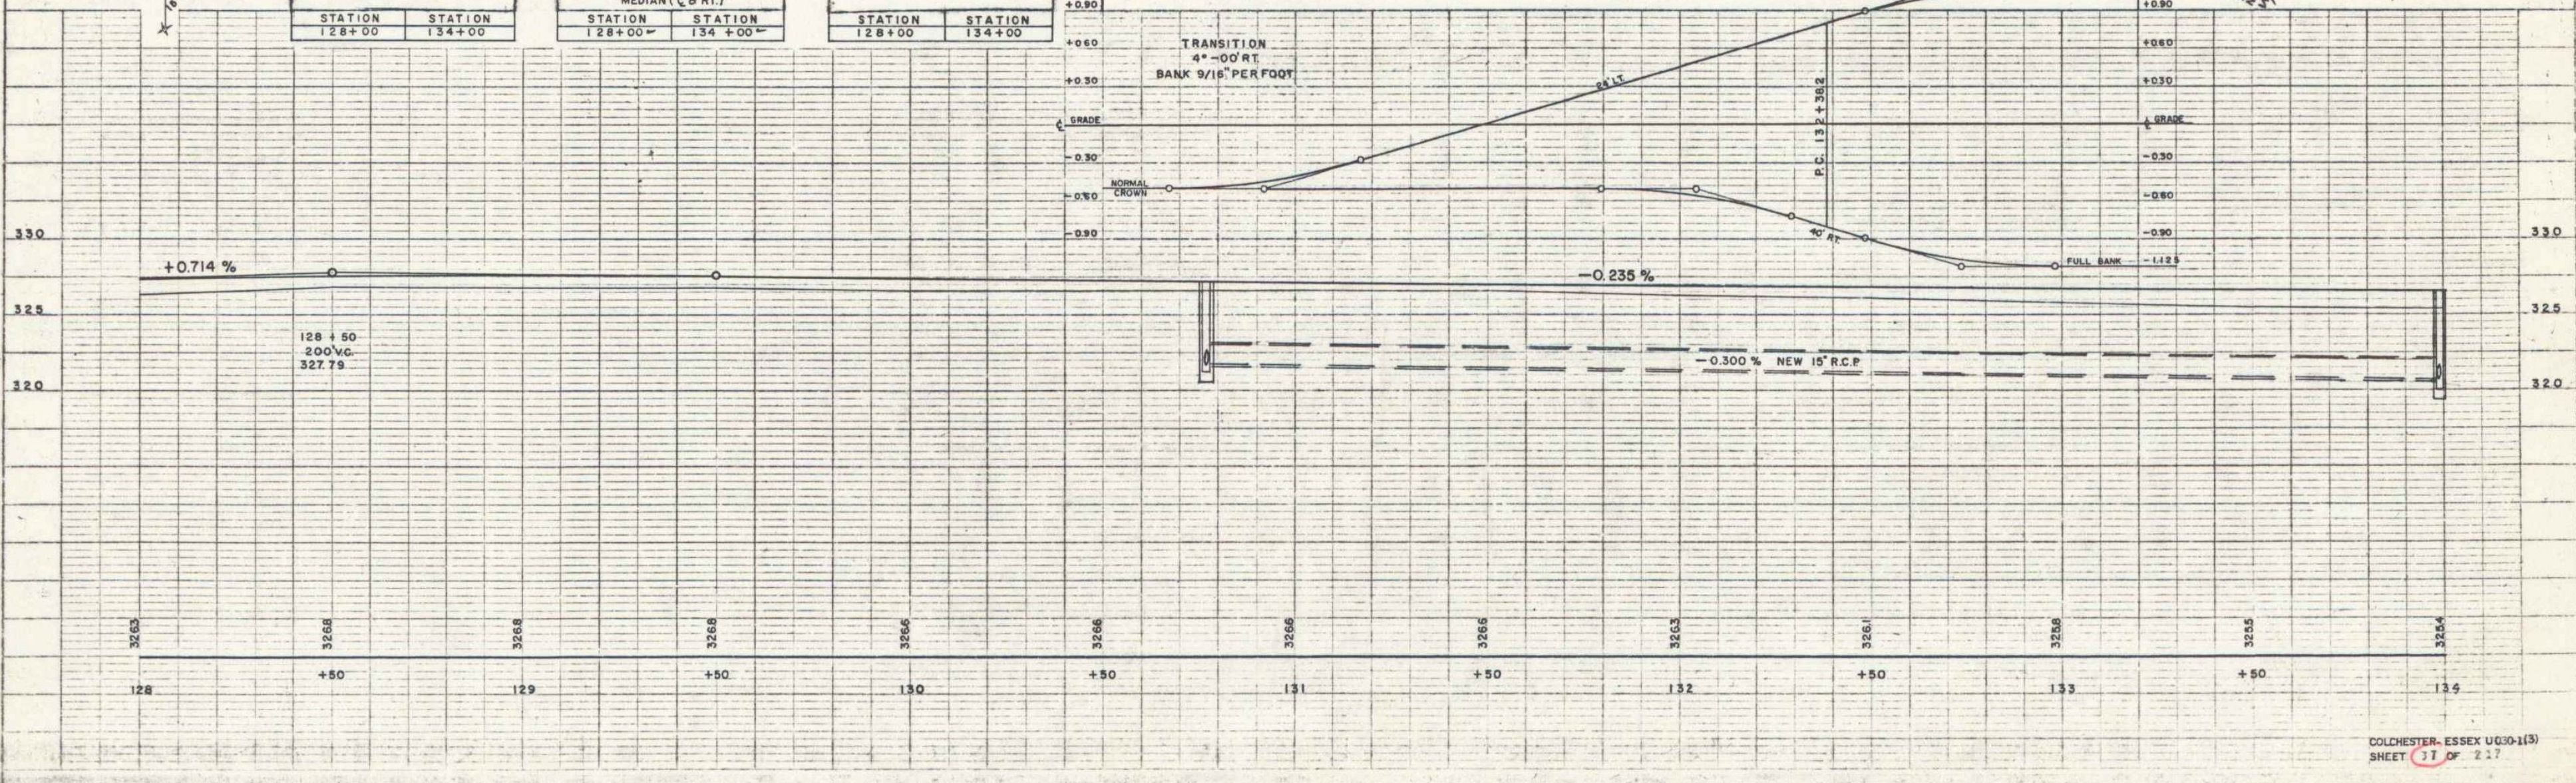

B.M. 19 S.I.R. 15" PINE 112 RT. STA. 128+07 ELEV. 327.192

B.M. 20 S.I.R. 24" OAK 83 RT. STA. 133+28 ELEV. 326.08