




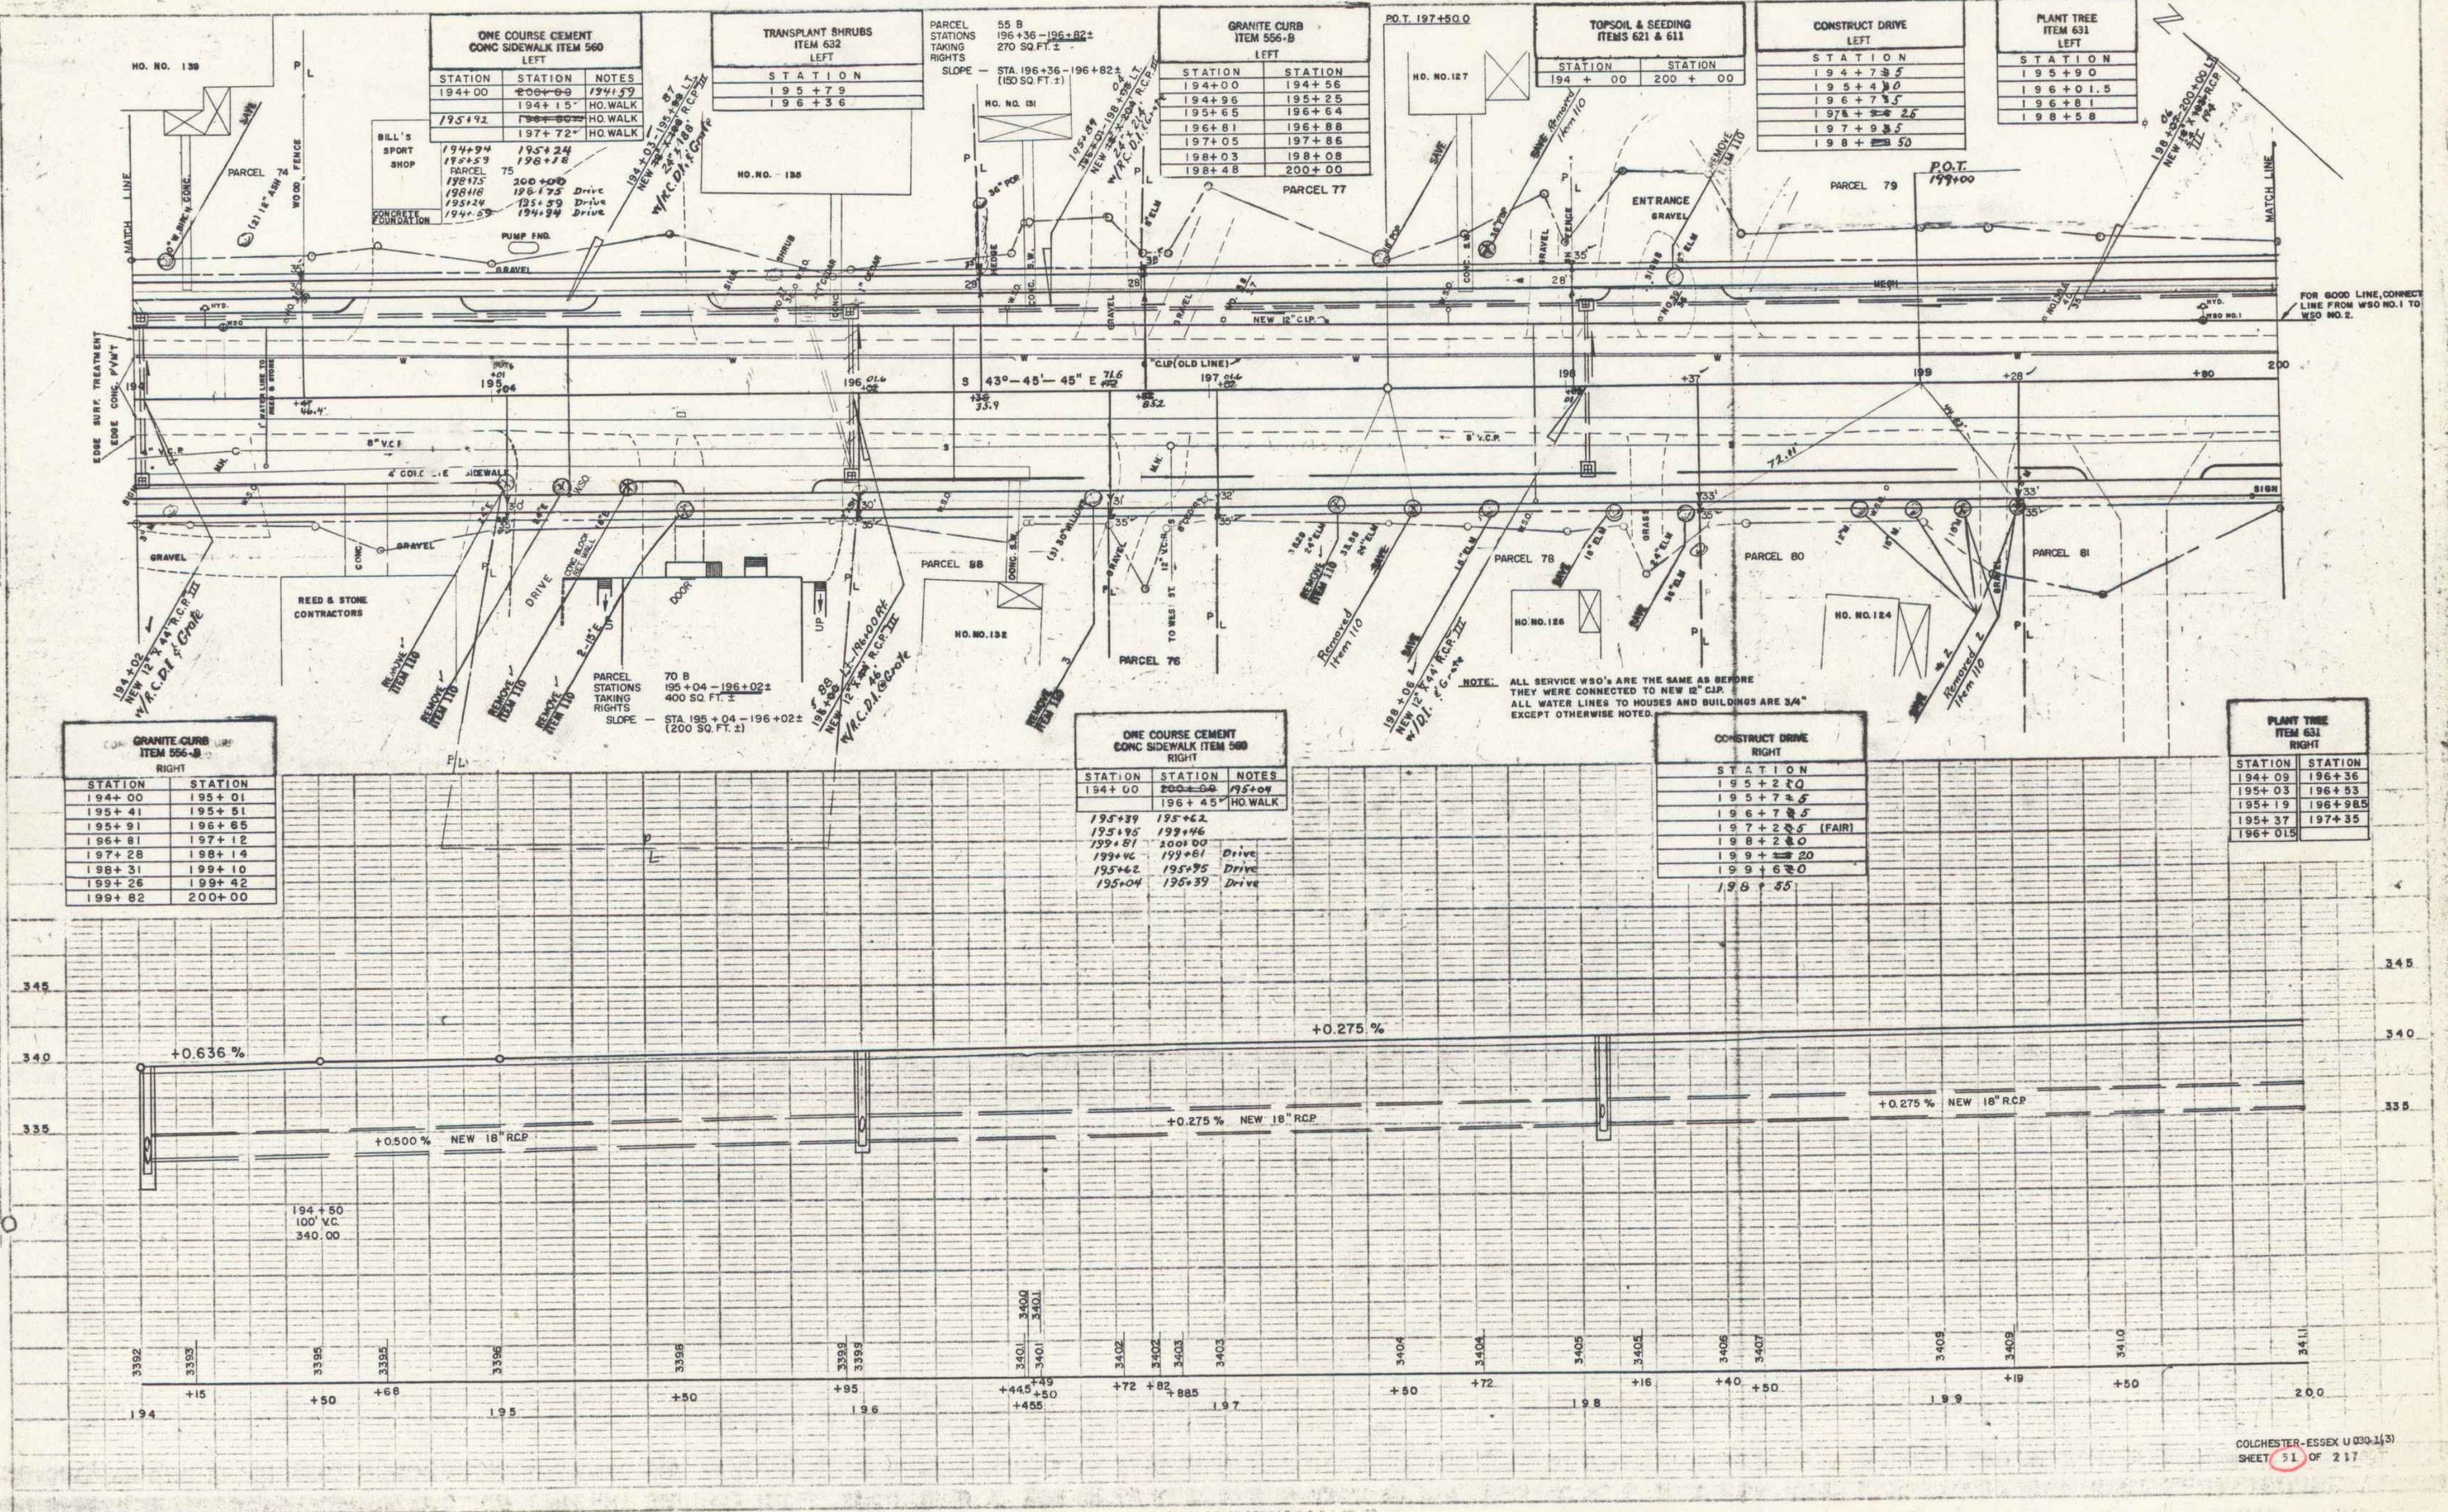

GRANITE CURB ITEM 556-B RIGHT

STATION	STATION
194+00	195+01
195+41	195+51
195+91	196+65
196+81	197+12
197+28	198+14
198+31	199+10
199+26	199+42
199+82	200+00

ONE COURSE CEMENT CONC SIDEWALK ITEM 560 RIGHT

STATION	STATION	NOTES
194+00	200+00	HO. WALK
195+39	195+62	
195+95	199+66	
199+81	200+00	
199+46	199+61	Drive
195+62	195+95	Drive
195+04	195+39	Drive

CONSTRUCT DRIVE RIGHT

STATION	STATION

PLANT TREE ITEM 631 RIGHT

STATION	STATION

