WPH				
11B	1936	6	15	

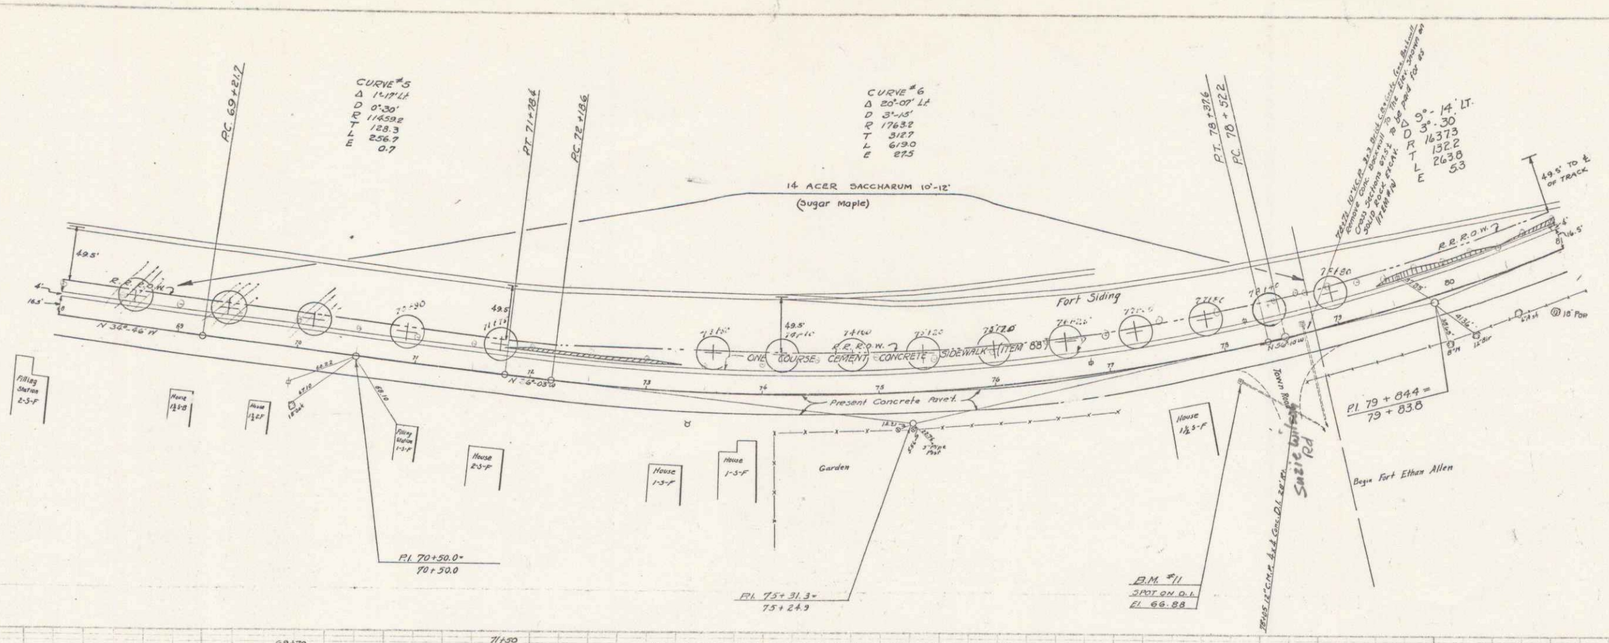

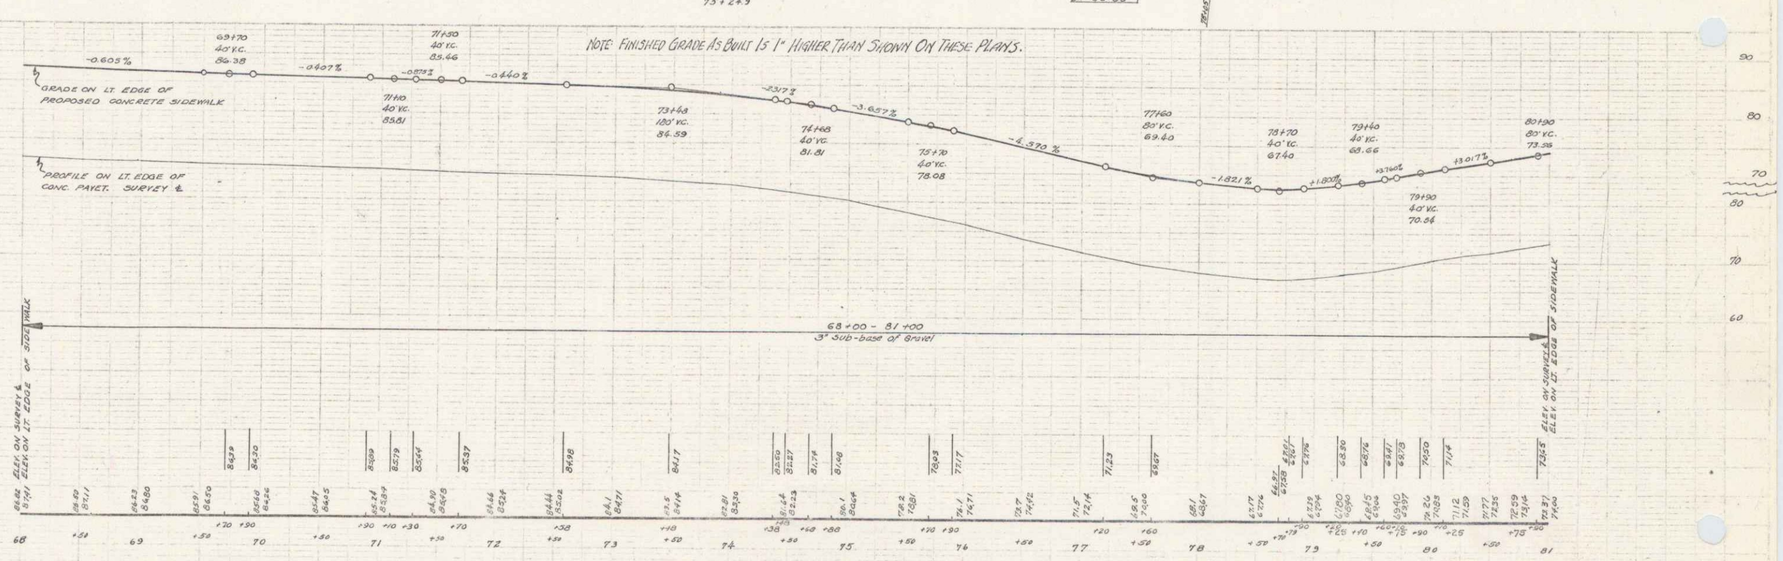

SERIES WPH No 11B
SHEET 6 OF 15

4