


DIST. NO.	STATE	PROJ. NO.	YEAR	NO.	SHEETS
3	VT.	993	1929	3	15

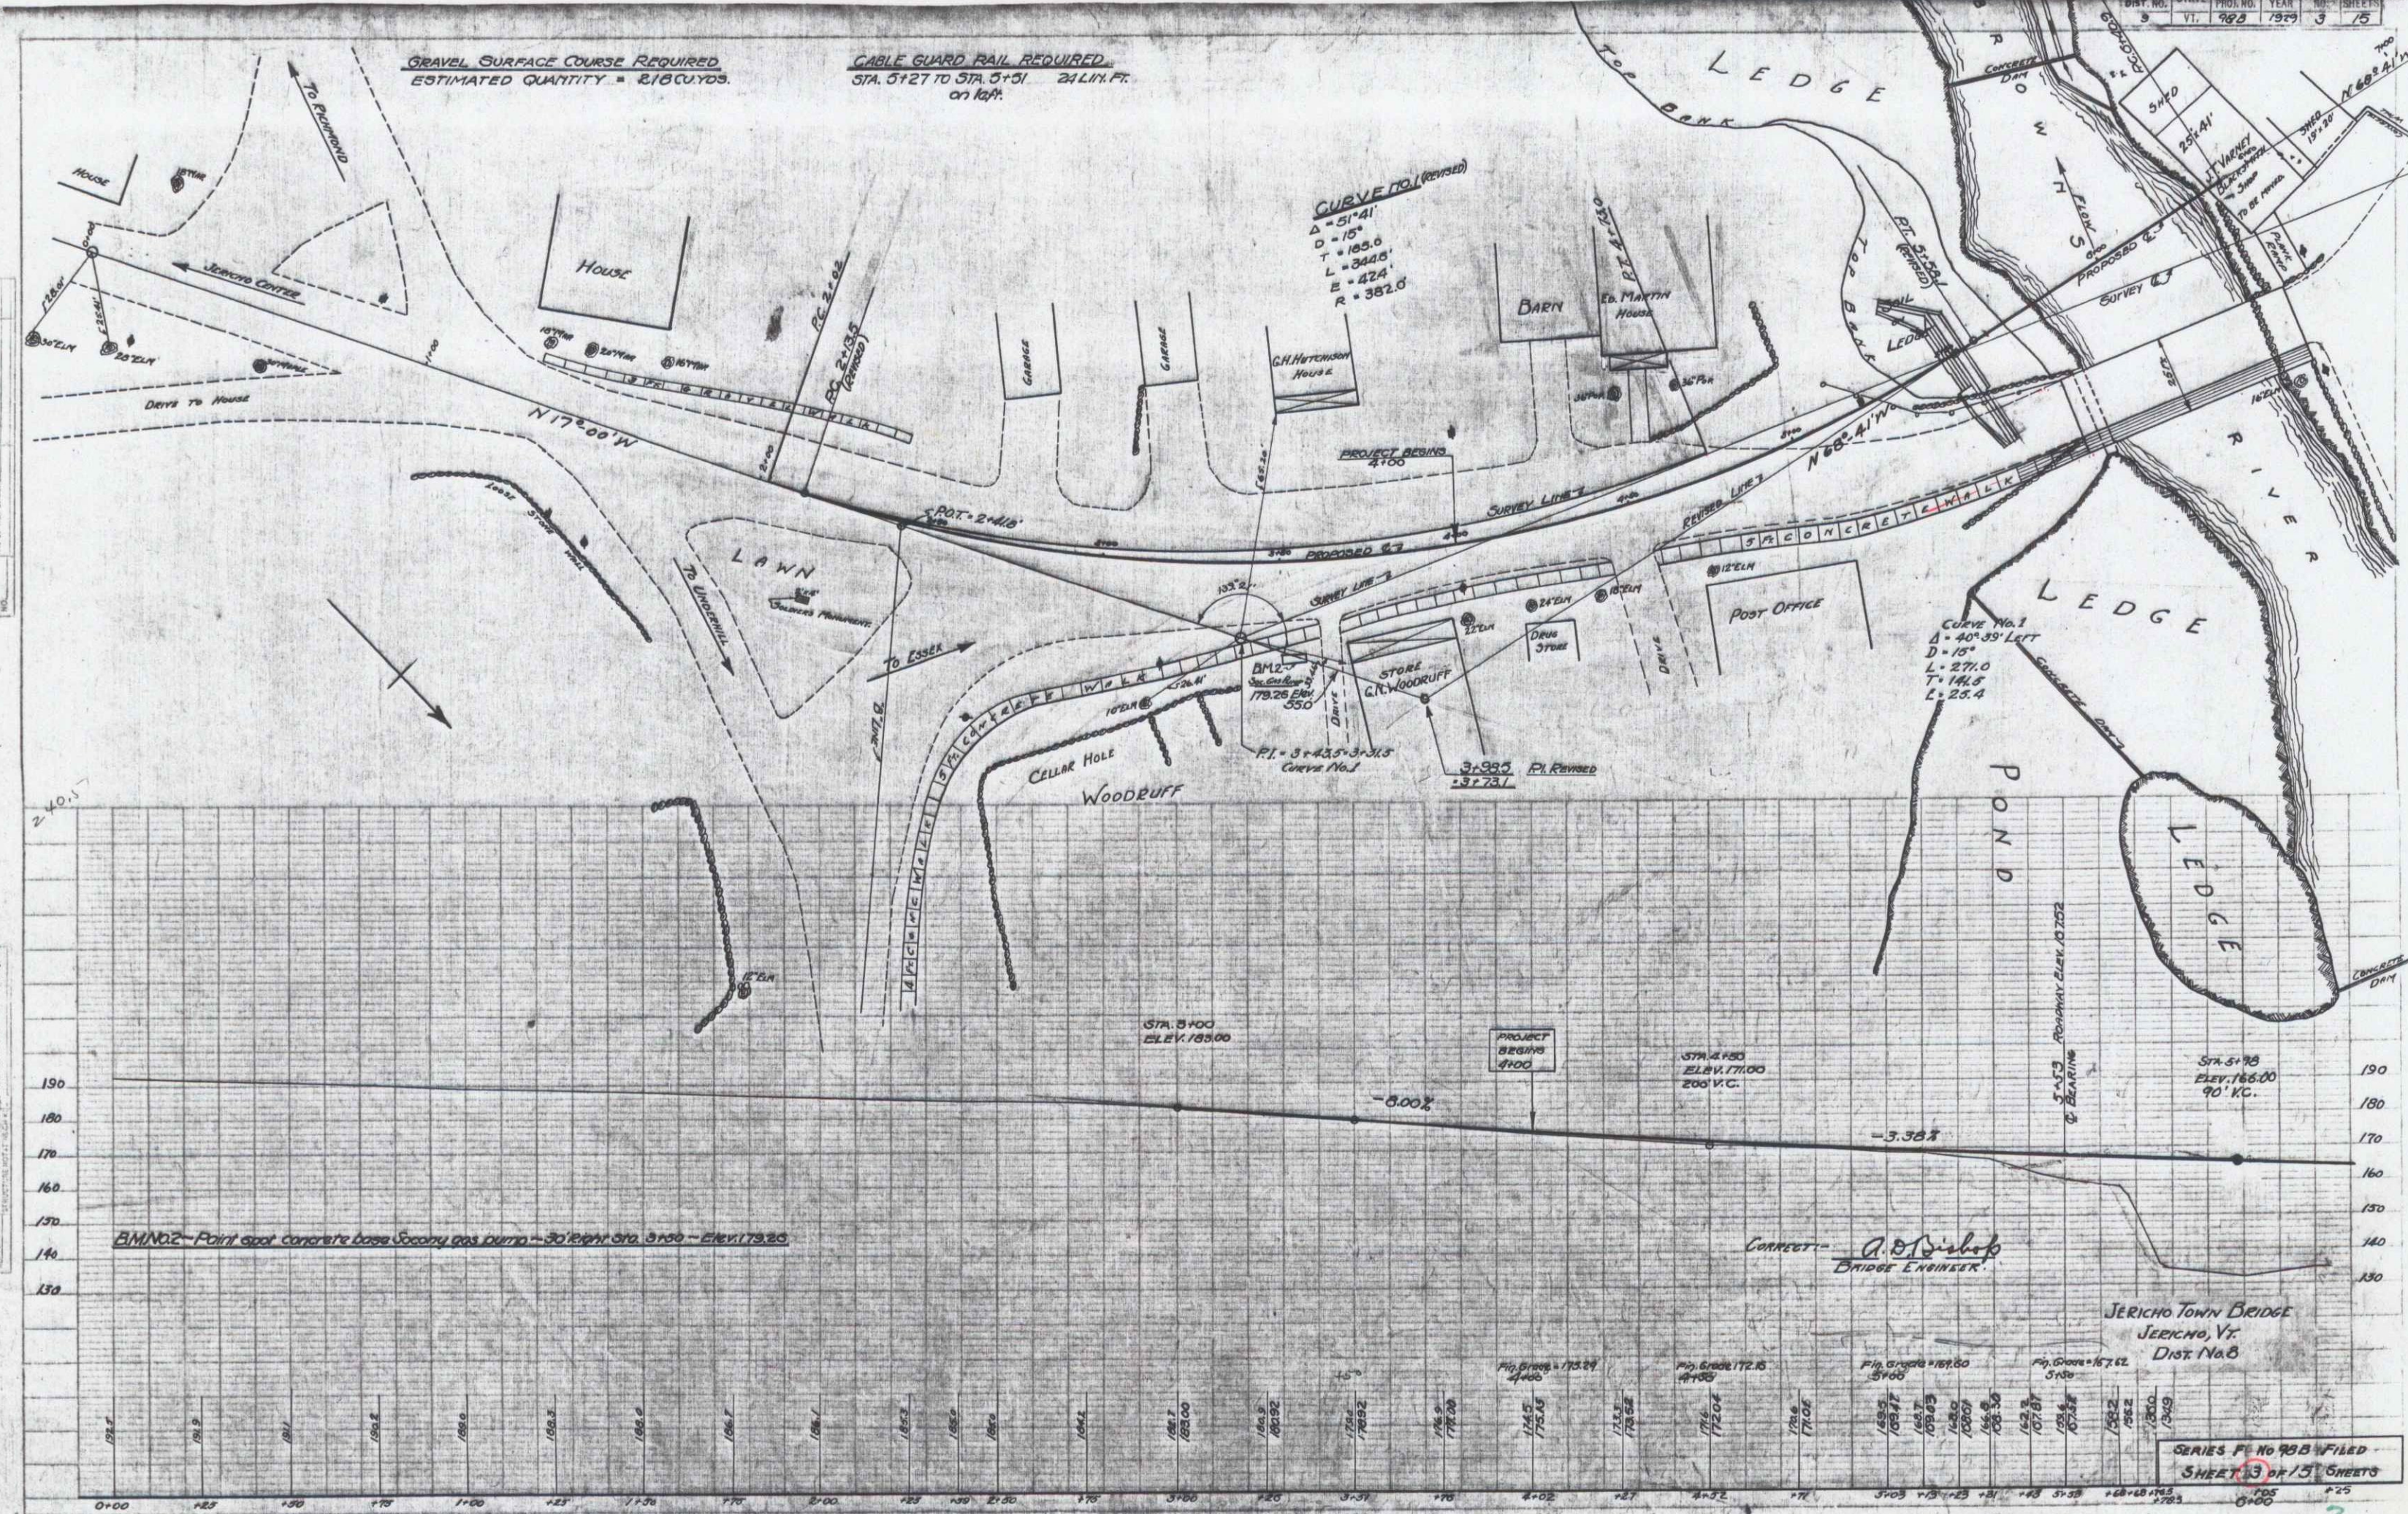



CONNECTED BY
R. D. DUBOIS
 BRIDGE ENGINEER

JERICHO TOWN BRIDGE
 JERICHO, VT.
 DIST. NO. 8

 SHEET 3 OF 15 SHEETS
 105
 0+00