REV. DIST. NO.	STATE	FED. RD. PROJ. NO.	FISCAL YEAR	TOTAL SHEETS	SHEET NO.
9	VT.	IR-F-C	1981	10	141

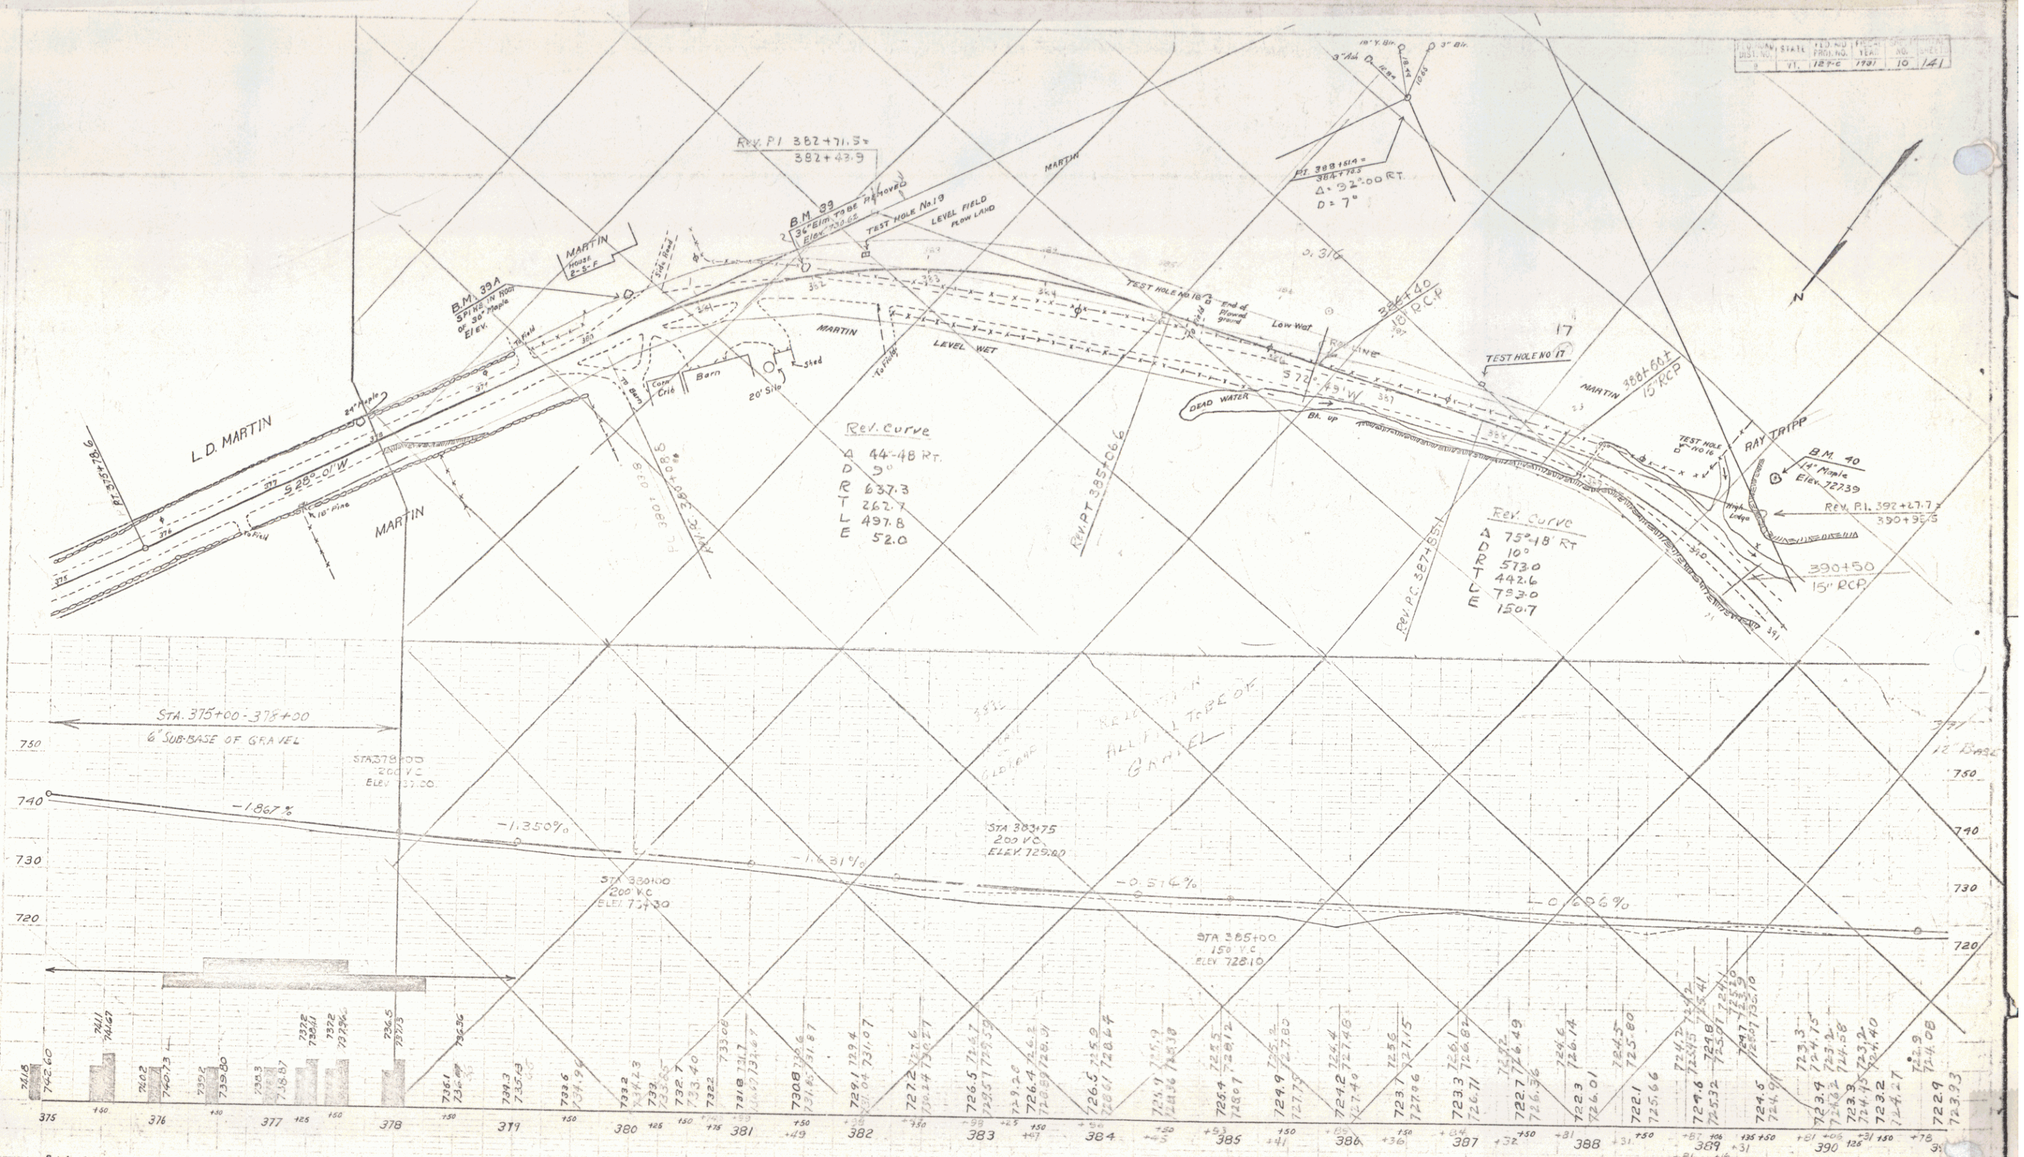

9