FED. ROAD DIST. NO.	STATE	FED. AID PROJ. NO.	FISCAL YEAR	SHEET NO.	TOTAL SHEETS
5	VT	80-L	1931	42	141

WOOD GUARD RAIL REQUIRED

Culv. Station	Lt.	Rt.
878+70	26'	26'

CABLE GUARD RAIL REQUIRED

STATION	LEFT	RIGHT	CONSTANT	PAY LENGTH
880+80 - 881+00 L			20'	40'

Parcel	Kind of Instrument	Date of Instrument	Grantor	Grantee	Recorded Randolph Book	Page	Date	Remarks
A	Q.C.D.	10-28-31	W.F. & M.M. Ashline	State of Vt.	50	171	2-2-32	
A'	"	11-12-31	Dr. & N.N. Sargent	"	50	268	2-2-32	Culv. Sta. 878+70
A' Culv. #1 Clean Rubb.	"	10-24-31	R.P. & G.E. Camp	"	50	273-4	2-3-32	Clean Rub. 880+40 E to 881+50 E

NEW PIPE CONCRETE PIPE CULVERTS REQUIRED

STATION	DIAM.	LENGTH	C.P.Y.	GRADE
878+70	[illegible]	[illegible]	[illegible]	[illegible]
878+90 - 879+00 Rt.	30"	47.0	10	[illegible]

RELAY PIPE CULVERTS REQUIRED

STATION	DIAM.	LENGTH	C.P.Y.
866+00 to 866+47	[illegible]	[illegible]	1.0 C.Y.

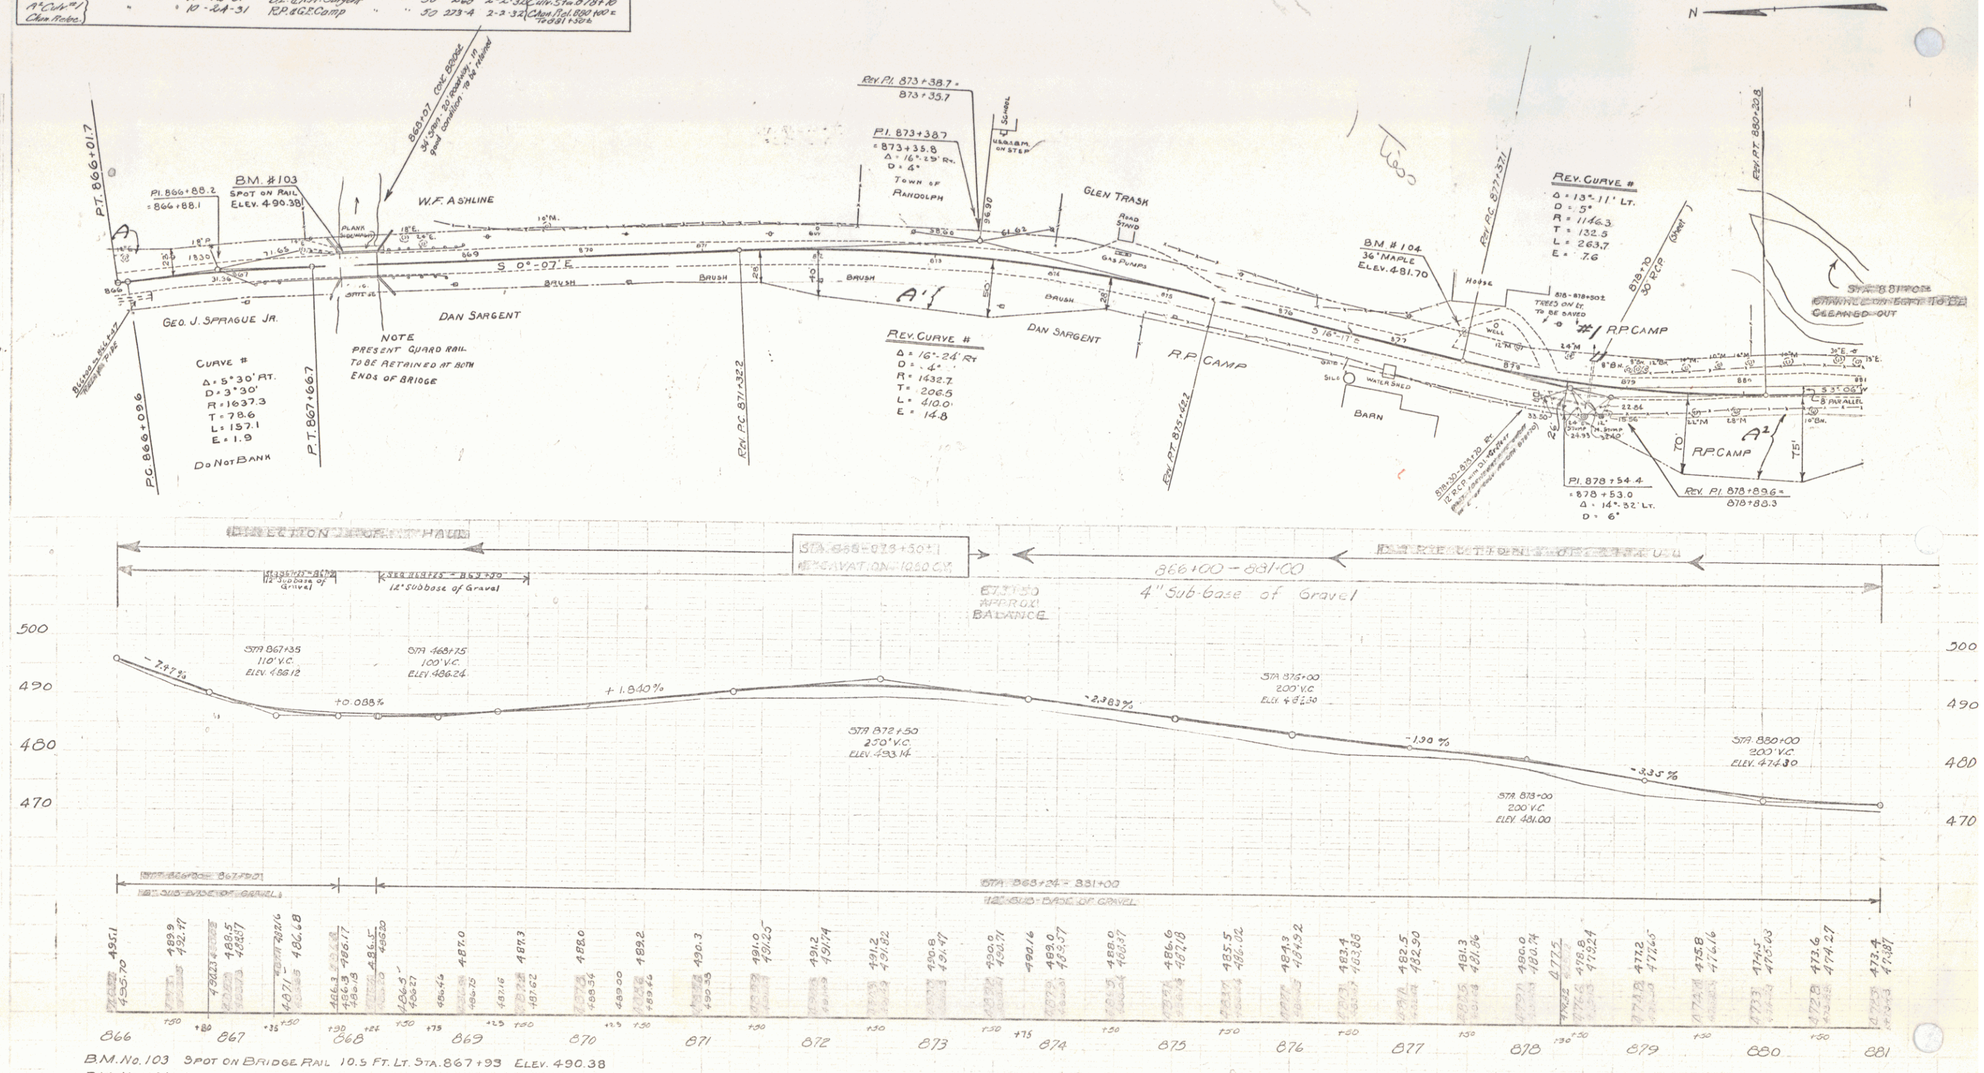

B.M. No. 103 Spot on Bridge Rail 10.5 Ft. Lt. Sta. 867+93 Elev. 490.38

B.M. No. 104 Spike in Root of 36" Maple 20.5 Ft. Lt. Sta. 877+52 Elev. 481.70

Series F. No. 80-L
Sheet 42 of 141

40