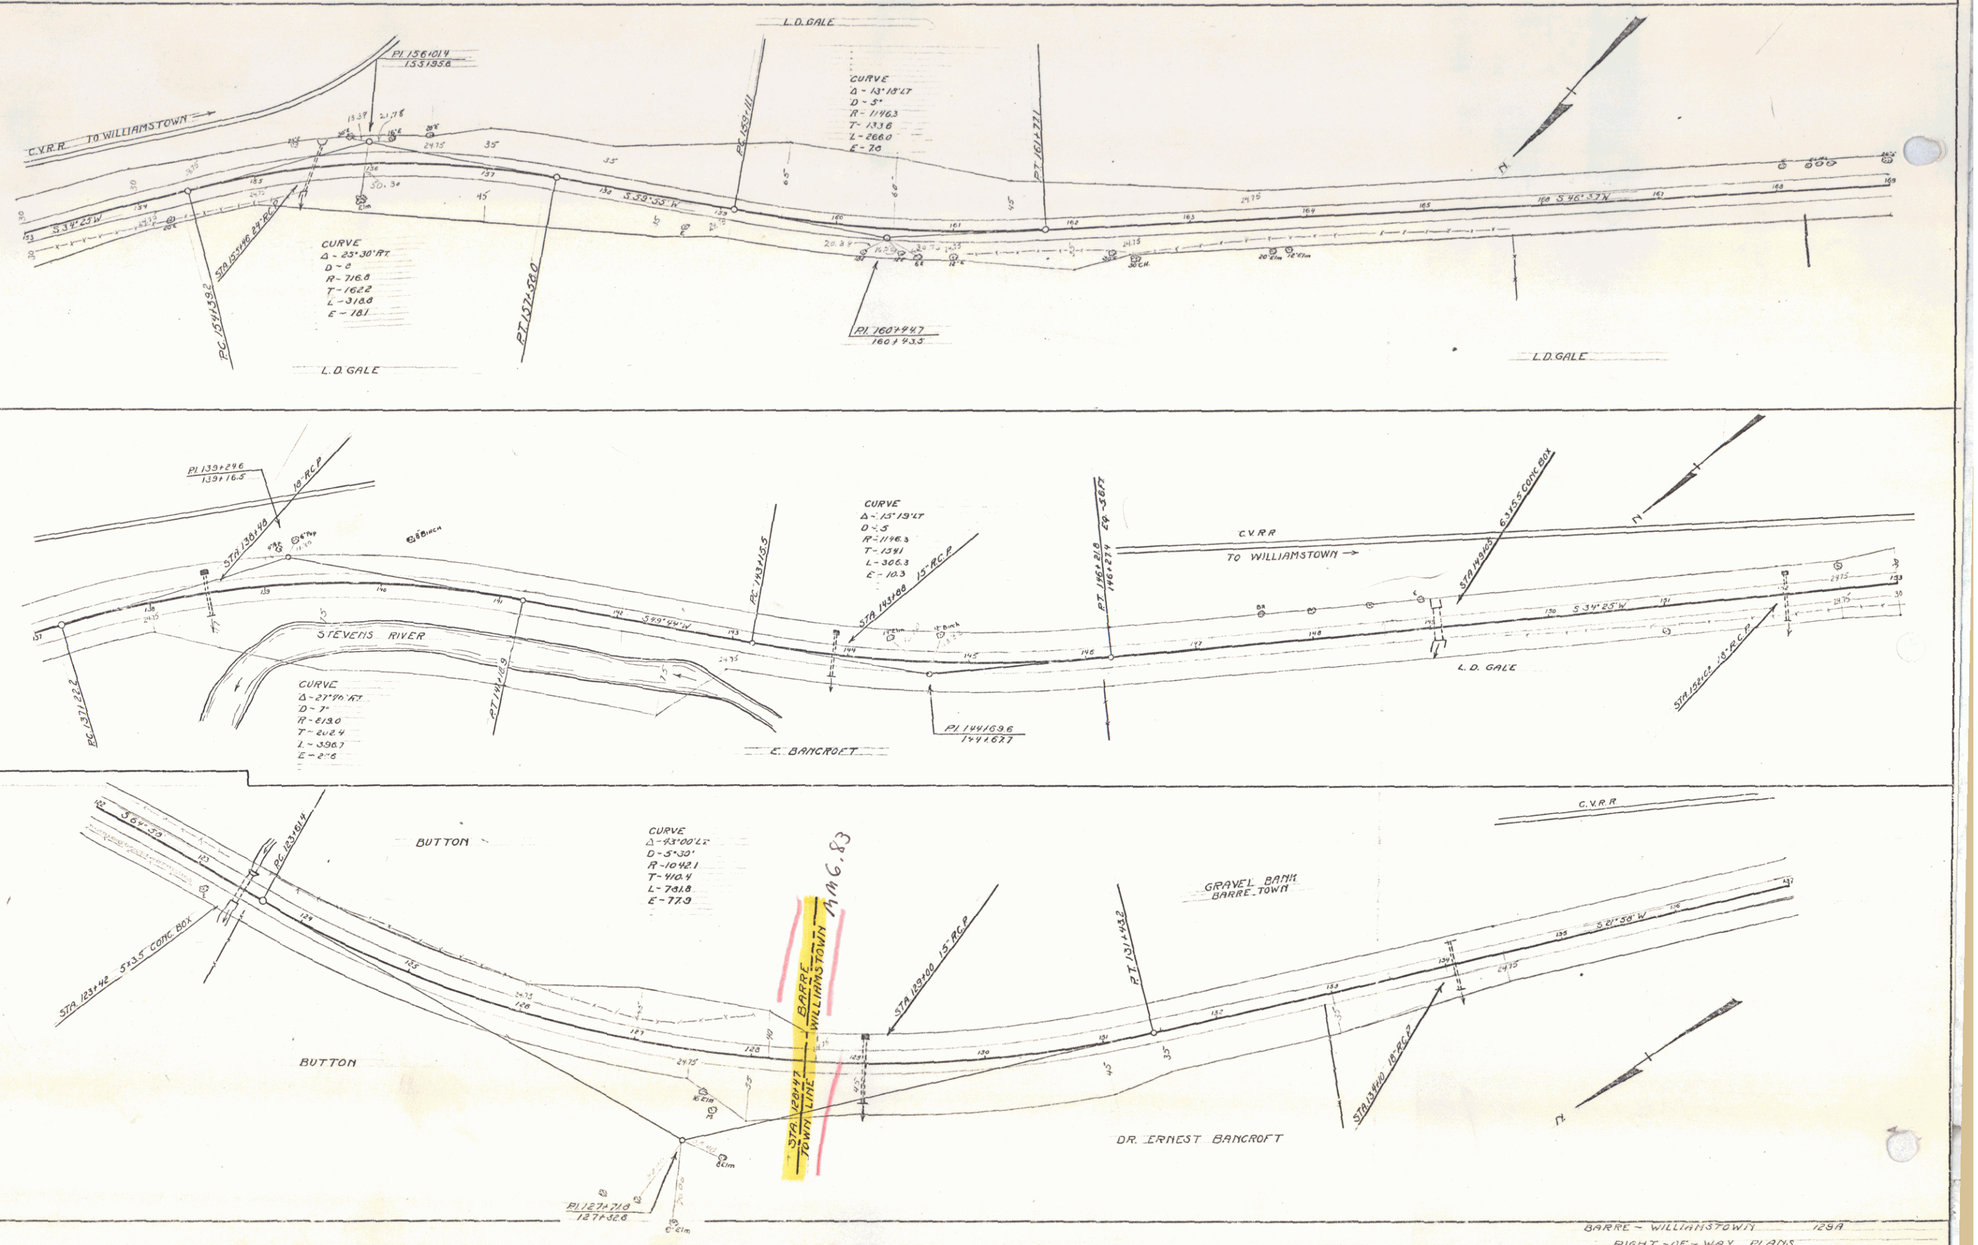

BARRE - WILLIAMSTOWN 129A

RIGHT-OF-WAY PLANS

SHEET 28

4