129 A 1931 16 85

Wood Guard Rail Required		
Culv. Sta.	Left	Right
192+71	-	24'
195+66	-	24'
185+39	-	24

Cable Guard Rail Required			
Stations	Leng.	Const.	Pay-leng.
185+00 - 187+06 Lt.	206'	40'	187+36'
191+86 - 196+00 Lt.	416'	40'	193+86'
195+81	400		

New Reinf. Conc. Pipe Culv. Required					
Sta.	Diam.	Leng.	Conc. A	Steel	Cem. Rub. Mas.
185+39	24"	56 FT	28 cu. yd.	3+57.83	1.5 cu. yd.
193+00	18"	94	23 "	119.00	1.0 "
193+67	24"	44	26 "	119.00	2.7 "

Relay Pipe

195+66	18"	31

Std. Underdrain With 6" Perf. C.G.M.P. Required			
Stations	Leng.	Wood Guide Posts	Cem. Rub. Mas.
187+00 Lt.	30'	1	0.32 cu. yd.
188+[illegible] - 192+[illegible] Rt.	400'	1	0.33 "
192+72 - 194+00 Rt.	128+100'	-	-
194+74 - 195+66 Rt.	92'	-	-
96	120'		

Integral Curb

191+55 - 192+72 Lt.	2"	237 L.F.
232+24 - 232+58 Lt.	2"	34 "
292+51 - 293+74 Lt.	2"	123 "

Metal Drop Inlet & Grate

194+42 Lt.	1

Guide Post

184+45 Lt.	1
185+39 Lt.	1

Concrete Curb & Gutter

192+35 Lt.	1.2	C.Y.	35# Steel
192+55 Lt.	1.2	"	
192+54 Rt.	1.2	"	

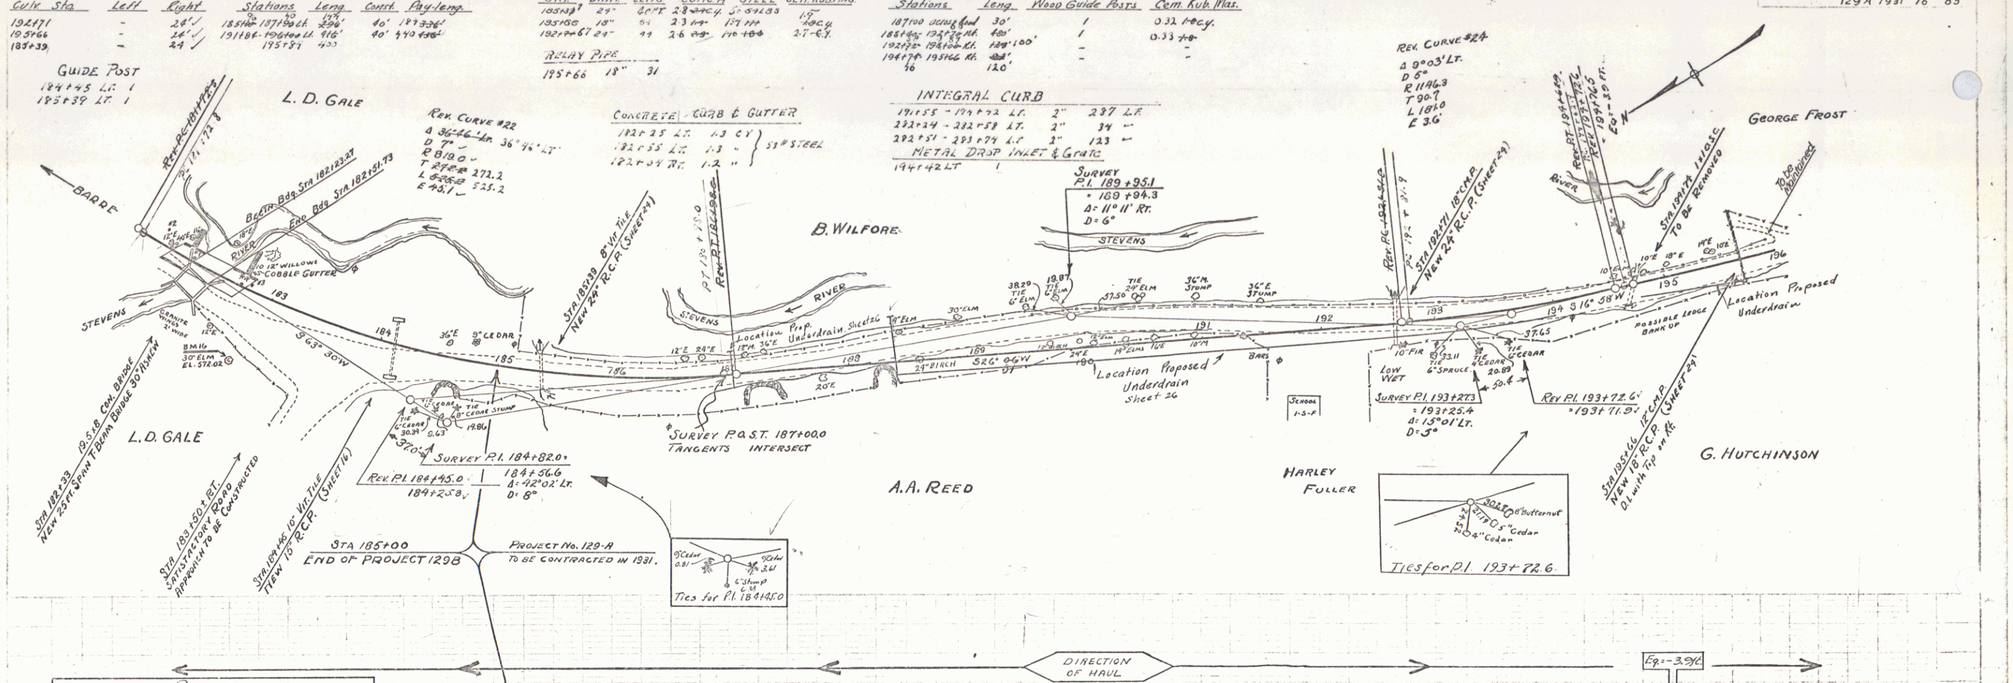

Series F No. 129A
Sheet 16 of 85