U.S. HIGHWAY DIST. NO.	STATE	PROJ.	SN-FAI	FISCAL YEAR	SHEET NO.	TOTAL SHEETS
1	VT.		91(7)	1943	6	53

PARCEL	INSTRUMENT	DATE	GRANTOR.	GRANTEE	RECORDED HARTFORD BOOK	PAGE	DATE	REMARKS
A	CORP DEED	10-31-42	HARTFORD WOOLEN CO. INC.	ST OF VT.	49	184	10-31-42	
A¹	GUARDIAN DEED	2-10-43	ARTHUR NALETE	ST OF VT	49	227	2-25-42	
A²	W.D.O.E	9-25-42	JOSEPH & MABEL GAUDETTE	ST OF VT	49	169	9-28-42	

No Changes in Grade or ℄

Existing Guard Rail & Guide Posts. Any existing guard rail and guide posts that may be taken down are to become the property of the State. The cable shall be reeled and stored and the posts and planking piled in such locations as may be directed by the Engineer.

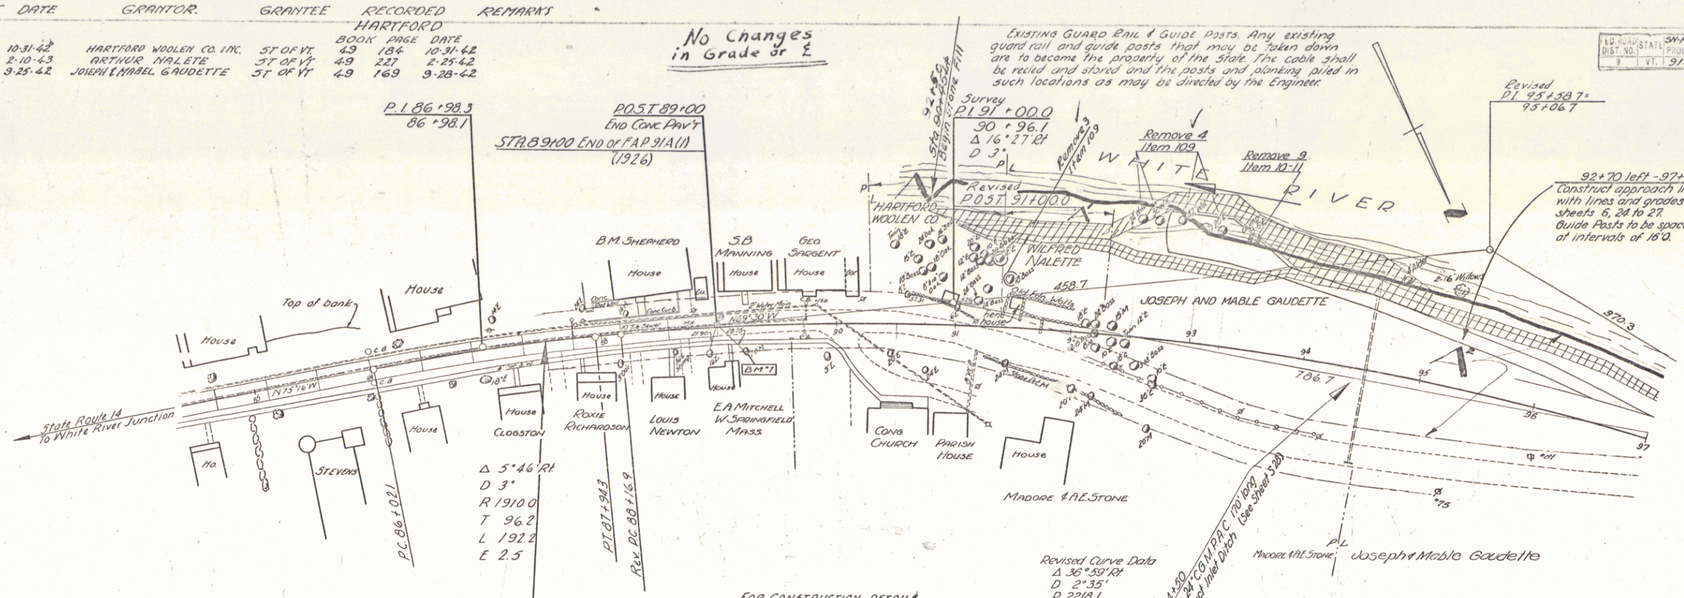

STA. 87 + 50
BEGINNING OF F.A.I. 91(7) =
STA. 87+50 OF F.A.P. 91-A (1926)

FOR CONSTRUCTION DETAILS BETWEEN STA. 86+50.0 - STA. 93+00.0 SEE SHEET 5 OF 53 SHEETS

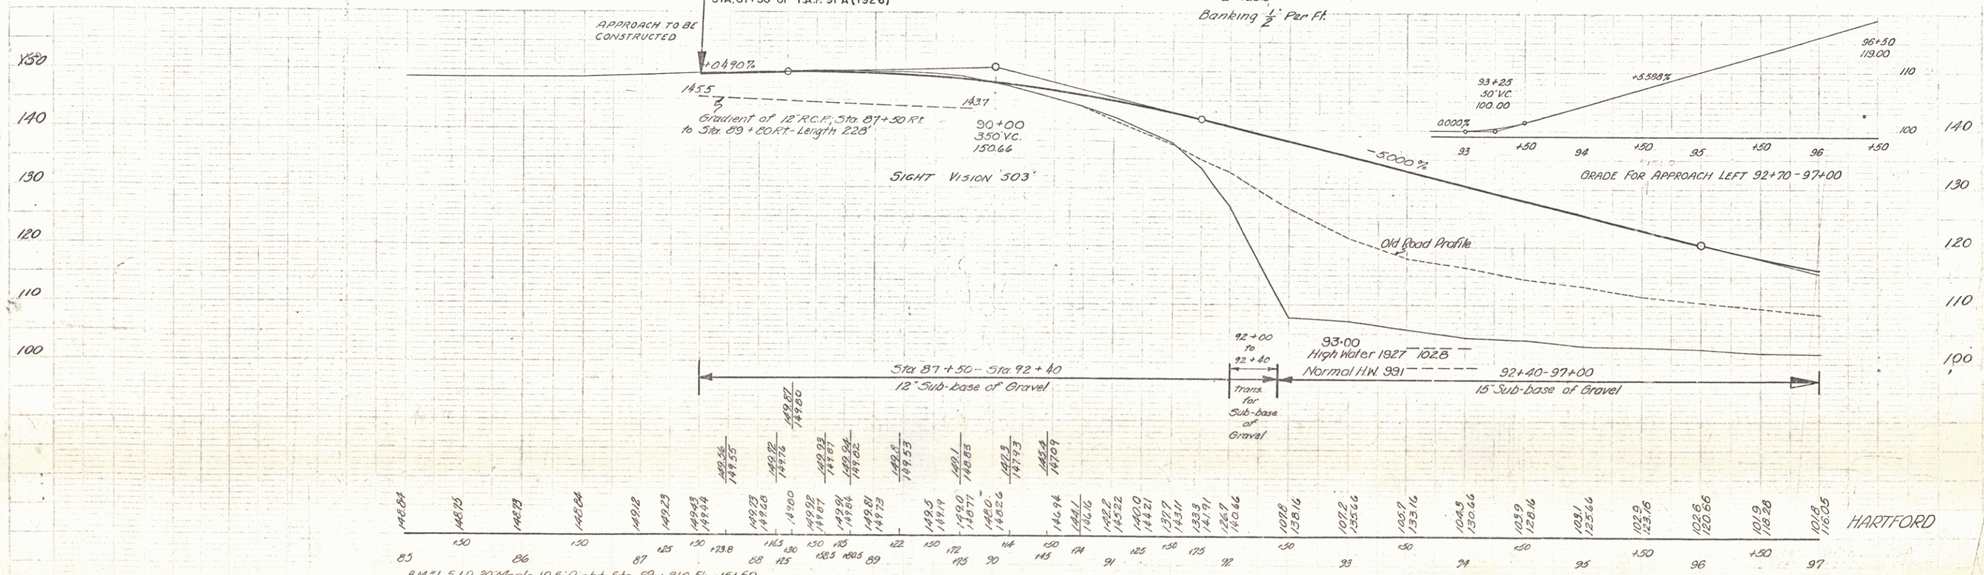

BM #1 5" I.P. 20' Maple 19.5' Right Sta. 89 + 21.0 Elev. 151.59

Series SN-FAI No. 91(7)
Sheet 6 of 53 Sheets

4