PARCEL	INSTRUMENT	DATE	GRANTOR	GRANTEE	RECORDED HARTFORD BOOK	PAGE	DATE	REMARKS
R.B.	W.D.O.E.	9-25-42	WAYNE M BURNHAM	ST OF VT	43	160	9-28-42	

F.D. ROAD DIST. NO.	STATE	SN-FAI PROJ. NO.	FISCAL YEAR	SHEET NO.	TOTAL SHEETS
2	VT	91(7)	1943	9	53

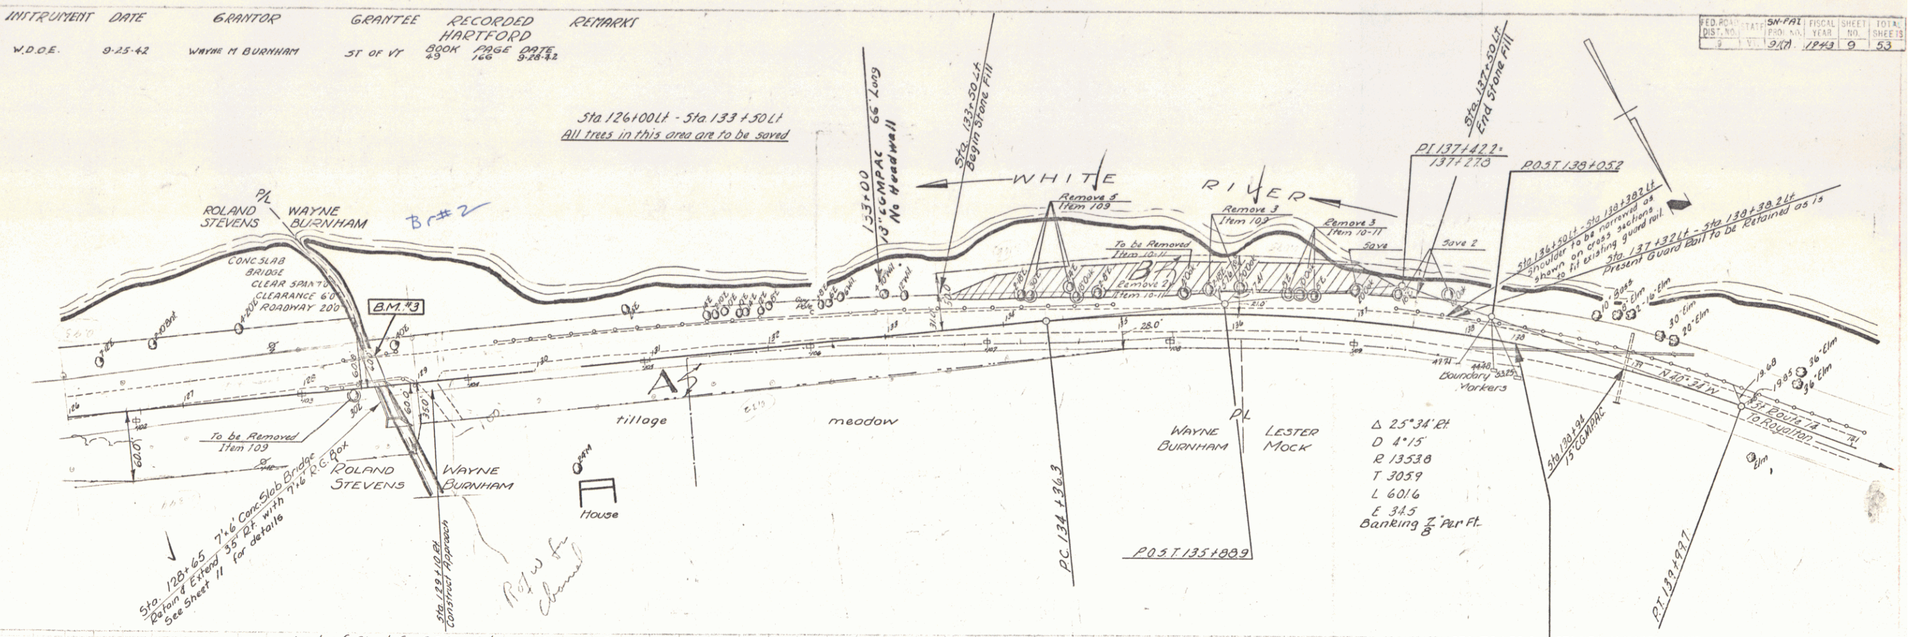

8