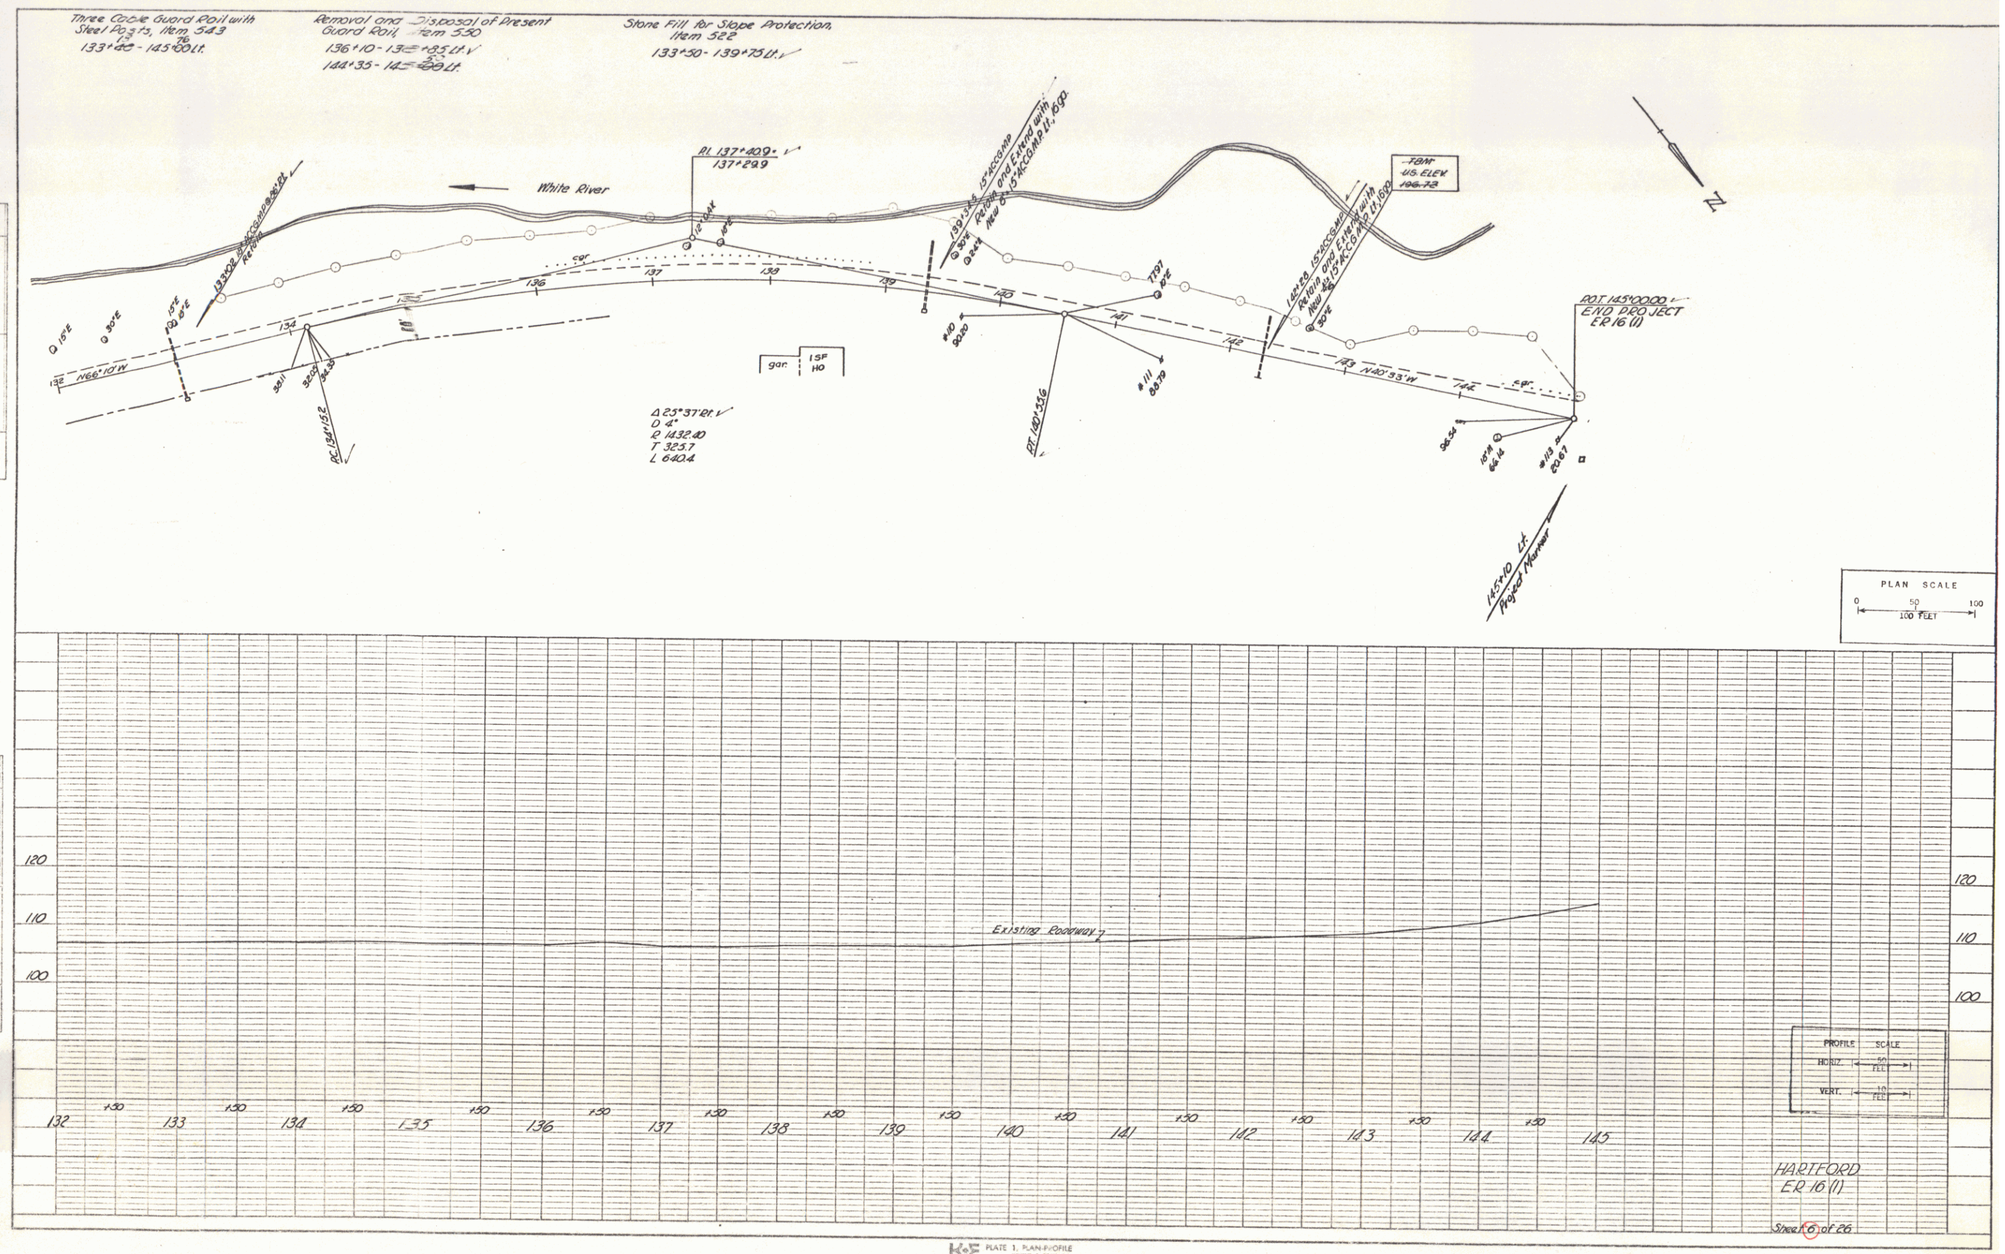


PLAN
SUBMITTED
RECOMMENDED
APPROVED
NOTE BOOK
ALIGNMENT CHECKED
NO. AT WAY CHECKED
NO.
BY Scouting
DATE 6-64

PROFILE
SUBMITTED
RECOMMENDED
APPROVED
NOTE BOOK
NO.
DATE

K+E PLATE 1. PLAN-PROFILE
KEUFFEL & ESSER CO.
46 7012 IMPERIAL™ TRACING CLOTH

4