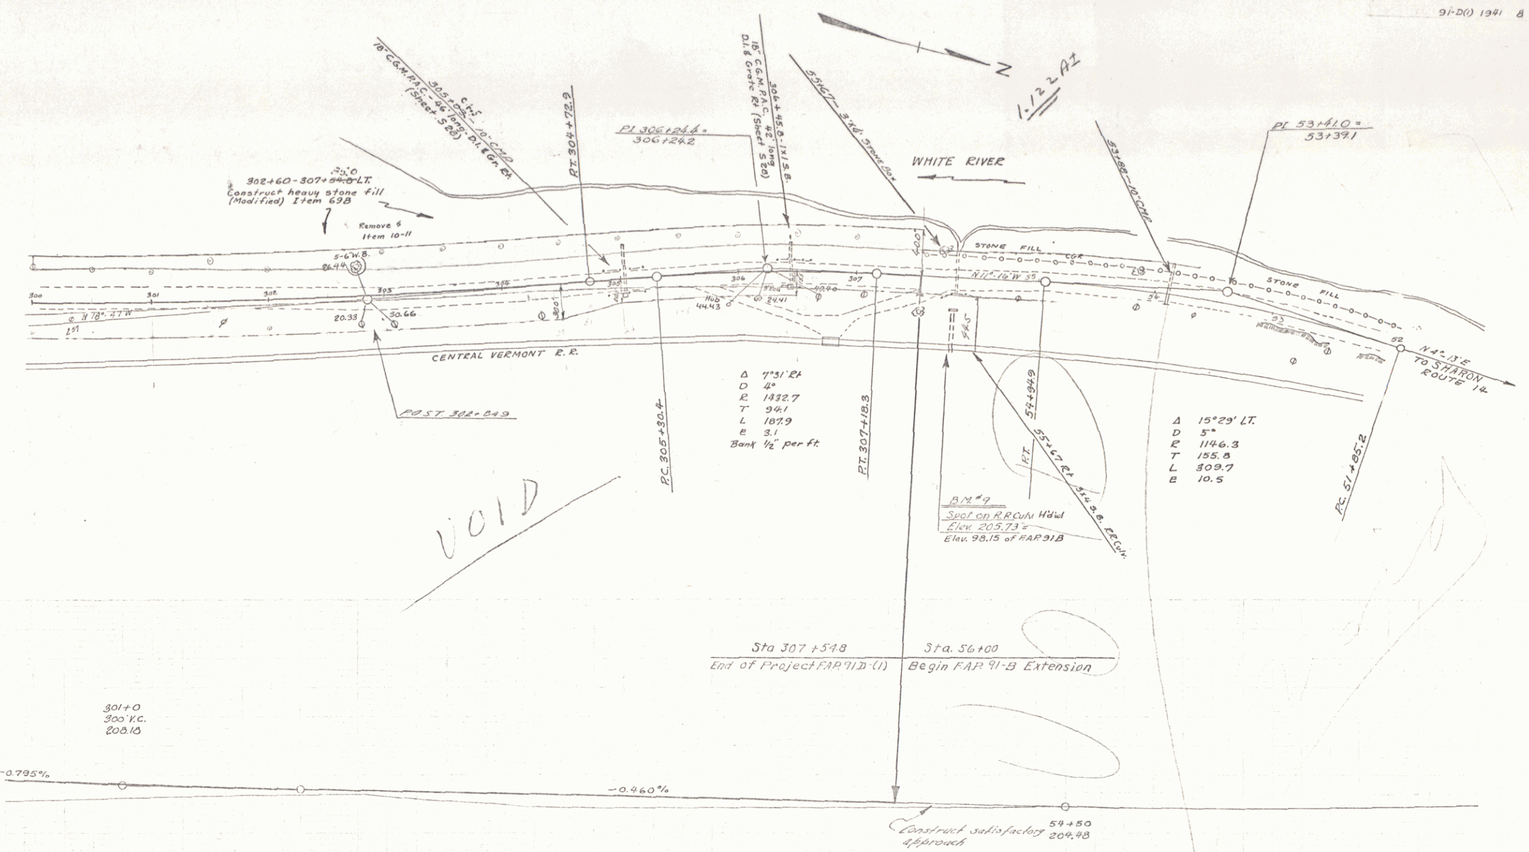

B.M. #9 SPOT ON R.R. CULVERT HEADWALL 29' RT. OF STA. 53+20 FAP 91B ELEV. 205.73

HARTFORD
SERIES F.A.P. No. 91 D (1)
SHEET 8 OF 84 SHEETS

6