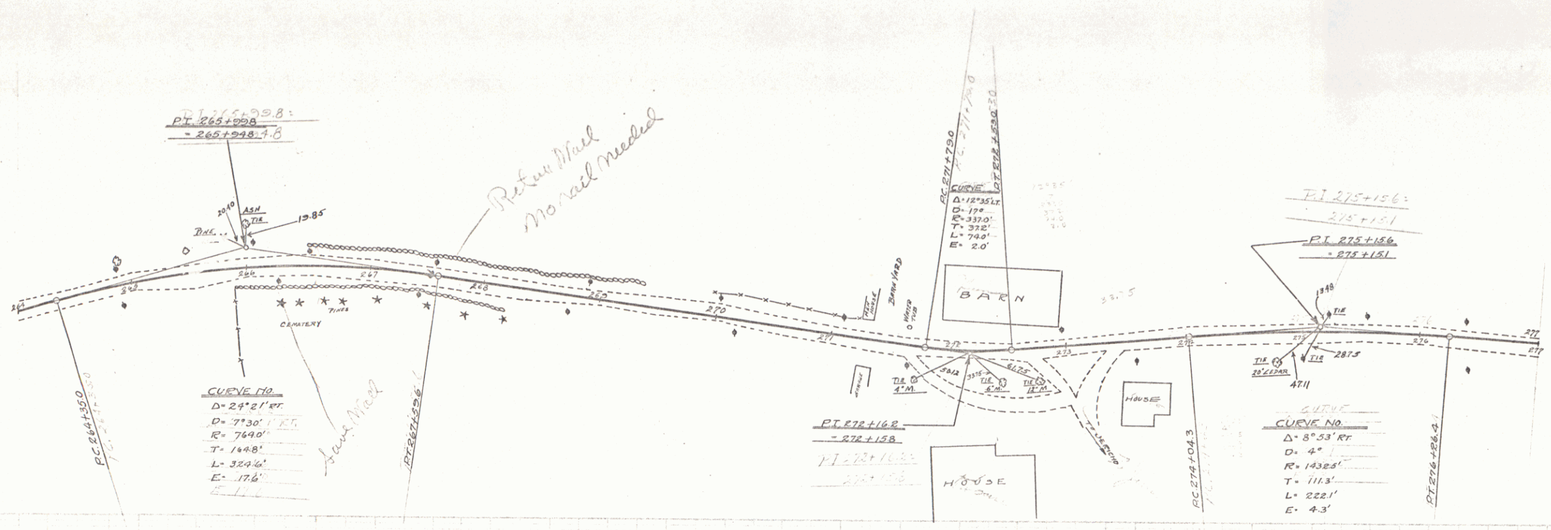
P.T. 265+998.8
= 265+948.4
Retaining Wall
No rail needed
ASH
TIE
19.85'
DWL.
CEMETERY
CURVE NO.
Δ= 24°21' RT.
D= 7°30'
R= 764.0'
T= 164.8'
L= 324.6'
E= 17.6'
Low Wall
P.C. 264+350
P.T. 267+256
P.C. 271+730
CURVE NO.
Δ= 12°35' LT.
T= 37.2'
L= 74.0'
E= 2.0'
BARN
HOUSE
HOUSE
P.T. 272+162
= 272+158
P.T. 275+156
= 275+151
P.T. 275+156
= 275+151
TIE
287.5
471.1
CURVE NO.
Δ= 8°53' RT.
D= 4°
R= 1432.5'
T= 111.3'
L= 222.1'
E= 4.3'
P.C. 274+043
P.T. 276+265.4

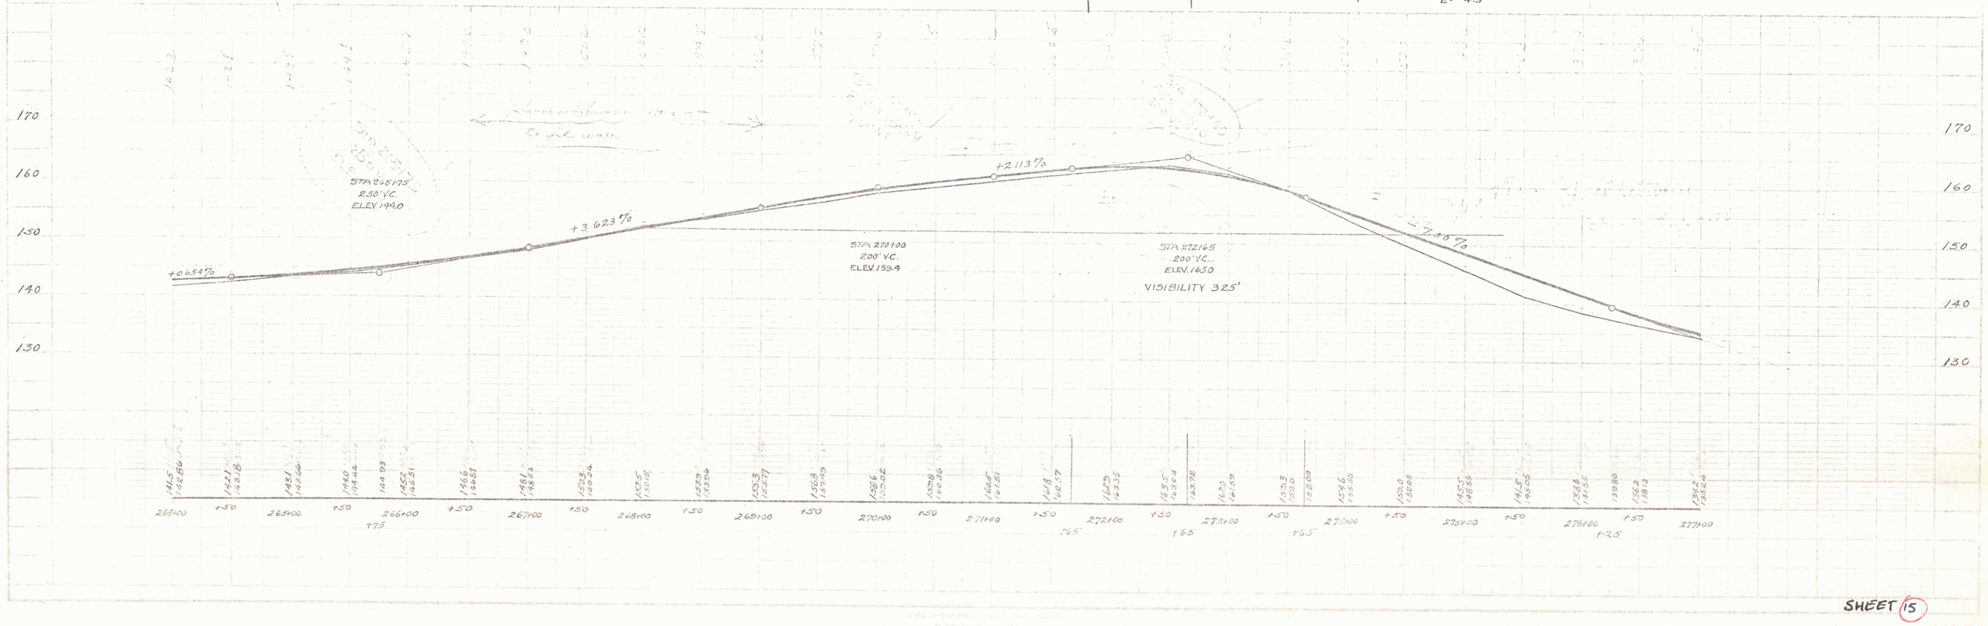
170
160
150
140
130
+0.65 %
+3.623 %
+2.113 %
-3.48 %
STA. 266+75
250' V.C.
ELEV. 149.0
STA. 270+00
200' V.C.
ELEV. 159.4
STA. 272+65
200' V.C.
VISIBILITY 325'
266+00
+75
267+00
268+00
269+00
270+00
271+00
272+00
+65
273+00
+65
274+00
+65
275+00
276+00
+25
277+00

SHEET 15