14

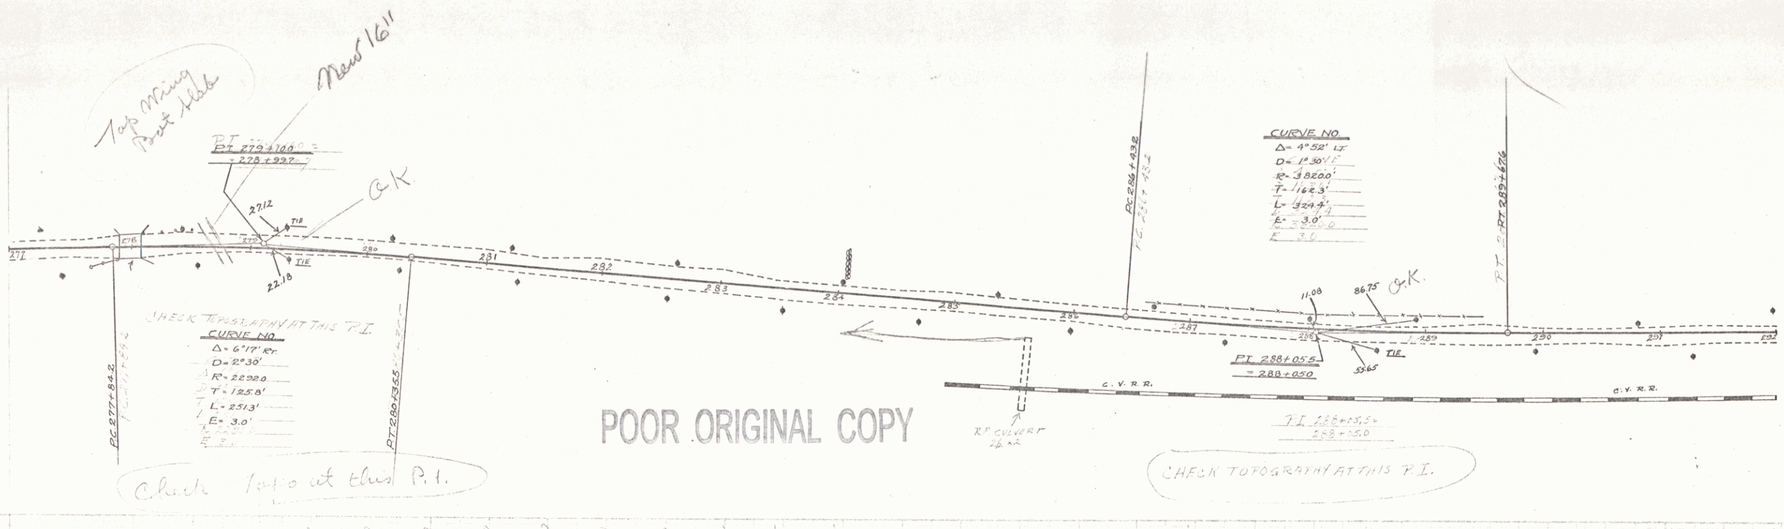

POOR ORIGINAL COPY

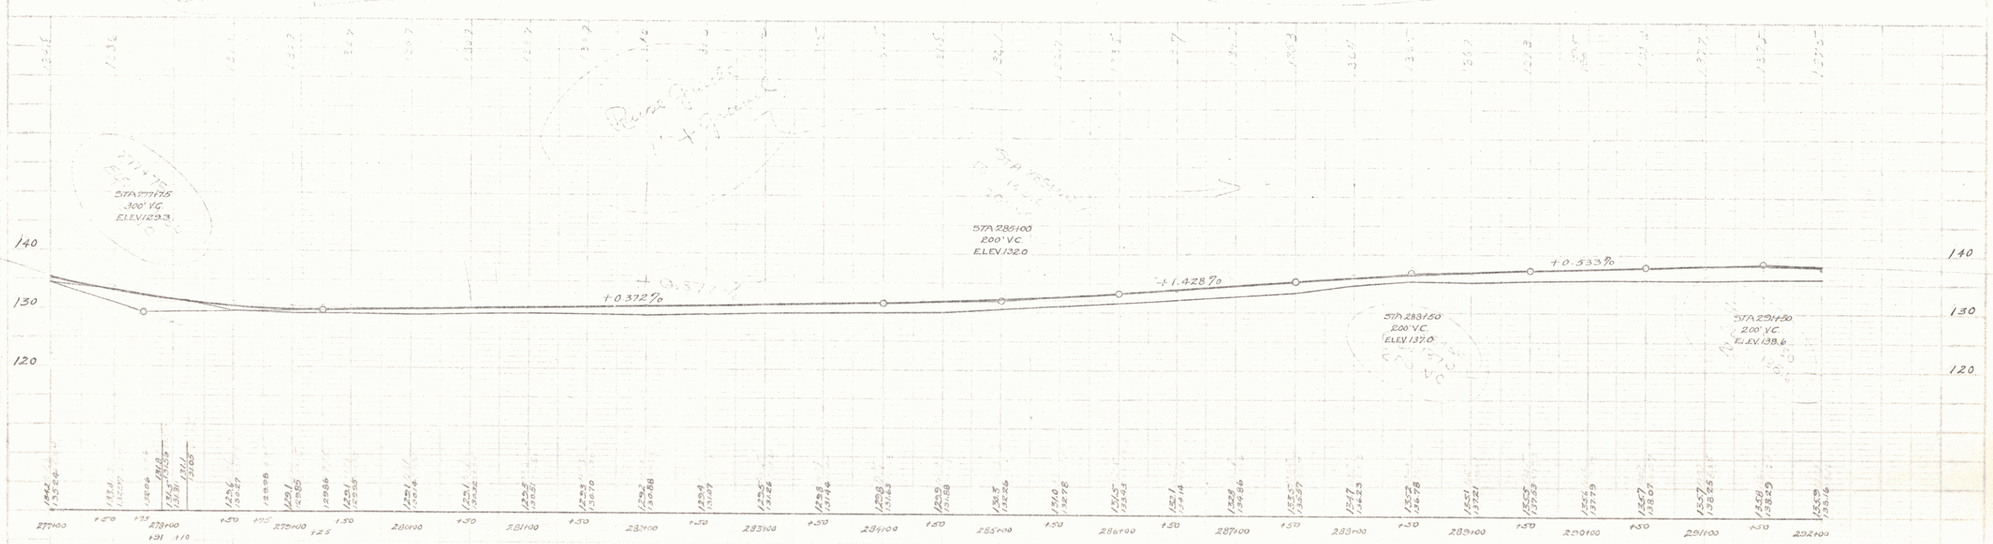

SHEET 16

20