15

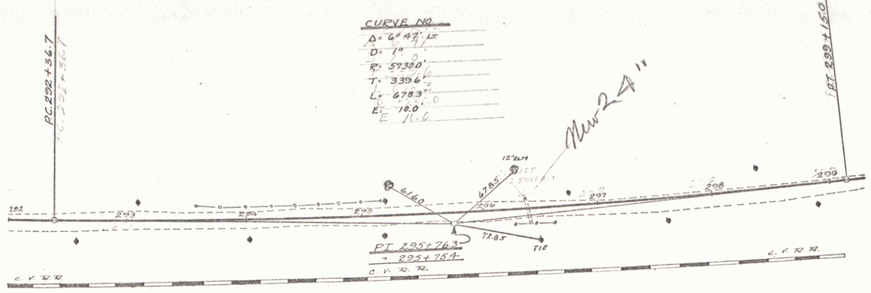

POOR ORIGINAL COPY

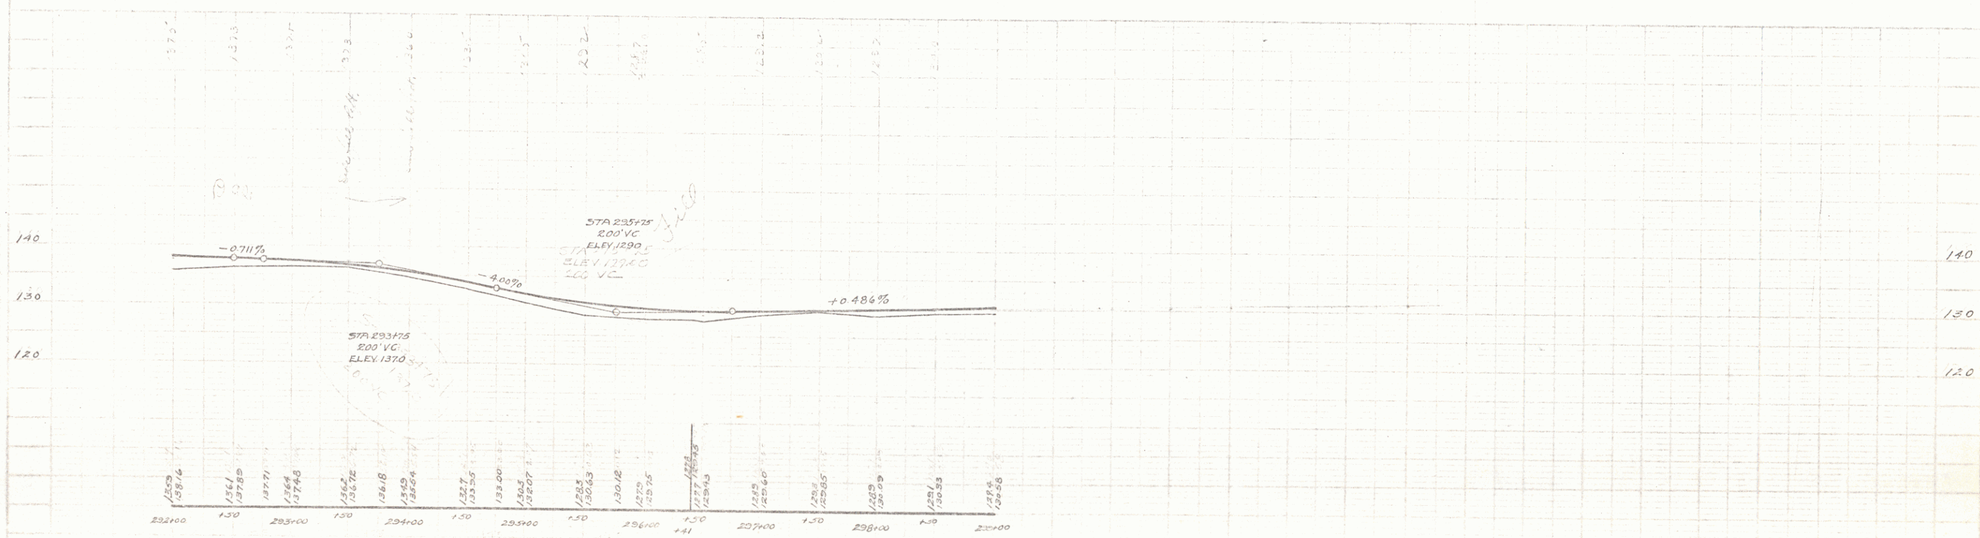

SHEET 17

21