19

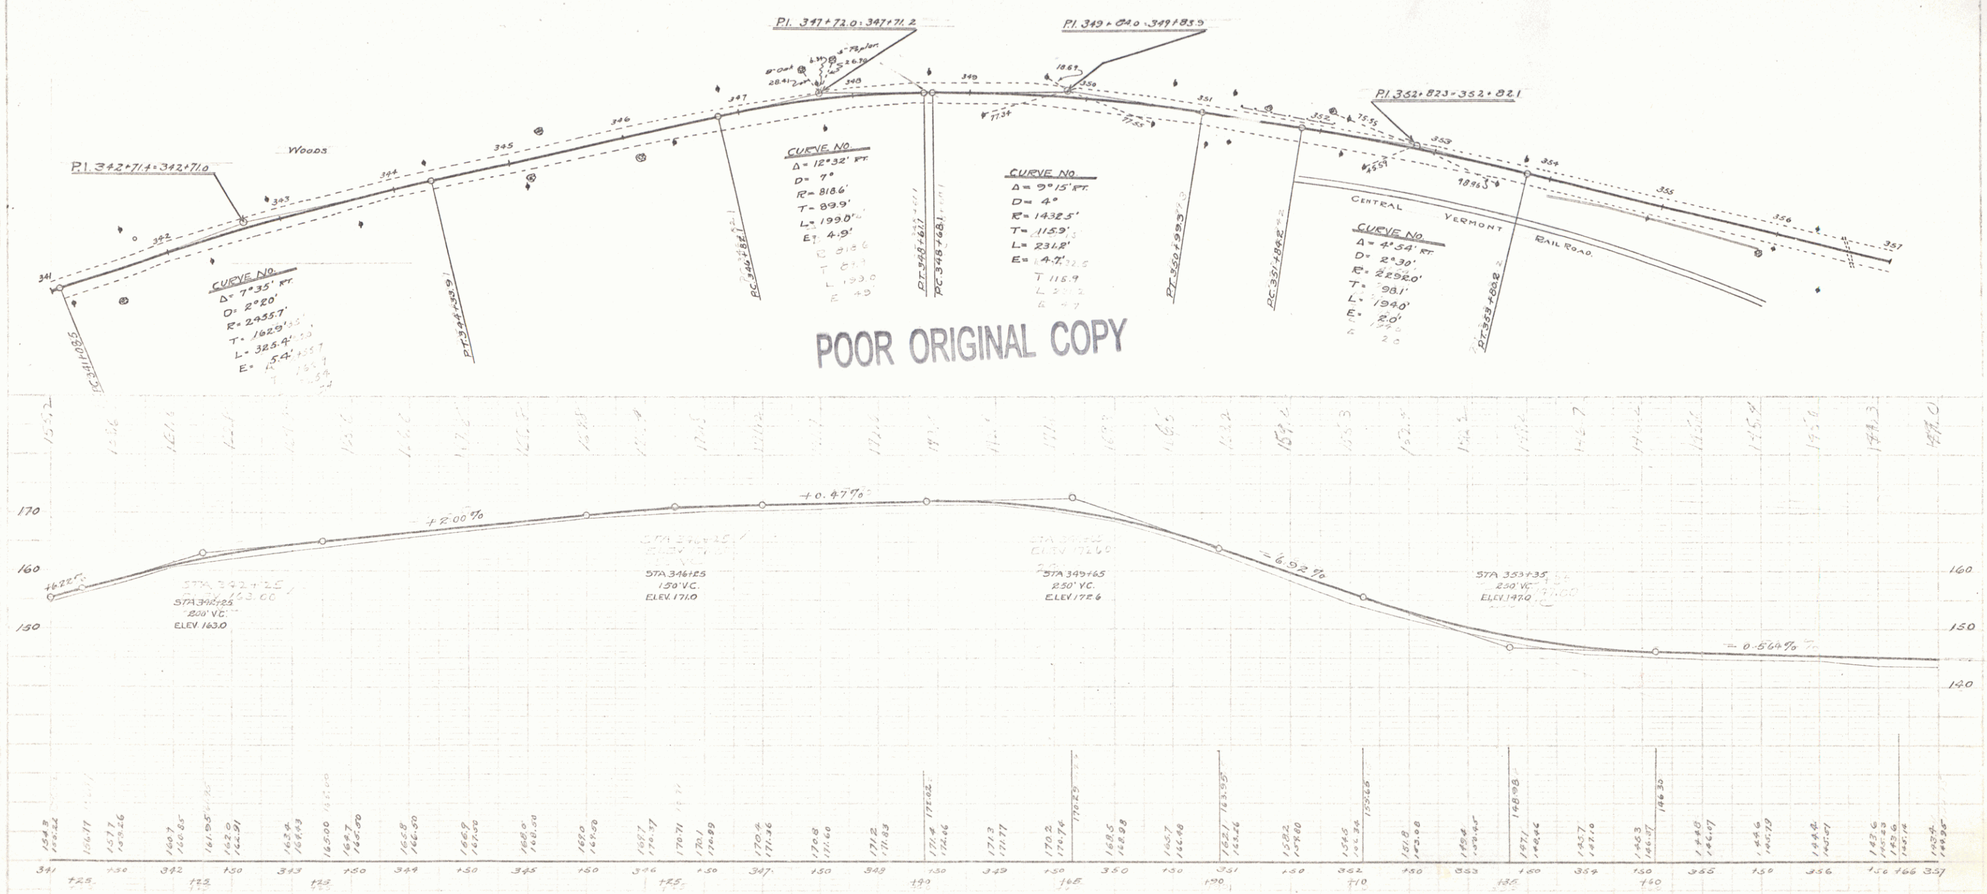

SHEET 21

25