FED. ROAD DIST. No. 9 | STATE | COUNTY | PROJECT NO. FR 6A 1928 - B | SHEET NO. 79

CABLE GUARD RAIL

LEFT

STA. 430+75-434+75 Length 400'

WOOD GUARD RAIL REQUIRED

LEFT

STA. 428+85 to STA. 429+12		24 Fr.
435+78 " " 436+02		24 Fr.

RIGHT

STA. 428+88 to STA. 429+12		24 Fr.
" 432+16 " " 432+87		24 Fr.
" 435+30 " " 436+02		24 Fr.

NEW CULVERTS REQUIRED

STA. 429+00	18" Reinf. Conc. Pipe Length Concrete Class A(1-2-4) Reinforcing Steel	36 Fr. 1.3 Cu.yds. 54 lbs.
STA. 432+75	15" Reinf. Conc. Pipe Length Concrete Class B(1-2½-3) Reinforcing Steel	36 Fr. 2.6 Cu.yds. 33 lbs.
STA. 435+90	15" Reinf. Conc. Pipe Length Concrete Class B(1-2½-3) Reinforcing Steel	32 Fr. 2.6 Cu.yds. 33 lbs.

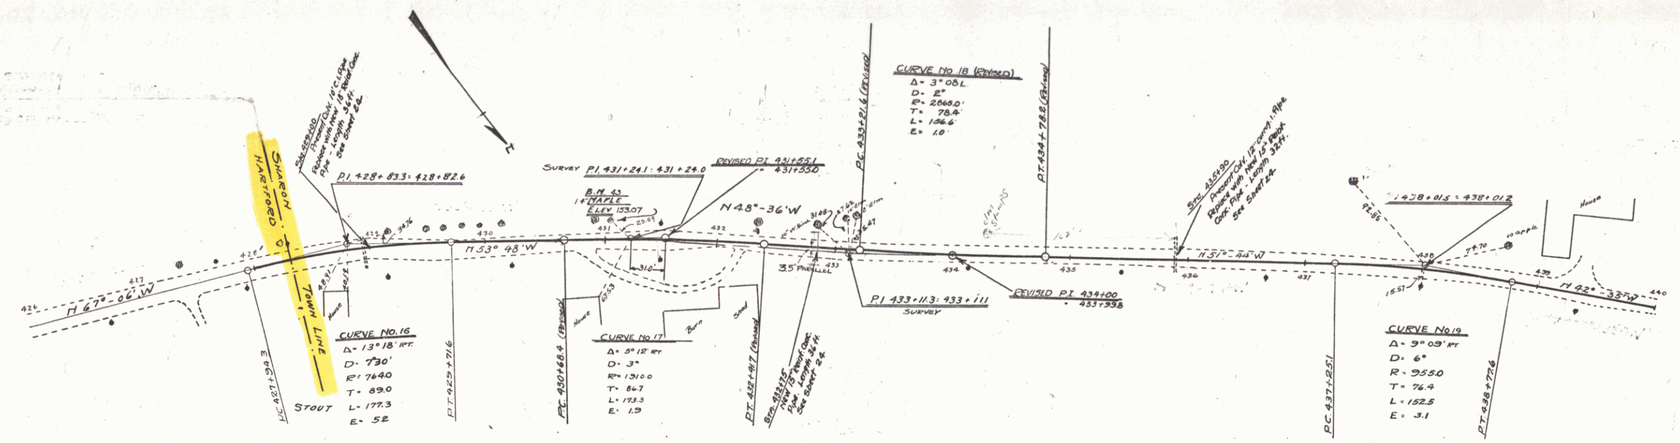

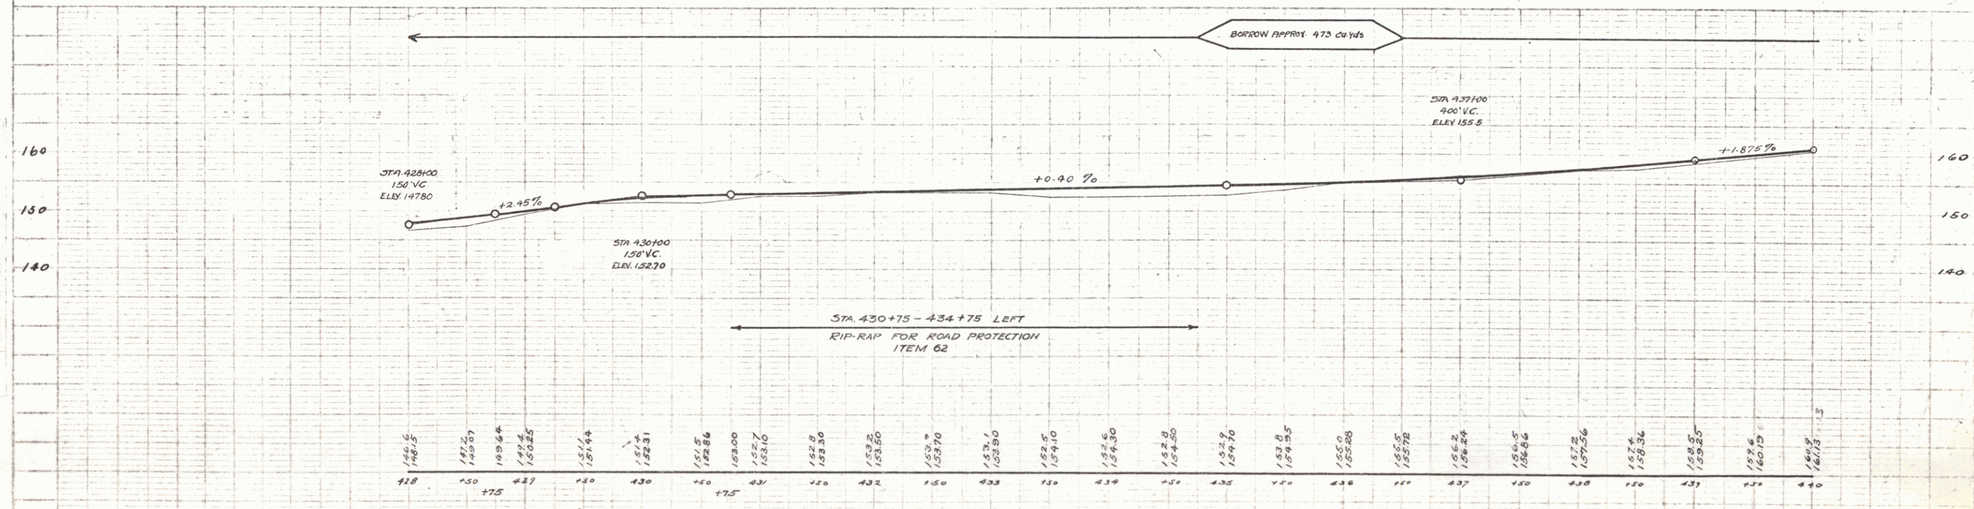

B.M. 43 14" MAPLE LEFT STA. 431+03 ELEV. 153.07

Series FR. 6A
Sheet 8 of 79

7