| FED. HWY. DIST. NO. | STATE | FED. AID PROJ. NO. | FISCAL YEAR | SHEET NO. | TOTAL SHEETS |
|---|---|---|---|---|---|
| 9 | VT. | FR 6A | 1928 | 16 | 79 |

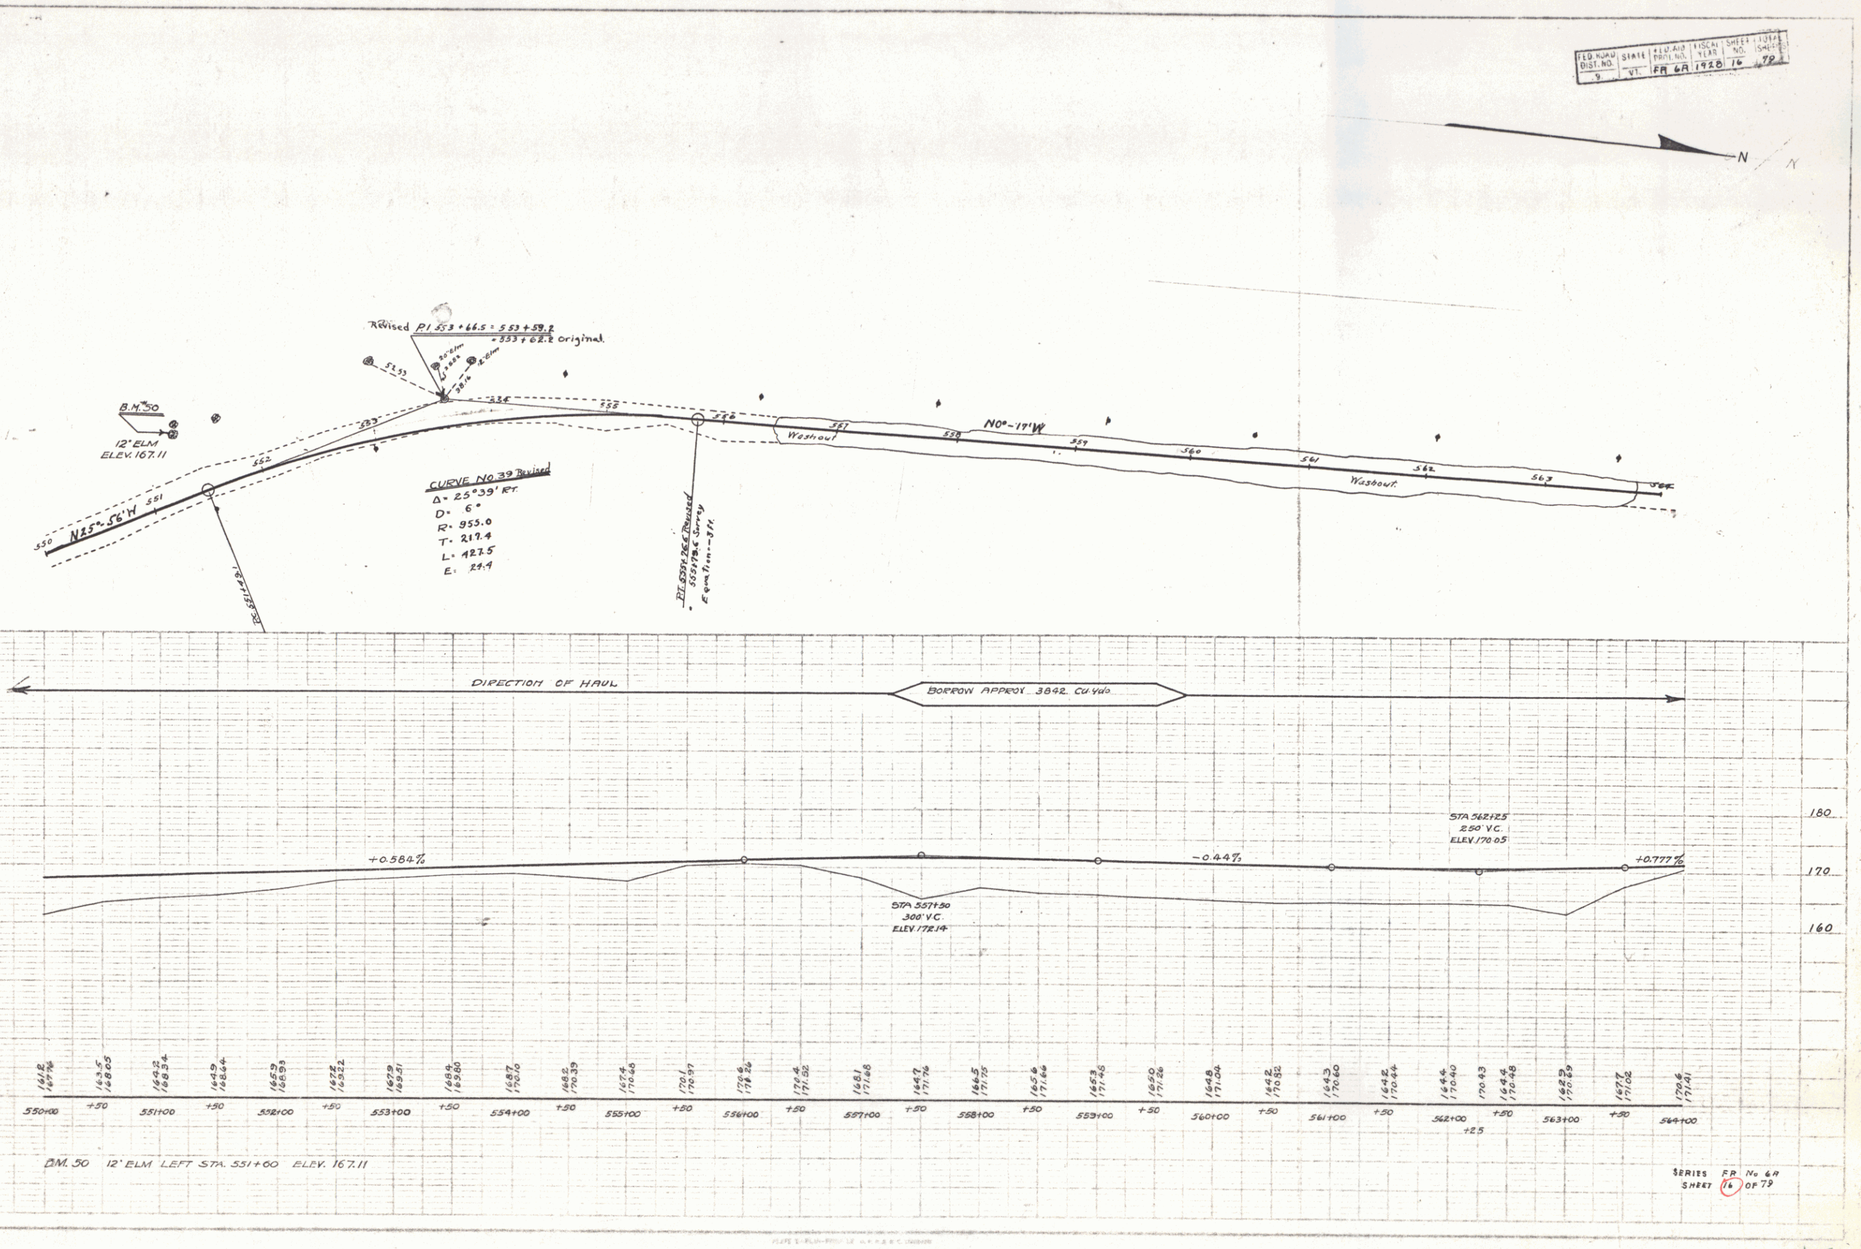


PLAN
NOTE BOOK
NO.

PROFILE
NOTE BOOK
NO.

15
16