FED. ROAD DIST. NO. | STATE | PROJECT
FR 6C 13

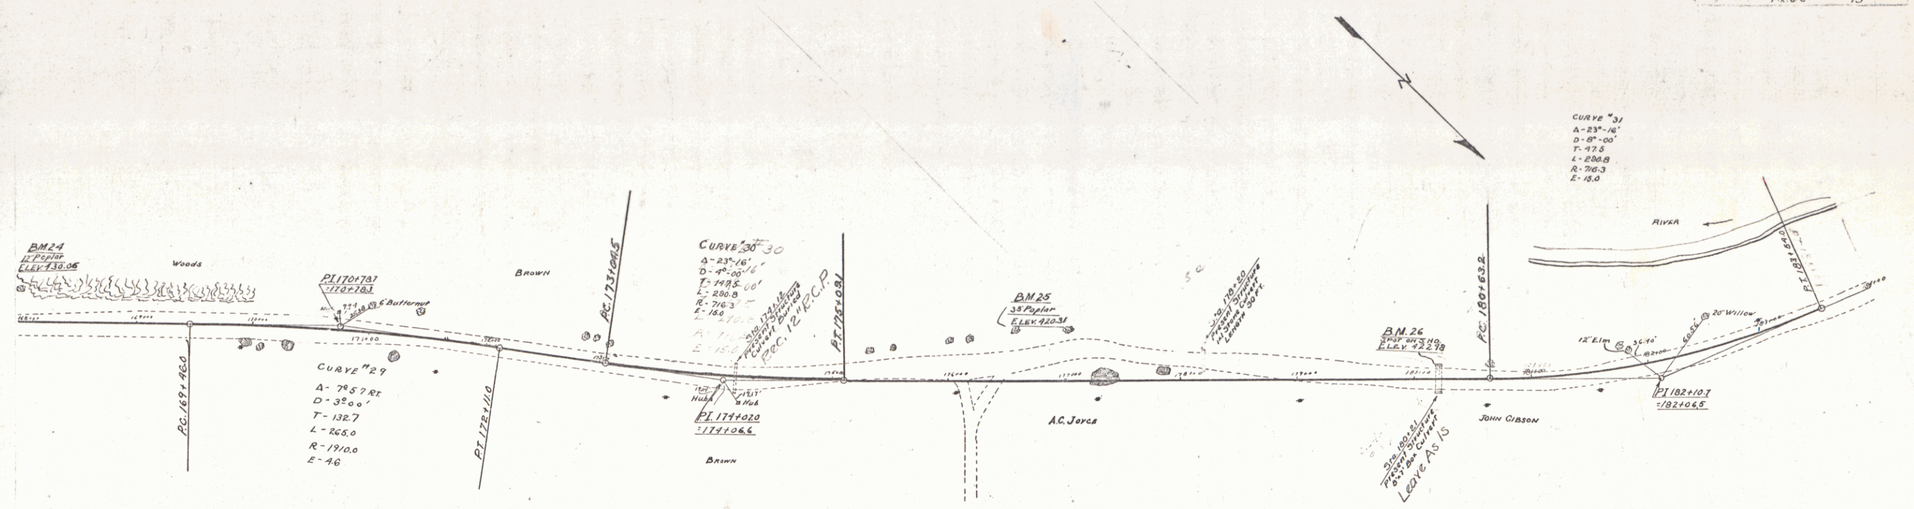


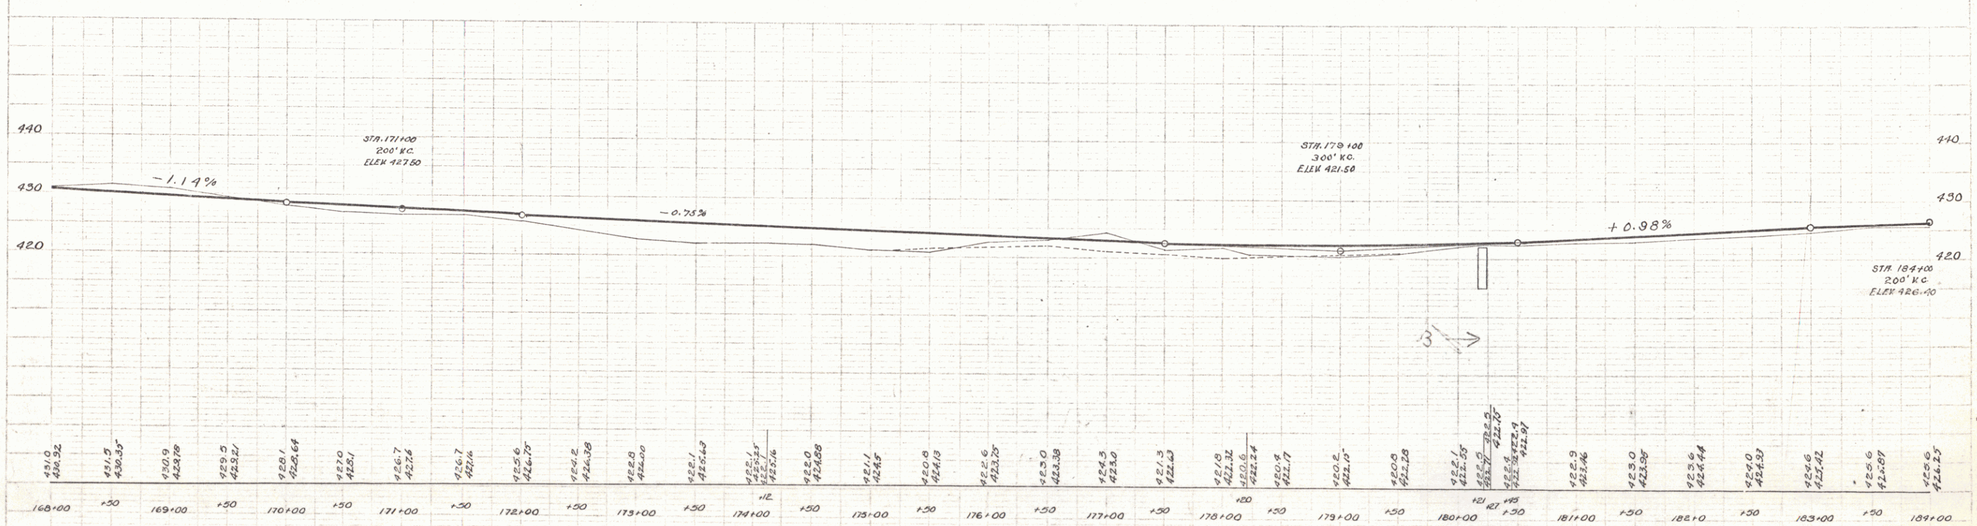


B.M. #24 SPIKE IN 12" POP. BY P. POLE 220 LEFT STA. 168+00 ~ ELEV. 430.06
B.M. #25 SPIKE IN 38" POP. OPP. SIDE RD. LEFT STA. 176+55 ~ ELEV. 420.31
B.M. #26 SPOT ON S. HEADER CONC. BOX LEFT STA. 180+24 ~ ELEV. 422.98

SERIES FR No. 6C
SHEET 13 OF

PLATE 108 PROFILE

11