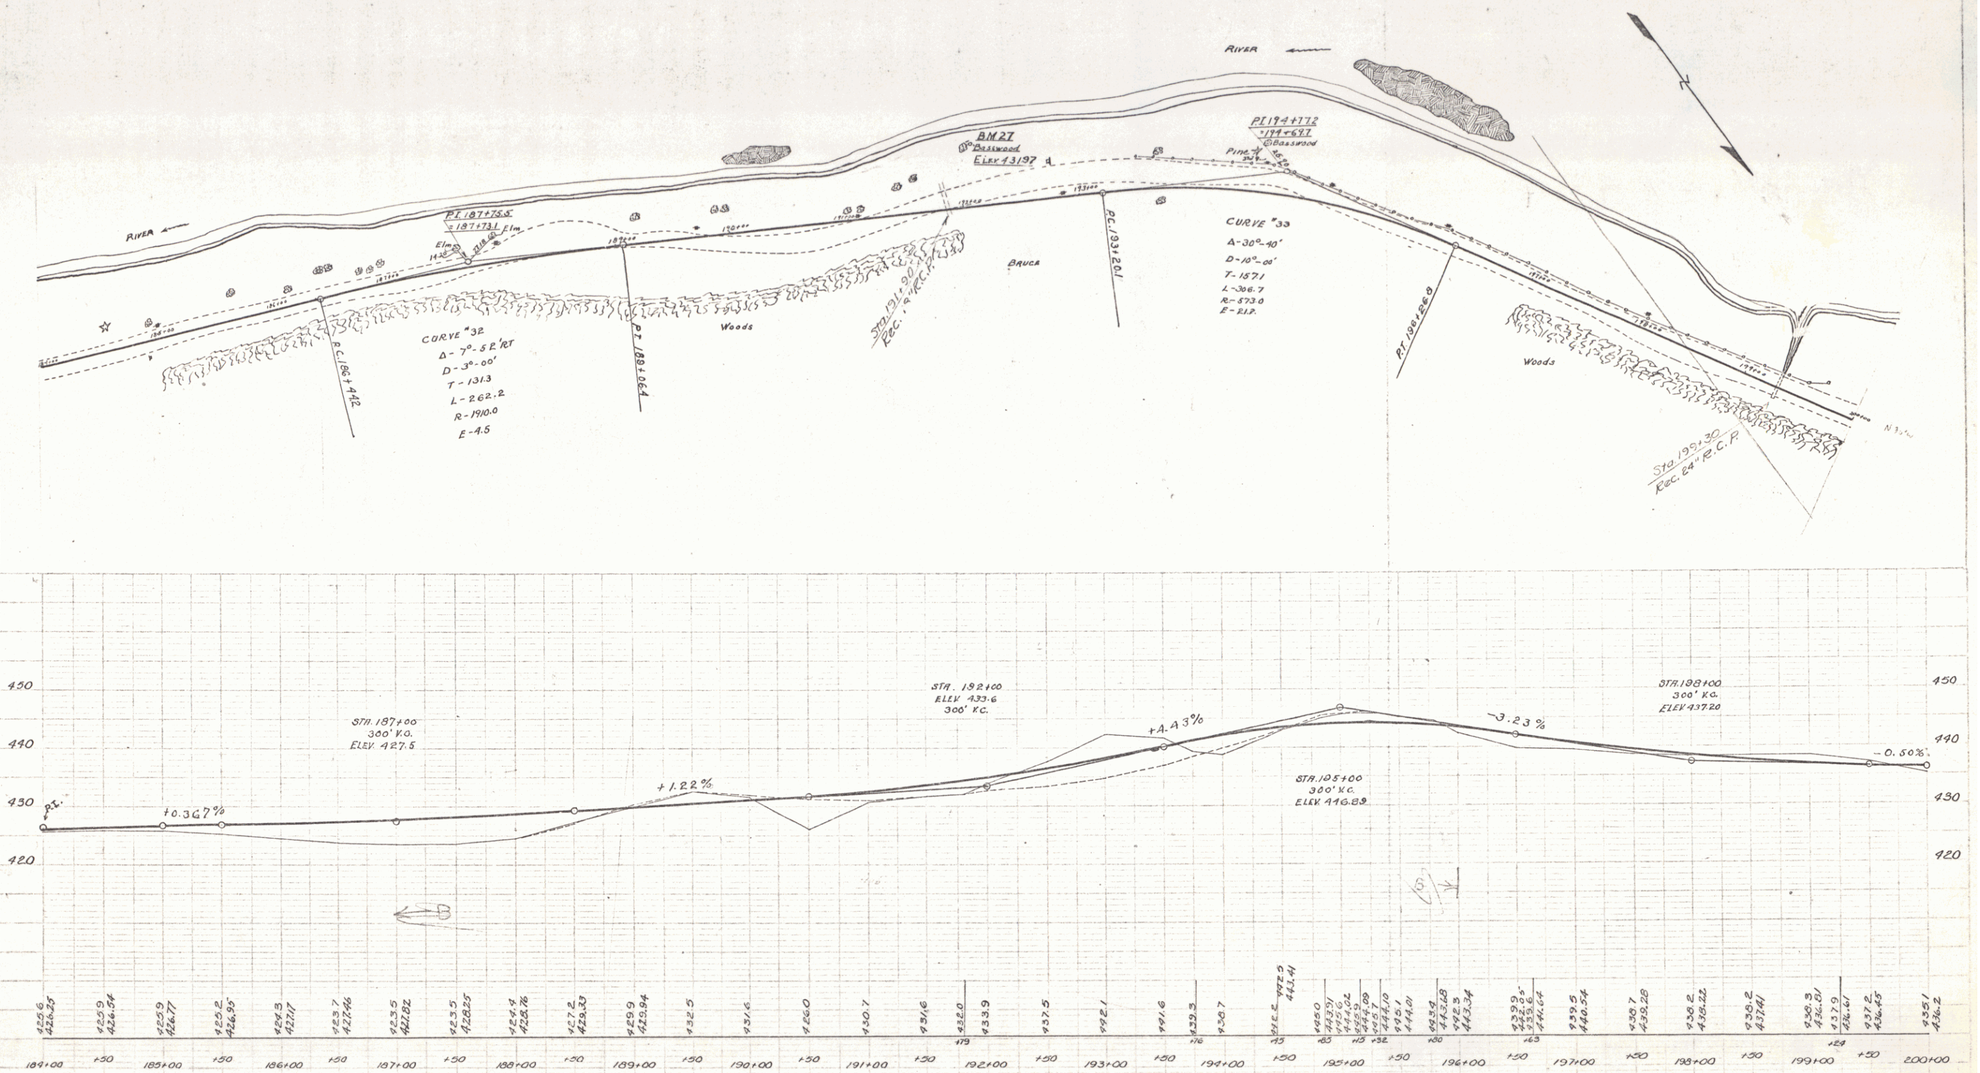

B.M. #27 SPIKE IN ROOT 10" BASS. BEFORE ROUTE 14 STEEL SIGN LEFT STA. 192+05 ~ ELEV. 431.97

SERIES F.R. No 6C
SHEET 14 OF