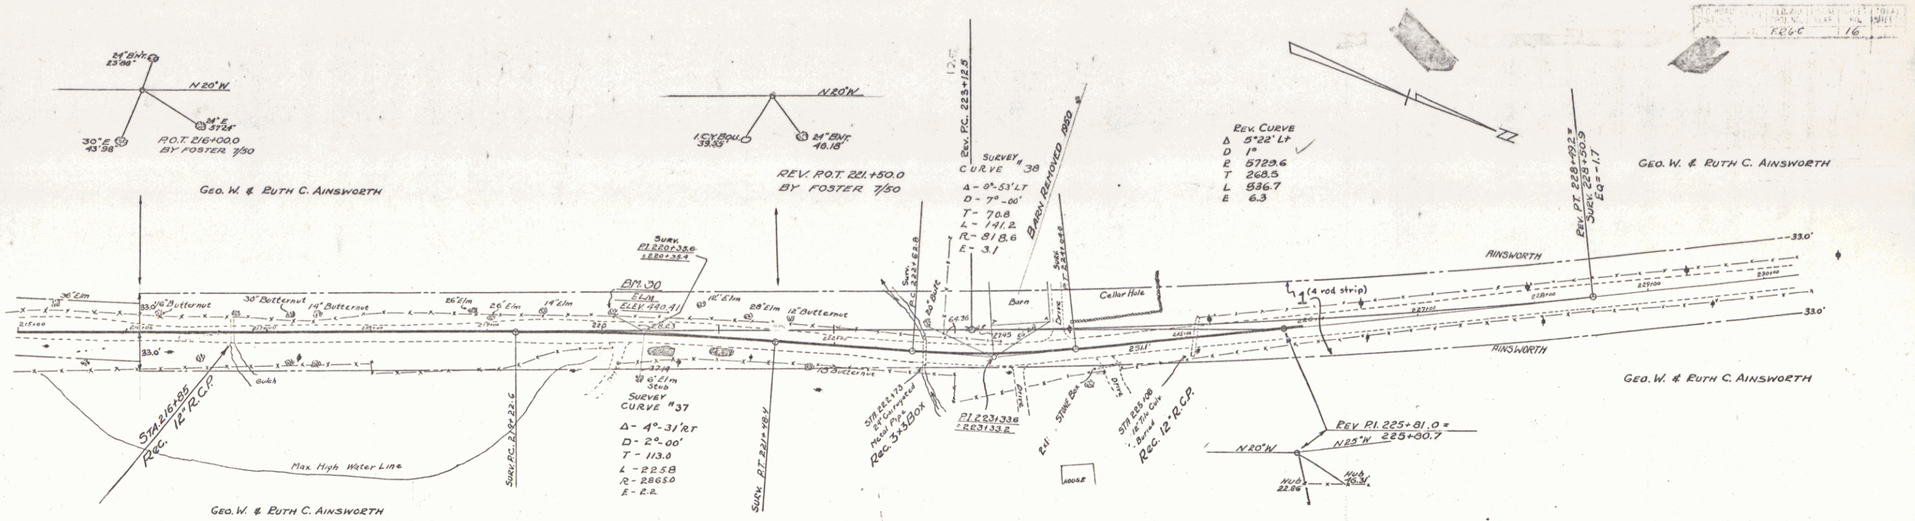

PARCEL	INSTRUMENT	DATE	GRANTOR	GRANTEE	RECORDED SHARON BK.	PAGE	DATE
1	WDOE	7/6/49	GEORGE W. & RUTH C AINSWORTH	ST. OF VT.			

Survey 8/28
Revised 7/50

FOSTER

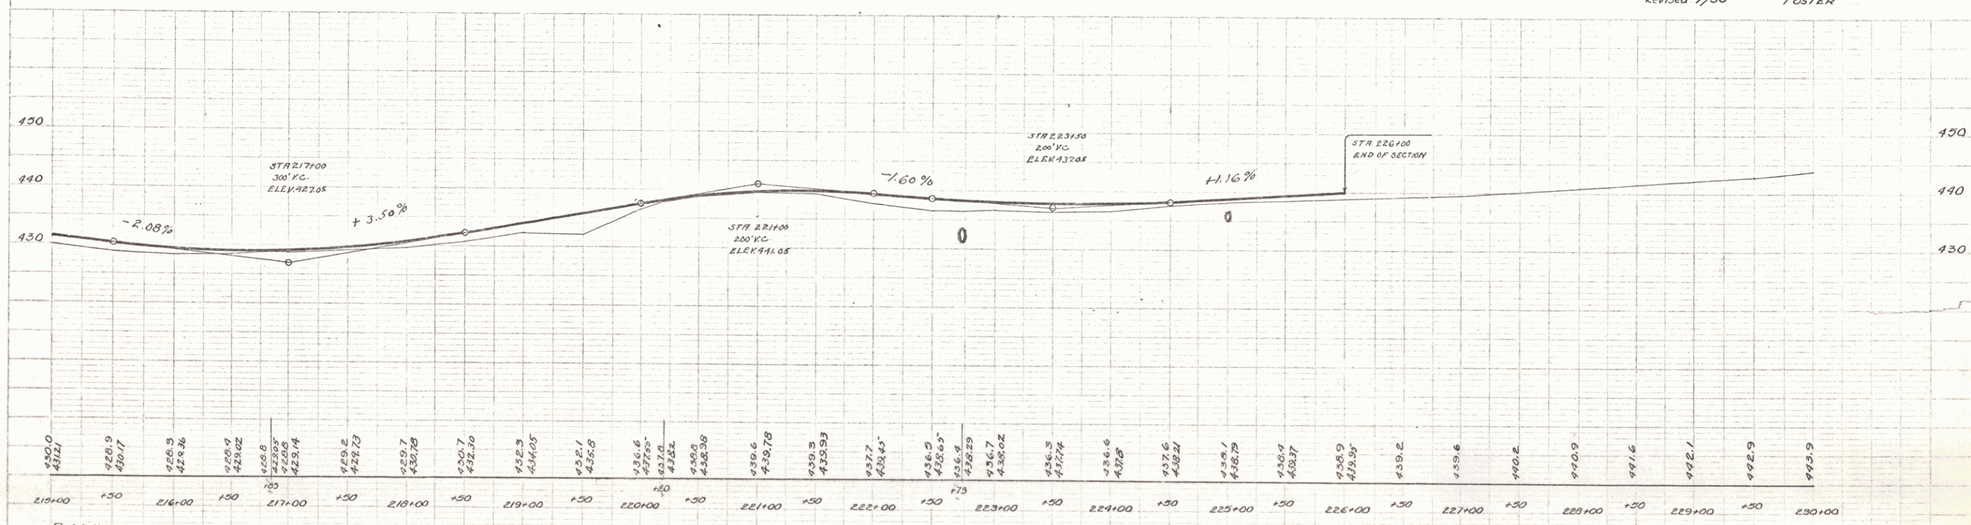

BM. #30 SPIKE IN ROOT 30" ELM LEFT STA. 220+10 ~ ELEV. 440.41

SERIES FR No 6C
SHEET 16 OF