


1	27100	0
2		
3		
4		

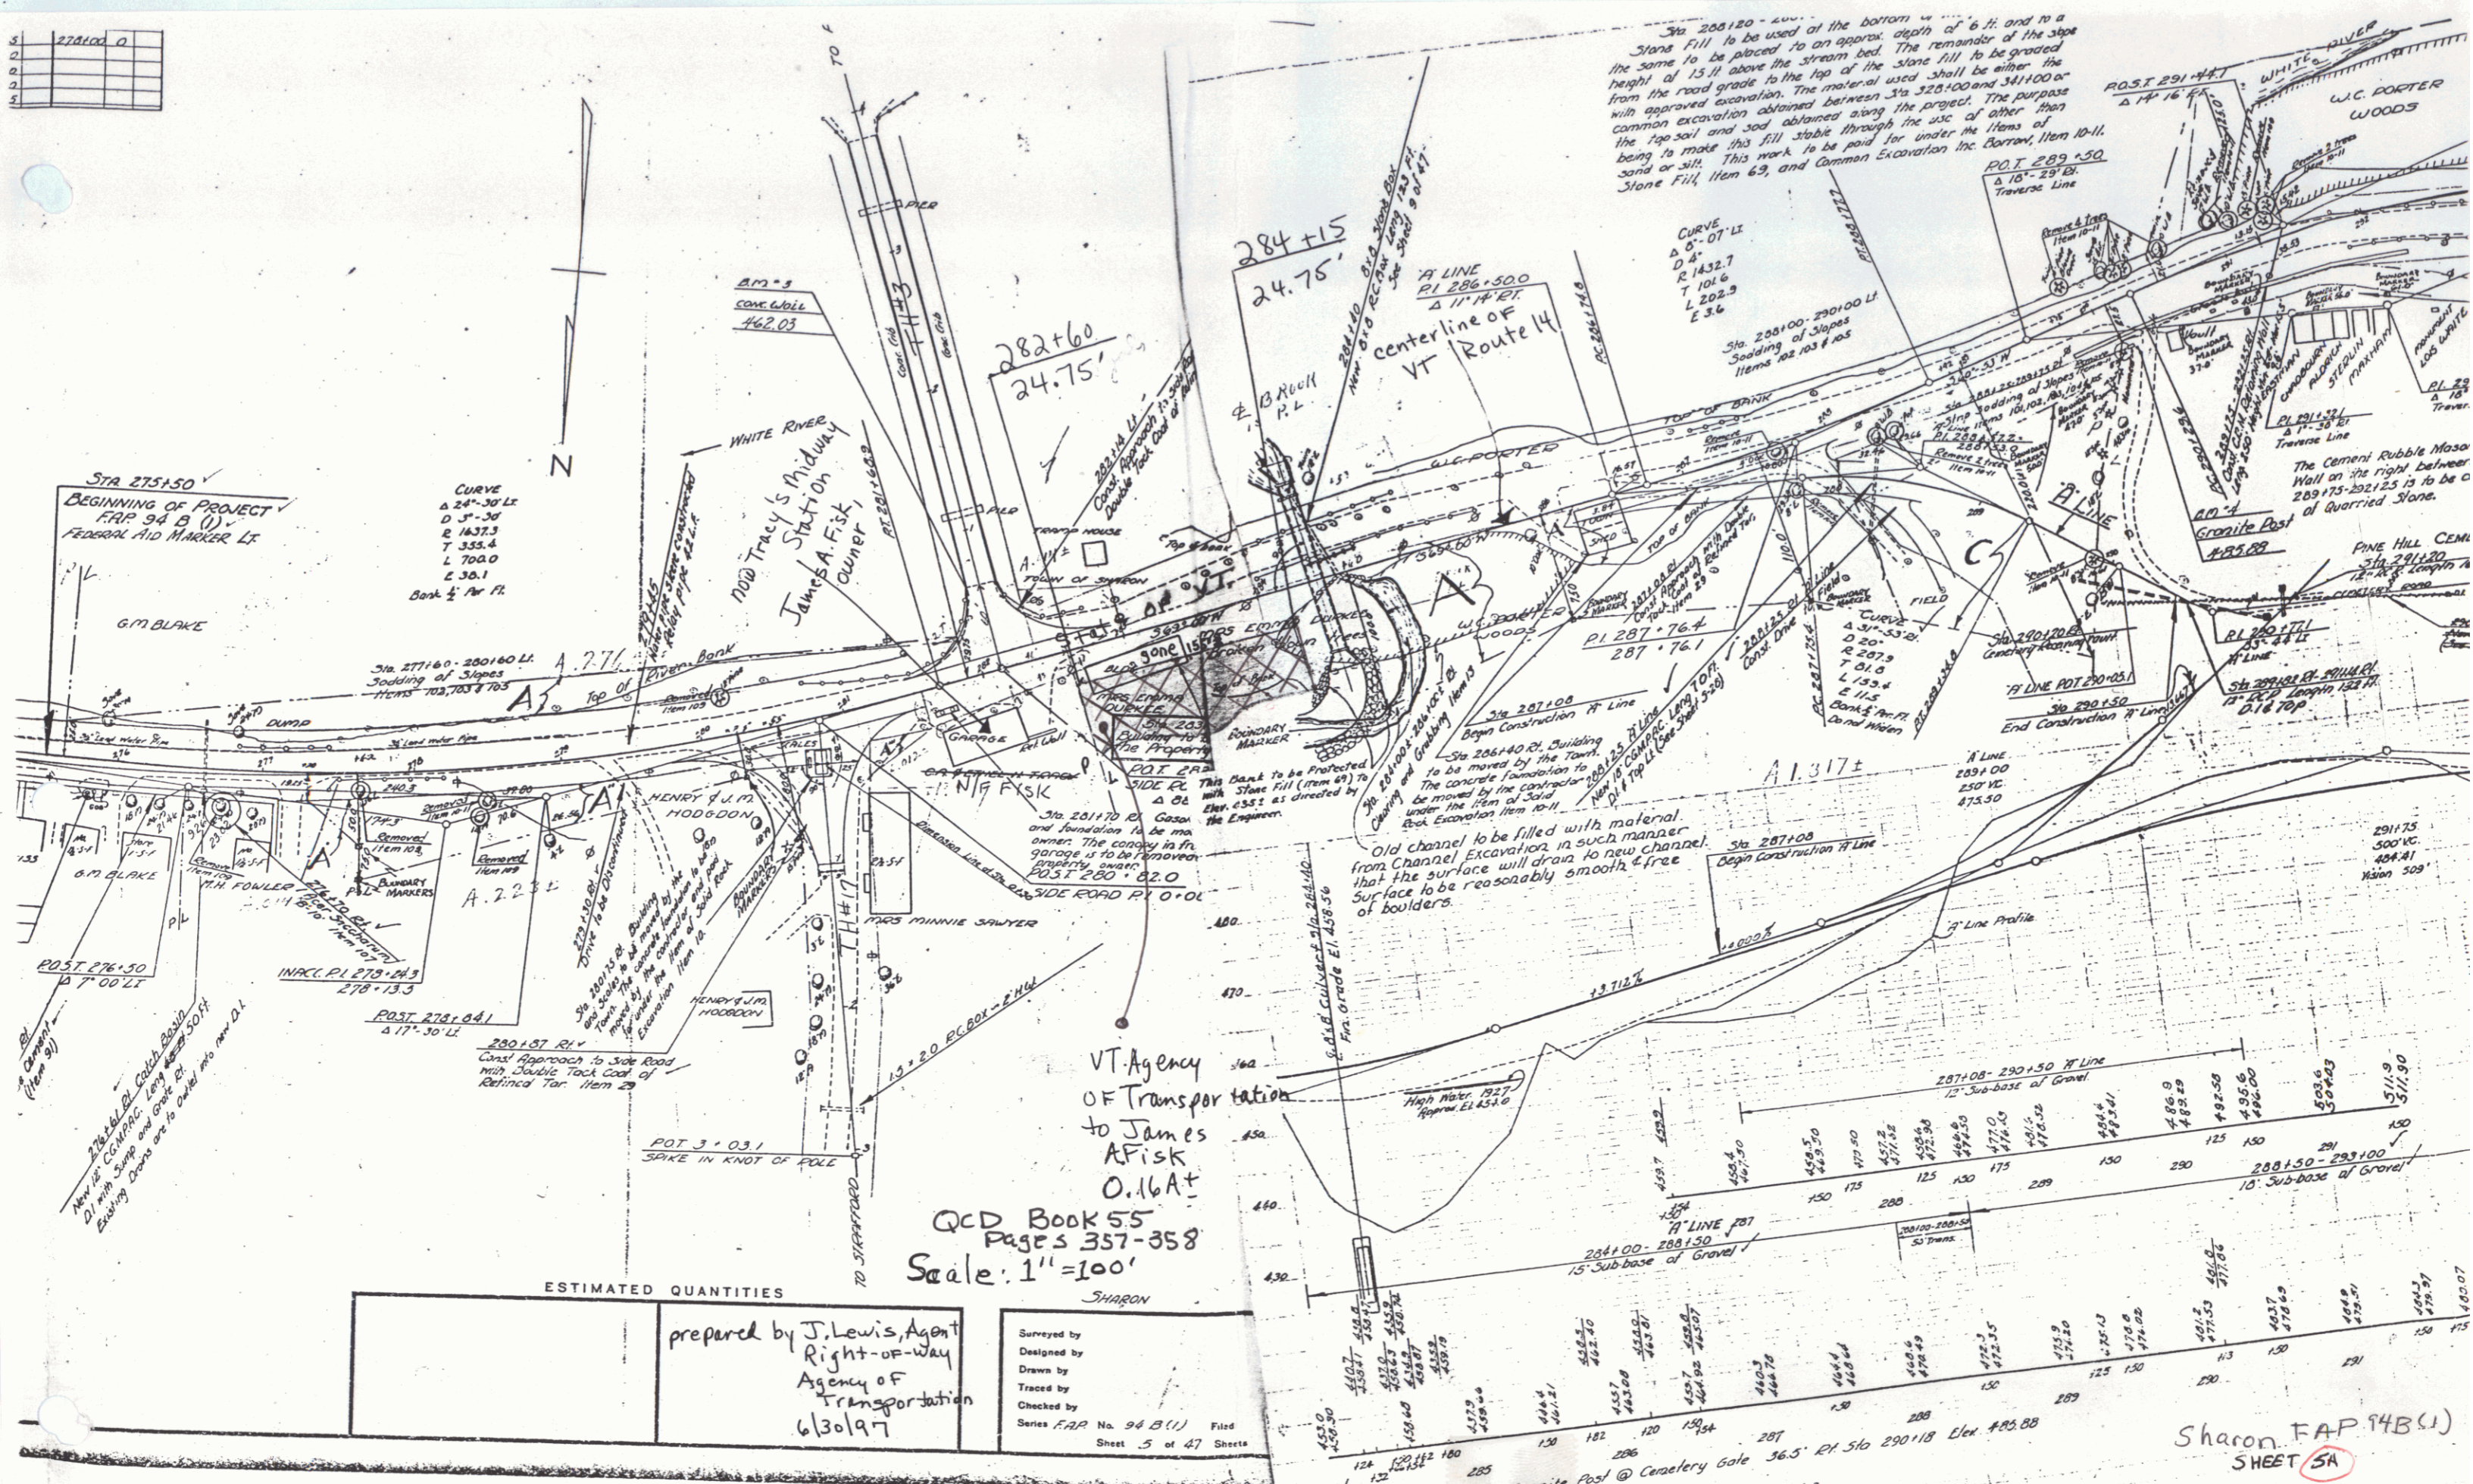

VT. Agency  
 of Transportation  
 to James  
 A. Fisk  
 O.16A+

QCD Book 55  
 Pages 357-358  
 Scale: 1" = 100'

ESTIMATED QUANTITIES	
prepared by J. Lewis, Agent Right-of-Way Agency of Transportation 6/30/97	Surveyed by Designed by Drawn by Traced by Checked by Series F.A.P. No. 94 B(1) Filed Sheet 5 of 47 Sheets

Sharon F.A.P. 14B(1)  
 SHEET 5A