


PLAN  
 DATE: 11-30  
 DRAWN BY: Rogers  
 CHECKED BY: [blank]  
 PROJECT: [blank]

PROFILE  
 DATE: 11-30  
 DRAWN BY: Rogers  
 CHECKED BY: [blank]  
 PROJECT: [blank]

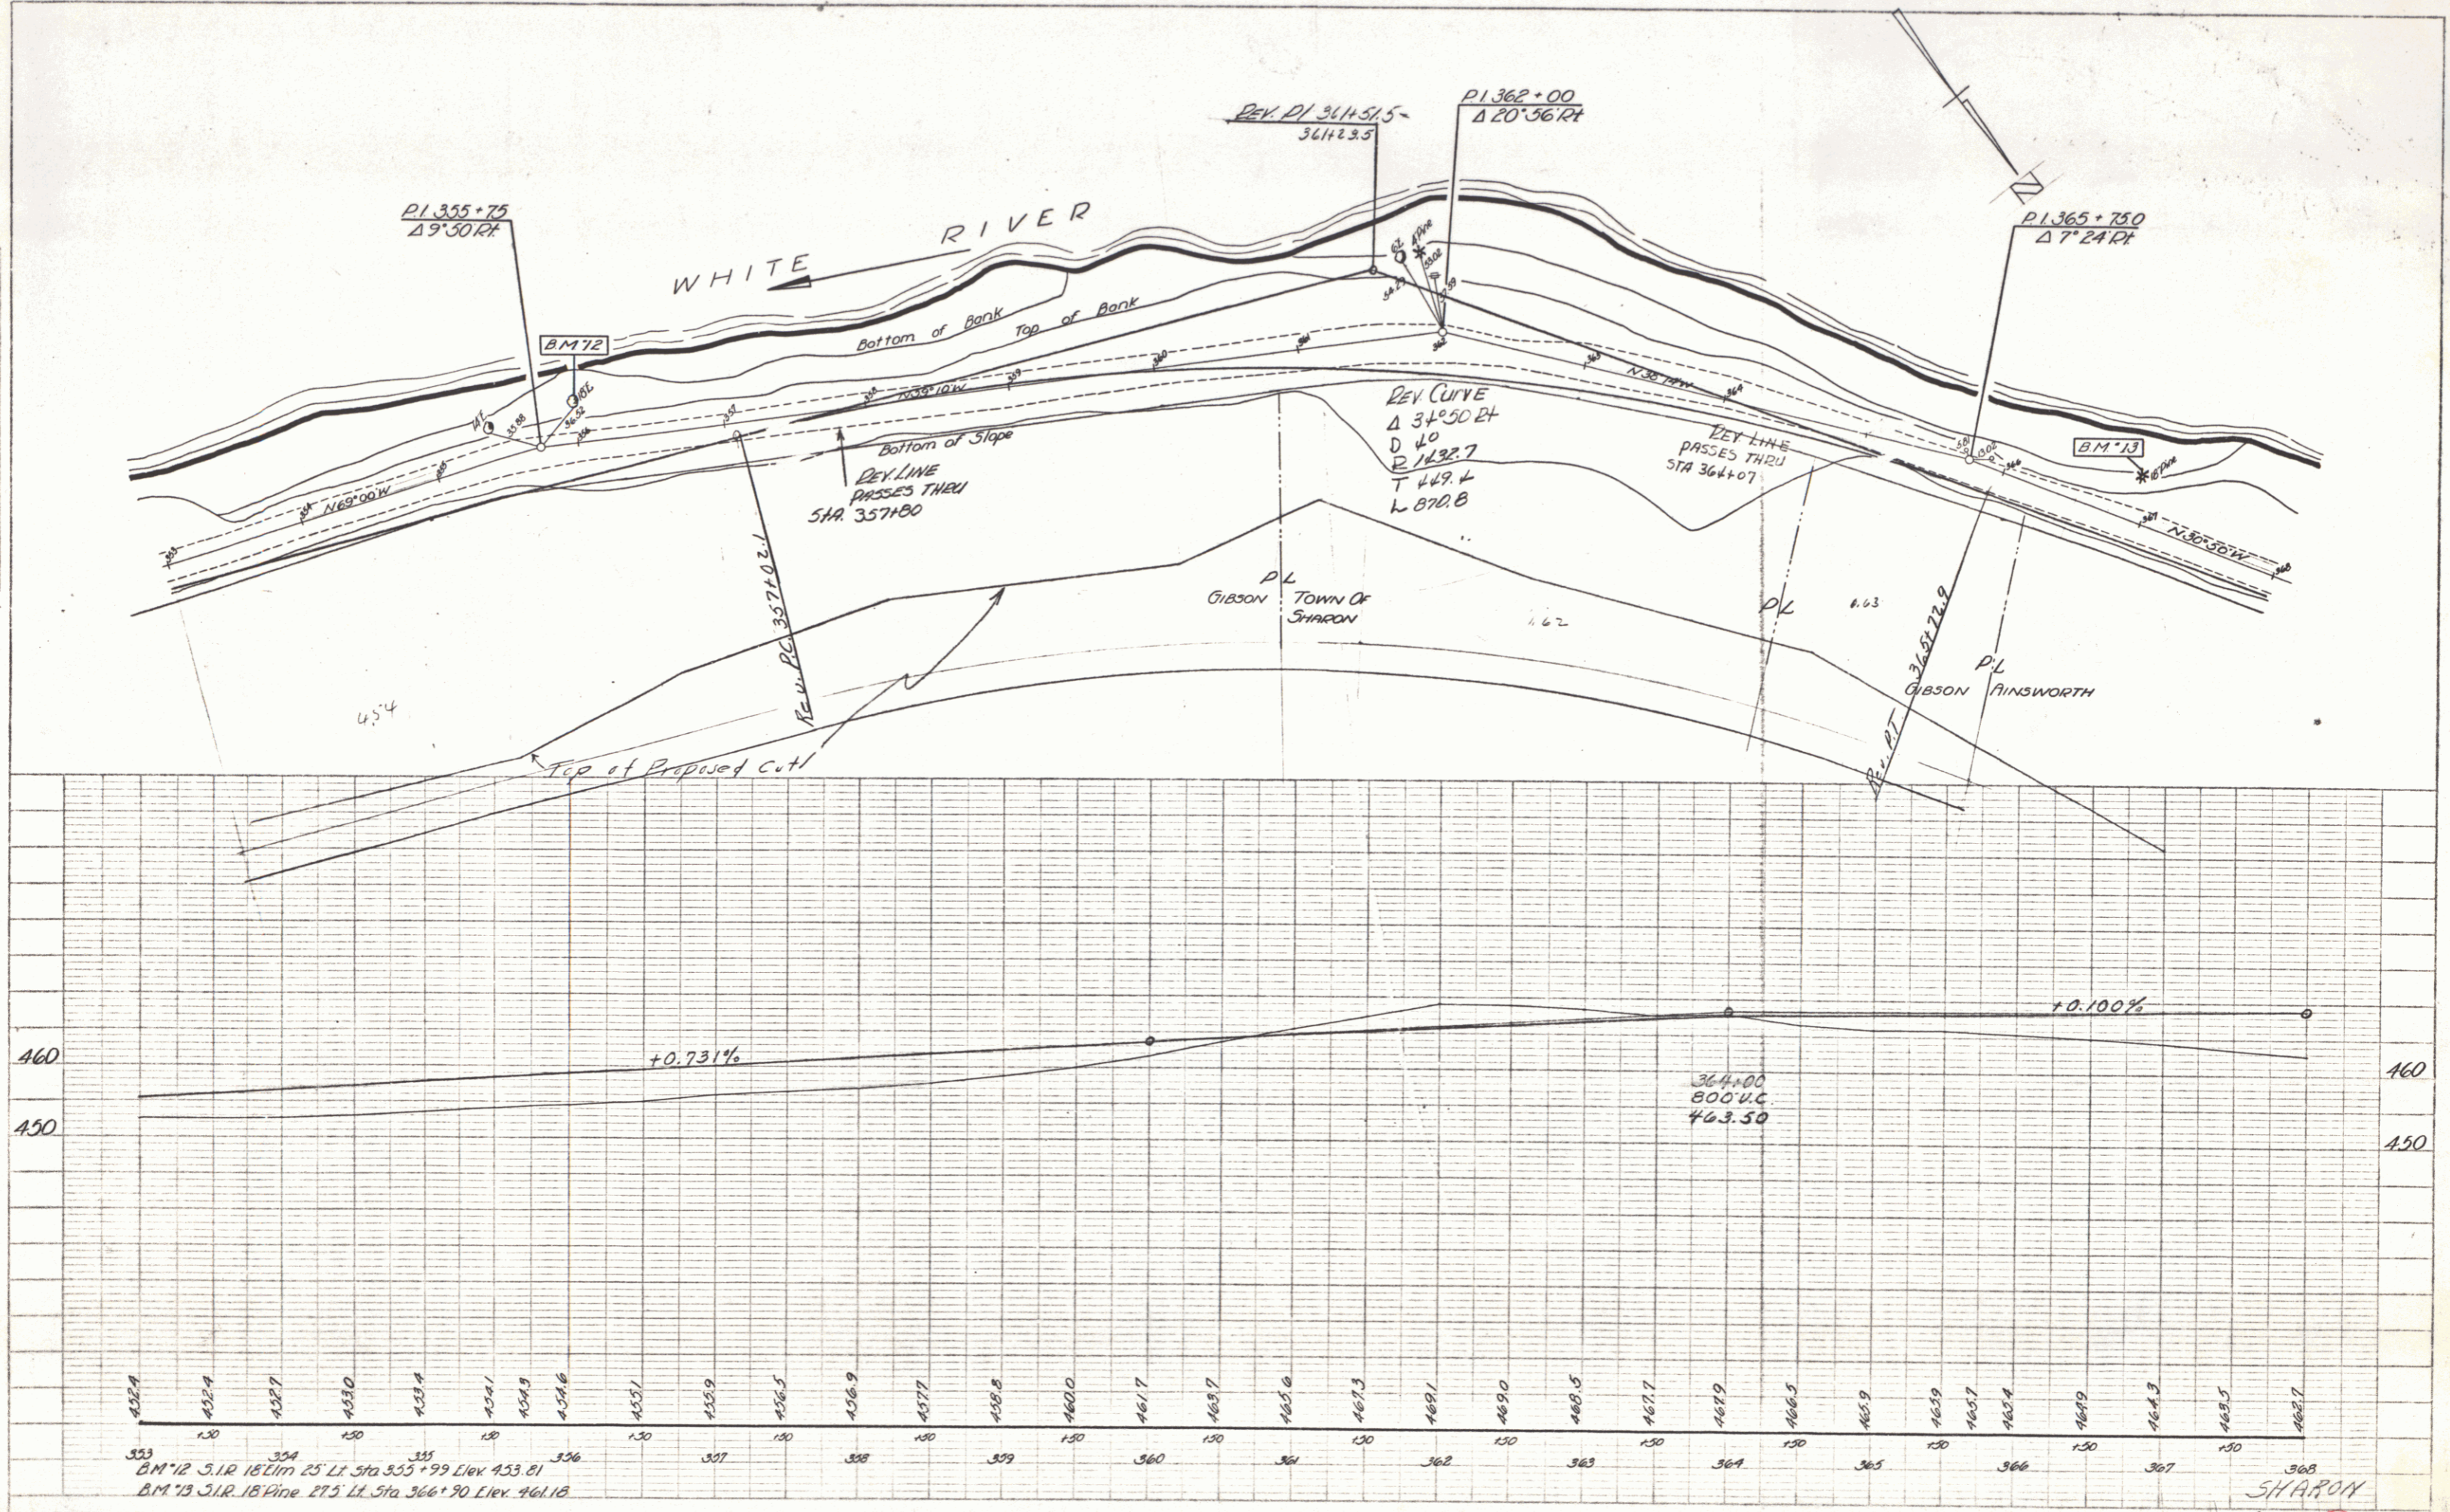



SHARON  
 SHEET 6

3